

**STRUCTURES PRELIMINARY GEOTECHNICAL REPORT**  
**INTERSTATE 80/STATE ROUTE 65**  
**INTERCHANGE IMPROVEMENT PROJECT**  
Placer County, California  
EA 03-4E3200; 03-PLA-80/65-PM 1.9-6.1/ R4.8-R7.3

Prepared by:  
**BLACKBURN CONSULTING**  
Auburn, California

November 2014

Prepared for:  
**CH2M HILL**  
Sacramento, California

West Sacramento Office:  
2491 Boatman Ave. ▪ West Sacramento, CA 95691  
(916) 375-8706 ▪ Fax (916) 375-8709



Main Auburn Office: (530) 887-1494  
Fresno Office: (559) 438-8411  
Modesto Office: (209) 522-6273

Geotechnical ▪ Geo-Environmental ▪ Construction Services ▪ Forensics

File No. 1980.1  
November 20, 2014 (rev 1)

Mr. Christopher Benson  
CH2M Hill  
2485 Natomas Park Drive  
Suite 600  
Sacramento, CA 95833-2937

Subject: **Structures Preliminary Geotechnical Report**  
**Interstate 80/State Route 65 Interchange Improvement Project**  
Placer County, California  
EA 03-4E3200; 03-PLA-80/65  
PM 1.9-6.1/ R4.8-R7.3

Dear Mr. Benson,

Blackburn Consulting (BCI) prepared this Structures Preliminary Geotechnical Report for the Interstate 80 and State Route 65 Interchange improvement project located in Placer County, California.

BCI prepared this report in accordance with the February 2011 Agreement between BCI and CH2M Hill. We submit this draft report for review and comment.

Thank you for the opportunity to be part of your design team. Please call us if you have questions or require additional information.

Sincerely;

**BLACKBURN CONSULTING**

Patrick Fischer, P.E., C.E.G.  
Engineering Geologist, Principal



Rob Pickard, C.E.G.  
Engineering Geologist



**Structures Preliminary Geotechnical Report**  
 Interstate 80 & State Route 65 Interchange Improvement Project  
 Placer County, California  
 EA 03-4E3200; 03-PLA-80/65, PM 1.9–6.1/ R4.8–R7.3

**TABLE OF CONTENTS**

<b>1</b>	<b>INTRODUCTION .....</b>	<b>1</b>
1.1	Purpose .....	1
1.2	Scope of Services .....	1
1.3	Site Location and Description .....	1
<b>2</b>	<b>PROJECT DESCRIPTION .....</b>	<b>2</b>
<b>3</b>	<b>EXCEPTIONS TO POLICY .....</b>	<b>3</b>
<b>4</b>	<b>FIELD INVESTIGATION AND TESTING PROGRAM .....</b>	<b>3</b>
4.1	Subsurface Investigation and Laboratory Testing .....	3
4.2	Site Review and Geologic Mapping.....	3
<b>5</b>	<b>DOCUMENT REVIEW .....</b>	<b>3</b>
<b>6</b>	<b>SITE GEOLOGY AND SUBSURFACE CONDITIONS.....</b>	<b>4</b>
6.1	General Project Area Geology .....	4
6.2	Faulting.....	6
6.3	Subsurface Soil and Rock.....	6
6.4	Groundwater.....	7
<b>7</b>	<b>PRELIMINARY GEOLOGIC HAZARDS AND SEISMIC DATA.....</b>	<b>8</b>
7.1	Geologic Hazards .....	8
7.2	Seismic Data.....	9
7.2.1	<i>Ground Motion</i> .....	9
7.2.2	<i>Liquefaction</i> .....	10
7.2.3	<i>Fault Rupture</i> .....	10
7.2.4	<i>Seismic Settlement</i> .....	10
7.2.5	<i>Seismic Slope Instability</i> .....	10
<b>8</b>	<b>PRELIMINARY GEOTECHNICAL RECOMMENDATIONS .....</b>	<b>10</b>
8.1	Structure Foundations.....	10
8.2	Cuts and Cut-slopes.....	14
8.3	Fill and Fill-slopes.....	14
8.4	Erosion.....	14
8.5	Scour.....	14
<b>9</b>	<b>PRELIMINARY SOIL CORROSION EVALUATION .....</b>	<b>15</b>
<b>10</b>	<b>CONSTRUCTION CONSIDERATIONS .....</b>	<b>16</b>
<b>11</b>	<b>SUBSURFACE EXPLORATION AND LABORATORY TESTING.....</b>	<b>16</b>
<b>12</b>	<b>LIMITATIONS.....</b>	<b>16</b>
<b>13</b>	<b>REFERENCES.....</b>	<b>17</b>

**Structures Preliminary Geotechnical Report**  
Interstate 80 & State Route 65 Interchange Improvement Project  
Placer County, California  
EA 03-4E3200; 03-PLA-80/65, PM 1.9–6.1/ R4.8–R7.3

**TABLE OF CONTENTS (Continued)**

**FIGURES**

- Figure 1 – Vicinity Map
- Figure 2A -2C – Site Map
- Figure 3 – Geologic Map
- Figure 4 – Regional Fault Map
- Figure 5 – Groundwater Elevation Map
- Figure 6a and 6b – Preliminary ARS Response Spectra

**APPENDIX A**

Logs of Test Borings

- Atlantic Street Overcrossing
- Harding Boulevard OC
- Roseville Parkway Overcrossing
- Miners Ravine Bridge (EB off-ramp)
- Miners Ravine Bridge (WB on-ramp)
- Miners Ravine Bridge (Widen)
- Route 65/80 Separation
- East Roseville Viaduct
- Retaining Wall – 39E-41E
- Retaining Wall – 40W-42W
- Retaining Wall – 48W
- Retaining Wall – 49E
- Retaining Wall – 58E
- Retaining Wall – 59W

**APPENDIX B**

- Caltrans Comments and BCI Response

## **1 INTRODUCTION**

### **1.1 Purpose**

CH2M Hill retained Blackburn Consulting (BCI) to prepare this Structures Preliminary Geotechnical Report (SPGR) for the proposed improvements at the Interstate 80 (I-80)/State Route 65 (SR 65) Interchange located in Placer County, California. This report provides preliminary geotechnical/geologic information for advance planning purposes. Additional geotechnical studies are required for design level recommendations.

BCI prepared this SPGR for CH2M Hill for advance planning purposes only. Do not use or rely upon this report for other locations or for final project design.

### **1.2 Scope of Services**

To prepare this report, BCI:

- Discussed the project with the project team
- Reviewed preliminary site plans prepared by the team
- Reviewed published maps and literature related to site soil, rock, and geologic conditions
- Reviewed published geotechnical data and as-built information for existing structures in the project area
- Conducted a preliminary geologic site reconnaissance to confirm reported conditions

### **1.3 Site Location and Description**

The project site is located in the area of the I-80/SR 65 interchange in the Cities of Rocklin and Roseville, Placer County, California. Figure 1 shows the overall project area.

In the project area, I-80 has three to six lanes in each direction and SR 65 is a divided highway with two to three lanes in each direction. The overall project consists of modifications along I-80 from the Douglas Boulevard Interchange to the Rocklin Road Interchange (Post Miles 1.9-6.1), and along SR 65 from the I-80 junction to the Pleasant Grove Boulevard Interchange (Post Miles R4.8-R7.3).

Area topography is characterized by rolling hills with southwest trending ridges and relatively gentle slope gradients. Elevations range from a high of approximately 250 feet along SR 65 to a low of approximately 150 feet at the west end of the project area along I-80. In the project area, I-80 is constructed near natural grade with some cuts through ridges and fills across low lying areas. SR 65 is mostly elevated (by fills and bridges) above natural grade from the interchange area to the northwest side of Antelope Creek (near PM 5.4). Northwest of Antelope Creek to Pleasant Grove Blvd., SR 65 is constructed near natural grade with some cuts and fills.

Several west-southwest flowing creeks are located in and near the project area. The major creeks flowing through this area are:

- Antelope Creek located northwest of I-80 with a crossing beneath SR 65
- Secret Ravine located southeast of I-80
- Miners Ravine located southeast of I-80 with a crossing beneath I-80 west of Eureka Road

These creeks (and their ancestral equivalents) have created a low southwest trending valley in the project area along which I-80 is constructed. Storm drainage at I-80 and SR 65 is directed through roadside ditches that flow to the local drainages.

## **2 PROJECT DESCRIPTION**

Three “Build” alternatives are proposed (after the screening process) for the project and are as follows:

- Alternative 1 – Taylor Road Full Access Interchange
- Alternative 2 – Collector-Distributor System Ramps
- Alternative 3 – Taylor Road Interchange Eliminated

The alternatives propose to add capacity, a bi-directional HOV system, and high-speed connections. Local and regional circulation and access would be improved along I-80 between Eureka Road/Atlantic Street, Taylor Road, and along SR 65 between the I-80/SR 65 Interchange and Pleasant Grove Boulevard.

This SPGR focuses on preliminary geotechnical information for new structures included under all three “Build” alternatives. Figures 2A through 2C (Alternatives 1, 2, and 3) show the preliminary configuration of interchange modifications and proposed structure locations based on preliminary Planning Study maps (CH2M Hill, 2014) . The proposed structures are:

### **Structures Common to Alternatives 1 through 3**

- East I-80/North SR 65 Connector
- I-80/SR 65 HOV Connector
- South SR 65/East I-80 Connector
- Taylor Road Overcrossing (Replace)
- East Roseville Viaduct Widening (two structures)Roseville Parkway Tieback Wall
- Galleria Boulevard Tieback Wall

### **Structures Common to Alternative 2 and 3**

- Collector-Distributor (CD), Northbound SR 65 On-Ramp
- Collector-Distributor (CD), Eastbound I-80 On-Ramp

**Structures in Alternative 1 Only**

- T –Undercrossing at Eastbound/Westbound 80 (two structures)
- South SR 65/West I-80 Connector

**Structures in Alternative 2 Only**

- Miners Ravine Bridge
- Eureka Road On-Ramp Undercrossing (cut and cover tunnel)

**Structures in Alternative 3 Only**

- Miners Ravine Eastbound Off-Ramp Widening

**3 EXCEPTIONS TO POLICY**

No exceptions to Caltrans departmental policy are included for this SPGR.

**4 FIELD INVESTIGATION AND TESTING PROGRAM**

**4.1 Subsurface Investigation and Laboratory Testing**

New subsurface investigation and laboratory testing was not completed for this SPGR. Subsurface data obtained for existing structures was used to evaluate site conditions within the project area. See Appendix A for copies of the Logs of Test Borings (LOTB's) used in our review.

**4.2 Site Review and Geologic Mapping**

BCI completed a site reconnaissance to observe the site and confirm published geologic conditions. A discussion of area geology is included below.

**5 DOCUMENT REVIEW**

For preliminary evaluation of site subsurface conditions, our review included the following documents:

- Log of Test Borings, Atlantic Street Overcrossing, Caltrans, As-Built, 12/29/1989, Sheets 18 and 19 of 19
- Log of Test Borings, Harding Boulevard Overcrossing (Galleria Blvd.), CH2M Hill, As-Built, 10/17/1988, Sheet 12 of 12
- Log of Test Borings, Roseville Parkway Overcrossing, Kleinfelder Inc., As-Built, 11/10/2000, Sheets 47 to 51 of 51
- Memorandum, Foundation Investigation, Taylor Road Overcrossing, Caltrans, 11/20/1986

**STRUCTURES PRELIMINARY GEOTECHNICAL REPORT**

*Interstate 80 & State Route 65 Interchange Improvement Project*

*Placer County, California, EA 03-4E3200; 03-PLA-80/6, PM 1.9-6.1/R4.8-R7.3*

*BCI Job. No. 1980.1*

*November 20, 2014 (rev 1)*

- Log of Test Borings, Miners Ravine Bridge (EB off-ramp), Caltrans, As-Built, 12/29/1989, Sheets 13 and 14 of 14
- Log of Test Borings, Miners Ravine Bridge (WB on-ramp), Caltrans, As-Built, 12/29/1989, Sheets 10 to 12 of 12
- Log of Test Borings, Miners Ravine Bridge (Widen), Kleinfelder, Inc., 11/17/2008, Sheets 477 to 481 of 539
- Log Borings, Roseville 150 Joint Venture, Road “E” & Antelope Creek Bridge, Roseville 150 Center, The Spink Corporation (Logs by Wallace Kuhl & Associates Inc.), 1995, Sheet 17 of 17
- Memorandum, Route 65/80 Separation Foundation Recommendations, Caltrans, 3/21/1984
- Highway 65 and I-80, Site Exploration Results, Anderson Geotechnical Consultants, Inc., 11/29/1984
- Log of Test Borings, Route 65/80 Separation, Caltrans, As-Built, 10/6/1987, Sheet 14 of 14
- Log of Test Borings, East Roseville Viaduct, Caltrans, As-Built, 8/6/1987, Sheet 173 to 175 of 175
- Log of Test Borings, Retaining Wall – 39E-41E, Kleinfelder, Inc., 12/2006, Sheet 24 to 29 of 29
- Log of Test Borings, Retaining Wall – 40W-42W, Kleinfelder, Inc., 12/2006, Sheet 23 to 29 of 29
- Log of Test Borings, Retaining Wall – 48W, Kleinfelder, Inc., 11/2008, Sheet 11 to 14 of 14
- Log of Test Borings, Retaining Wall – 49E, Kleinfelder, Inc., 9/2008, Sheet 11 to 14 of 14
- Log of Test Borings, Retaining Wall – 58E, Kleinfelder, Inc., 9/2008, Sheet 11 to 14 of 14
- Log of Test Borings, Retaining Wall – 59W, Kleinfelder, Inc., 11/2008, Sheet 10 to 13 of 13

Appendix A contains copies of the applicable Logs of Test Borings (LOTB’s) sheets from the above references.

## **6 SITE GEOLOGY AND SUBSURFACE CONDITIONS**

### **6.1 General Project Area Geology**

The project area lies on the eastern margin of the Great Valley Geomorphic Province (Sacramento Valley portion). The Great Valley is bordered by the Cascade and Klamath Ranges to the north, the Coast Ranges to the west, and the Sierra Nevada to the east. The valley was



formed by tilting of the Sierran Block with the western side dropping to form the valley and the eastern side uplifted to form the Sierra Nevada. The western slope of the Sierra Nevada is underlain by intrusive, volcanic, and metamorphic rock. Valley deposits are characterized by a thick sequence of alluvial, lacustrine, and marine sediments. The thickness of the sediments varies from a thin veneer at the valley margin, to thousands of feet in the central portion. In the project area, granitic rock and volcanic deposits occur along the valley margin.

Based on review of published geologic maps (Livingston, 1974, Wagner et al, 1981; Loyd, 1995, Mulder, 2007), our site review, and available subsurface information, the project area is underlain by the following:

#### Granitic Rock

Granitic rock in the project area is known as the Rocklin Pluton; it is comprised of quartz diorite and is deeply weathered (decomposed) in many areas. Within the project area, granitic rock occurs immediately west of the Rocklin Road Interchange. The rock is typically decomposed to intensely weathered within approximately 5 to 10 feet of the surface with isolated “boulders” (or bodies) of moderately to slightly weathered, hard rock. Figure 3 shows mapped locations of granitic rock as “Mzg”.

#### Mehrten Formation

Deposits of the Mehrten Formation in the project area consist primarily of andesitic, volcanic mudflow breccia, and cobble conglomerate. This formation is likely to be encountered along I-80 between Eureka Road and Douglas Blvd., within the eastern portion of the I-80/SR 65 interchange, and northwest of Antelope Creek along SR 65. The breccia consists of a gray mixture of gravel to boulder size, angular, andesitic fragments. These fragments are well cemented in a matrix of volcanic lapilli and ash (tuff). The conglomerate consists primarily of cobbles in a well-cemented matrix of andesitic sand and silt, and often contains interbedded layers of sandstone, siltstone, and lenses of mudflow breccia. In the project area, the lowest portions of the Mehrten Formation are often underlain by claystones possibly associated with the Valley Springs or Ione Formations. Bedding of sediments and flows within the Mehrten Formation typically dip gently (2 to 4 degrees) to the west/southwest. These volcanic materials were deposited during Miocene time (5 to 20 million years ago). Figure 3 shows mapped locations of the Mehrten Formation as “Tva”.

#### Riverbank and Turlock Lake Formations

Sediments of the Riverbank and Turlock Lake Formation occur in the central portion of the project area. These are alluvial deposits that are typically composed of interbedded medium dense to dense sands (often cemented) and gravels, and stiff to hard silts and clays. Bedding is typically horizontal, lenticular, and discontinuous. These sediments are Late to Middle Pleistocene age (deposited over 150,000 years ago). Figure 3 shows mapped locations of the Riverbank and Turlock Lake Formations as “Qa”.

#### Other Geologic Units

Several shallow waterways cross the project area (including Secret Ravine, Miners Ravine, and Antelope Creek) and we expect these waterways will contain a certain thickness of young alluvial

deposits. This includes alluvial deposits at the banks (stream terrace deposits) as well as active channel deposits. Alluvium likely consists of several feet of loose sand and gravel with some cobbles and boulders.

Highway embankment fill is also present at a number of locations along the project corridor. We expect embankment fill to be engineered fill, placed in accordance with Caltrans specifications, that consists of locally derived clay, silt, sand, and gravel with occasional boulders (from the Mehrten Formation).

### 6.2 Faulting

Faulting is not identified within or adjacent to the site. Based on the Caltrans ARS Online (V2.3.06), the closest seismic source is a portion of the Foothills Fault System (Deadman Fault) located approximately 9 miles (14.8 km) to the east. Figure 4 shows general fault locations in the region.

### 6.3 Subsurface Soil and Rock

Table 1 below summarizes the expected soil and rock conditions for various portions of the project. The descriptions are based on mapped geologic conditions, subsurface data made available for the project area, and our site reconnaissance.

<b>TABLE 1 – PRELIMINARY SUBSURFACE CONDITIONS</b>		
<b>General Project Area</b>	<b>Planned Structures in Area</b>	<b>General Soil and Rock Conditions</b>
East End, I-80 Between South SR 65/East I-80 Connector and Rocklin Road; Approximate PM 4.7 to 6.1	<ul style="list-style-type: none"><li>• No new bridge structures are planned in this area</li><li>• Retaining walls along eastbound I-80</li></ul>	Underlain by granitic rock that transitions to andesitic volcanic deposits and alluvial deposits at the west end. Very stiff/dense silt and sand associated with weathered granitic rock and alluvial deposits are anticipated. Isolated occurrence of shallow, hard, granitic rock can occur. Moderately hard sandstone and conglomerate associated with andesitic volcanics are anticipated at the west end of this area.
South Interchange Area, I-80 between South SR 65/East I-80 Connector Ramp and South SR 65/West I-80 Connector Ramp; Approximate PM 4.1 to 4.7	<ul style="list-style-type: none"><li>• E80/N65 Connector</li><li>• 80/65 HOV Connector</li><li>• S65/E80 Connector</li><li>• T –Undercrossing at EB/WB 80</li><li>• CD EB80 On-Ramp</li><li>• CD NB65 On-Ramp</li></ul>	Transition area between engineered fill placed for ramps and abutments, andesitic volcanics that consist of moderately hard breccia and sandstone, and alluvium that consists of medium dense to dense sands, and hard silts and clays.

<b>TABLE 1 – PRELIMINARY SUBSURFACE CONDITIONS</b>		
<b>General Project Area</b>	<b>Planned Structures in Area</b>	<b>General Soil and Rock Conditions</b>
Northwest End, SR 65 between 80/65 Connector and northwest end of East Roseville Viaduct; Approximate PM R5.1 to R5.4	<ul style="list-style-type: none"> <li>• East Roseville Viaduct Widening</li> </ul>	Underlain by alluvial deposits that typically consist of dense sands and very stiff to hard silts and clays. At the northwest end of this area (northwest side of Antelope Creek), there is a transition to andesitic volcanics that consist of moderately hard, breccia and sandstone. Significant depth of engineered fill is present at the south viaduct abutment.
Northwest End, SR 65 between East Roseville Viaduct and Stanford Ranch Road; Approximate PM R5.4 to R5.9	<ul style="list-style-type: none"> <li>• Galleria Blvd Tieback Wall</li> </ul>	Underlain by andesitic volcanic deposits. Moderately hard breccia, sandstone and conglomerate are anticipated at shallow depths.
West End, I-80 between South SR 65/West I-80 Connector and Miners Ravine; Approximate PM 2.9 to 4.1	<ul style="list-style-type: none"> <li>• S65/W80 Connector</li> <li>• 80/65 HOV Connector</li> <li>• Taylor Road Overcrossing (Replace)</li> <li>• Roseville Parkway Tieback Wall</li> <li>• Eureka Road On-Ramp UC</li> <li>• Miners Ravine EB Off-Ramp Widening</li> <li>• Miners Ravine Bridge</li> </ul>	Underlain by alluvial deposits that typically consist of medium dense to dense sands and very stiff to hard silts and clays. At the east and west ends of this area, andesitic volcanics that consist of breccia, conglomerate, sandstone, and siltstone are present at the surface and at relatively shallow depths below alluvial deposits. Significant depths of engineered fill are present at existing ramps and abutments.
West End, I-80 between Miners Ravine and Douglas Blvd.; Approximate PM 1.9 to 2.9	No new bridge structures are planned in this area	Underlain by andesitic volcanic deposits. Moderately hard breccia, sandstone and conglomerate are anticipated very shallow depths. The west end, near Douglas Blvd, transitions to alluvial deposits expected to consist of medium dense to dense sands and very stiff to hard silts and clays.

**6.4 Groundwater**

The depth to groundwater beneath the project area is variable due to:

- Significant changes in ground surface elevation
- The presence of alluvial sediments that extend through the central portion of the area
- Relatively hard, well consolidated sediments and hard rock on the project perimeter
- Presence of several creek beds

Regionally, MWH (2007) shows groundwater elevation ranging from approximately 45 feet above mean sea level (msl) at the west end of the project to approximately 65 feet at the east end. Figure 5 is a portion of the MWH (2007) groundwater elevation map. Based on this map, regional groundwater levels are generally greater than 100 feet below the ground surface and the gradient is to the west-southwest.

While the groundwater mapping provides the approximate elevation of the deeper/regional groundwater conditions, perched groundwater that can impact project design and construction may occur much shallower. In general, groundwater should be expected near the elevation of water in the adjacent creek beds such as Secret Ravine, Miners Ravine, and Antelope Creek. Existing subsurface data that we reviewed indicates shallow groundwater occurrence at the locations and elevations shown in Table 2.

<b>TABLE 2 – SUMMARY OF SHALLOW GROUNDWATER OCCURRENCE</b>				
<b>General Location</b>	<b>Approximate Depth to Groundwater (ft)</b>	<b>Approximate Groundwater Elevation (ft)</b>	<b>Reference Used</b>	<b>Notes</b>
West end (Miners Ravine)	2 to 5 feet	151	Topographic map and Miners Ravine Bridge LOTB (1989)	At Miners Ravine
West end (Atlantic St)	15	165	Atlantic St. OC LOTB (1988)	
West End (Roseville Pkwy)	17 to 20	154 – 185	Roseville Pkwy OC LOTB (1998)	Groundwater elevation increases to the southeast
West Central (Taylor Road)	29	171	Taylor Road OC, Foundation Investigation (1986)	
Central (65/80 Separation)	<0.5 – 25	193 to 207	Route 65/80 Separation LOTB (1984)	Shallow water appears to be a localized condition
East Central	10 – 25	200	Topographic map	Adjacent to Secret Ravine
Northwest (East Roseville Viaduct)	12 – 14	199 – 202	East Roseville Viaduct LOTB (1984)	Near Taylor Road
Northwest (East Roseville Viaduct)	<0.5 – 9	169 -175	East Roseville Viaduct LOTB (1984)	Near Antelope Creek

## **7 PRELIMINARY GEOLOGIC HAZARDS AND SEISMIC DATA**

### **7.1 Geologic Hazards**

Available site information and our site review did not indicate significant geologic hazards (such as landsliding, ground settlement, very soft soils, severe erosion, etc) within the project area. There is a potential for weak claystones to occur near the base of the Mehrten Formation (area labeled as “Tva” on Figure 3), particularly at the eastern portion of the I-80/SR 65 interchange; the claystone can impact slope stability and design parameters for new structures.

**7.2 Seismic Data**

7.2.1 Ground Motion

The project area is subject to ground motions from a seismic event. BCI used seismic design procedures outlined by Caltrans ‘Geotechnical Services Manual’ to develop the preliminary Acceleration Response Spectrum (ARS) Curve for preliminary design of new bridge structures. We summarize the data in Table 3. Figure 6a shows a graphical display of the Preliminary Design Response Spectrum. Figure 6b shows tabled spectrum data.

<b>TABLE 3 – PRELIMINARY GROUND MOTION STUDY RESULTS</b>	
Peak Ground Acceleration (PGA)	0.21g
$V_{S30}$ (Small Strain Shear Wave Velocity) <sup>1</sup>	1,800 feet per second (560 m/s)
Near Fault Factor	Yes
Basin Amplification Factor	NA
Controlling Deterministic Scenario	Minimum Deterministic: <ul style="list-style-type: none"> <li>➤ Style: Vertical strike-slip</li> <li>➤ Maximum Magnitude (Mmax): 6.5</li> <li>➤ Site to fault distance (<math>R_{RUP}</math>)<sup>2</sup>: 7.5 mi</li> </ul>
Nearest Late Quaternary Fault	Foothills Fault System – Deadman Fault <ul style="list-style-type: none"> <li>➤ Fault ID Number: 422</li> <li>➤ Style: Normal</li> <li>➤ Dip: 50 degrees, West</li> <li>➤ Maximum Magnitude (Mmax): 6.2</li> <li>➤ Site-to-Fault Distance (<math>R_{RUP}</math>)<sup>2</sup>: 9 miles/14.8 km (from central portion of interchange)</li> </ul>
<b>RECOMMENDED PRELIMINARY DESIGN RESPONSE SPECTRUM</b>	Envelope that consists of the minimum deterministic spectrum and the probabilistic spectrum (probability of exceedance equal to 5% in 50 years, a 975-year return period). <ul style="list-style-type: none"> <li>➤ ARS Response Spectra - See Figure 6a/6b</li> <li>➤ PGA = 0.21g (based on minimum deterministic spectrum)</li> <li>➤ Mmax = 6.5</li> </ul>

1) Preliminary  $V_{S30}$  value based on Soil Profile Type C (very dense soil and soft rock) present throughout the project area

2)  $R_{RUP}$  is defined as the closest distance to the fault rupture plane (as defined in Caltrans’ “Methodology for Developing Design Response Spectrum for Use in Seismic Design Recommendations,” Appendix B, November 2012)

The information provided in Table 3 and the Preliminary Design Response Spectrum will need to be updated for final design. Each structure needs to be analyzed separately and ARS developed based on site specific data (such as  $V_{S30}$ ).

### 7.2.2 Liquefaction

Liquefaction can occur when saturated, loose to medium dense, granular soils (generally within 50 feet of the surface), or specifically defined cohesive soils, are subjected to ground shaking. According to our document and site review, non-liquefiable soils (medium dense to very dense granular soils, very stiff to hard, cohesive soils, and/or soft rock) are present at relatively shallow depths at planned structure locations. We consider the potential for detrimental liquefaction to be low at planned structure locations throughout the project.

### 7.2.3 Fault Rupture

Faulting is not mapped through the site, and the site does not lie within or adjacent to a Fault Rupture Hazard Zone (Bryant and Hart, 2007). Based on the Caltrans ARS Online (V2.3.06), the closest seismic source is a portion of the Foothills Fault System (Deadman Fault) located approximately 9 miles (14.8 km) to the east. We consider the potential for fault rupture within the project area to be very low. Figure 4 shows the general fault locations in the region.

### 7.2.4 Seismic Settlement

During a seismic event, ground shaking can cause densification of granular soil above the water table that can result in settlement of the ground surface. Based on our review, medium dense to dense soils and/or rock is present at relatively shallow depths throughout the project area and probable ground motions are relatively low (Peak Ground Acceleration of 0.21g). We consider the potential for detrimental seismic settlement within the project area to be low for native soil/rock and engineered fill, provided engineered fills are constructed in accordance with Caltrans guidelines.

### 7.2.5 Seismic Slope Instability

Based on geologic conditions and past performance, we consider the potential for seismic slope instability in the form of landslides and mudslides within the project area to be very low. Similarly, we consider the potential for seismic instability of engineered cut or fill slopes constructed at typical allowable gradients of (2.1H:1V or flatter) to be low. An exception to this may be at cut slopes and/or structure locations at the base of the Mehrten Formation (area labeled as "Tva" on Figure 3) where there is a potential for weak claystones to occur (particularly at the eastern portion of the I-80/SR 65 interchange).

## **8 PRELIMINARY GEOTECHNICAL RECOMMENDATIONS**

### **8.1 Structure Foundations**

Variable soil and groundwater conditions in the project area make different foundation types better suited for each structure location. Table 4 below summarizes the suitable foundation types anticipated for each planned structure location (based on the preliminary Planning Study by CH2M Hill dated 7/24/14). Subsurface investigation will need to be completed to verify suitable foundation types and provide final design parameters.

**STRUCTURES PRELIMINARY GEOTECHNICAL REPORT**

Interstate 80 & State Route 65 Interchange Improvement Project

Placer County, California, EA 03-4E3200; 03-PLA-80/6, PM 1.9-6.1/R4.8-R7.3

BCI Job. No. 1980.1

November 20, 2014 (rev 1)

**TABLE 4 - PRELIMINARY STRUCTURE FOUNDATION TYPES**

<b>Structure (Alternate)</b>	<b>Existing Foundation Reference Data</b>	<b>Foundation Geology and Expected Soil Conditions</b>	<b>Suitable Foundation Types Anticipated</b>	<b>Installation Notes</b>
<b>E80/N65 Connector</b> (1, 2, and 3)	Located west of the S65/E80 Connector bridge which is the closest existing structure and supported on CIDH (Abut 1) and H-Piles (Abut 3, N end) with spread footing at Bent 2.	Dense silt and sand of the Turlock and/or Riverbank Formations) on north end and embankment fill over Turlock and/or Mehrten Formations at southwest end.	Driven H-piles for Abutment 1 through Bent 2, and Bent 6 through Abutment 11 (or through Abutment 13 for Alt. 2 and 3). Spread footings for Bent 3 through 5 (or Bent 4 through 6 for Alt. 2 and 3). CIDH are possible option at all locations. Large diameter shaft is feasible in median and adjacent to I-80.	CIDH may require temporary casing due to existing fill, and loose surface soil and groundwater near Secret Ravine.
<b>80/65 HOV Connector</b> (1, 2, and 3)	Located west of the S65/E80 connector bridge which has H-Piles (Abut 3 – N end) with spread footing at Bent 2.	Dense silt and sand of the Riverbank and/or Turlock Formations, with some Mehrten (sandstone/siltstone) possible (below embankment fill) at depth at the west end.	Driven H-piles and CIDH are possible options for Abutment 1 through Bent 5. Driven H-piles, spread footings and CIDH are possible options at Bent 6 through Abutment 10. Large diameter shaft is feasible in median and adjacent to I-80. MSE wall is suitable at approaches.	Temporary casing may be necessary for installation of large diameter shaft or CIDH due to existing fill depths.
<b>S65/E80 Connector</b> (1, 2, and 3)	The east end of this structure will be close to the existing S65/E80 Separation which is supported on a mix of CIDH, Spread and H-Piles.	Dense silt and sand (likely Turlock Formation) on north end and fill over Mehrten (likely conglomerate) at south-southeast end. Possible embankment fill placed over granitic rock at the far east end.	Driven H-piles or spread footings are possible options at the north end (to Bent 8). Large diameter shaft feasible in median. Spread footings likely best option from Bent 9 to Abutment 19 (Abut 17 for Alt 2 and 3). CIDH is an option at all locations.	
<b>S65/W80 Connector</b> (1 only)	Located south of E. Roseville Viaduct. Should be similar to the conditions for the 65/Taylor Road Undercrossing at the viaduct which has H-Piles.	Medium dense to dense, silty sand underlain by hard silt and clay of the Turlock and/or Riverbank Formations.	Driven H-Piles. Spread footings and CIDH are possible options (particularly at Abutment 2 where original ground is higher).	
<b>CD NB65 On-Ramp</b> (2 and 3)	Located west of the S65/E80 Connector Bridge and east of Taylor Road OC (south of I-80 EB). These bridges are supported on CIDH, H-Piles, and spread footings.	Dense silt and sand of the Turlock and/or Riverbank Formation. Mehrten (sandstone/siltstone) possible at depth.	Driven H-Piles, spread footings and CIDH are possible options.	

**STRUCTURES PRELIMINARY GEOTECHNICAL REPORT**

Interstate 80 & State Route 65 Interchange Improvement Project

Placer County, California, EA 03-4E3200; 03-PLA-80/6, PM 1.9-6.1/R4.8-R7.3

BCI Job. No. 1980.1

November 20, 2014 (rev 1)

**TABLE 4 - PRELIMINARY STRUCTURE FOUNDATION TYPES**

<b>Structure (Alternate)</b>	<b>Existing Foundation Reference Data</b>	<b>Foundation Geology and Expected Soil Conditions</b>	<b>Suitable Foundation Types Anticipated</b>	<b>Installation Notes</b>
<b>CD EB80 On-Ramp (2 and 3)</b>	Located west of the S65/E80 Connector Bridge and east of Taylor Road OC (south of I-80 EB). These bridges are supported on CIDH, H-Piles, and spread footings.	Dense silt and sand of the Turlock and/or Riverbank Formation. Mehrten (sandstone/siltstone) possible at depth at west end, and expected to be shallow at the east end.	Driven H-piles for Abutment 1 through Bent 3. Spread footing for Bent 4 through Abutment 8. CIDH are possible option at all locations. MSE wall is suitable at the west and east ends.	CIDH may require temporary casing due to existing loose surface soil and groundwater near Secret Ravine.
<b>T -Undercrossing at EB/WB 80 (1 only)</b>	At and west of the S65/E80 Connector bridge which is supported on CIDH (Abut 1) and H-Piles (Abut 3, N end) with spread footing at Bent 2.	Transition area between breccia/sandstone of the Mehrten Formation, and dense sands/hard silts of Turlock or Riverbank Formations.	Spread footings or CIDH are possible options.	
<b>Taylor Road Overcrossing (Replace) (1, 2, and 3)</b>	Located west of the existing Taylor Overcrossing which is supported on H-Piles.	Medium dense to very dense and hard, interbedded, silt, sand, and gravel with clay, Riverbank Formation	Driven H-Piles or Concrete Piles. CIDH and spread footings are possible options. Large diameter shaft is feasible in median.	
<b>E. Roseville Viaduct Widening (1, 2, and 3)</b>	Located adjacent to existing viaduct which is supported on H-Piles and spread footings.	Predominately dense sands and hard clays of the Riverbank and Turlock Formations	Driven H-Piles and spread footings – preliminary plans should match the existing foundation types. CIDH is an option at all support locations.	CIDH may require temporary casing (10-20ft) at abutment fill (Abut 1) and isolated Bent locations due to groundwater and loose, upper soils (such as at Bents 2, 3, 6, 9 and 10)
<b>Eureka Road On-Ramp Overcrossing (2 only)</b>	Located adjacent/behind Abutment 3 (east) of the Atlantic St OC. Abutment 3 is supported on driven piles with base of cap at elevation 189.00 to 189.75	Engineered fill at approach/abutment on the order of 26 feet in depth (down to near elevation 180 ft). Underlain by medium dense to dense silty sand with gravel and sandy gravel of the Riverbank Formation and breccia of the Mehrten Formation at greater depth.	Suitable for strip footing support of cut and cover tunnel walls.	Excavations and foundation placement will need to consider the presence of adjacent piles. Lateral loading from abutments will need to be considered for adjacent tunnel wall.
<b>Miners Ravine Bridge (2 only)</b>	Between the existing eastbound Miners Ravine Bridge and eastbound off-ramp bridge. These bridges are supported on a combination of driven H-Piles, CIDH, and spread footings.	Engineered fill adjacent to existing approach/abutment for Miners Ravine Bridge (I-80). Underlain by medium dense to dense silty sand with gravel and sandy gravel of the Riverbank Formation and sandstone/breccia of the Mehrten Formation at greater depth.	Driven H-Piles at abutments and CIDH at bents – preliminary plans should match the existing bridge foundation types for the I-80 EB Miners Ravine Bridge (Widen). CIDH is an option at the abutments.	CIDH may require temporary casing due to presence of fill, loose surface soils, and groundwater.



**STRUCTURES PRELIMINARY GEOTECHNICAL REPORT**

Interstate 80 & State Route 65 Interchange Improvement Project  
 Placer County, California, EA 03-4E3200; 03-PLA-80/6, PM 1.9-6.1/R4.8-R7.3

BCI Job. No. 1980.1  
 November 20, 2014 (rev 1)

**TABLE 4 - PRELIMINARY STRUCTURE FOUNDATION TYPES**

<b>Structure (Alternate)</b>	<b>Existing Foundation Reference Data</b>	<b>Foundation Geology and Expected Soil Conditions</b>	<b>Suitable Foundation Types Anticipated</b>	<b>Installation Notes</b>
<b>Miners Ravine EB Off-Ramp Widening</b> (3 only)	Adjacent to the existing Miners Ravine EB Off-Ramp Bridge which is supported on driven H-Piles at abutments and spread footings at bents. Spread footings at bents are deep (16 to 26 feet).	Engineered fill at abutments, medium dense to dense sand and very stiff to hard silt of the Riverbank Formation overlying breccia, conglomerate, sandstone, and siltstone of the Mehrten Formation.	Driven H-Piles at abutments and spread footings at bents – preliminary plans should match the existing bridge foundation types. CIDH is an option at abutments and bents.	CIDH may require temporary casing due to presence of fill, loose surface soils, and groundwater. Deep spread footings at existing bridge will require significant excavation.
<b>Roseville Parkway Tieback Wall</b> (1, 2, and 3)	Located beneath the Roseville Parkway OC at east abutment.	Engineered fill at abutment slope with dense, clayey sand of the Riverbank Formation behind the slope.	Tieback wall is appropriate at this location.	
<b>Galleria Blvd Tieback Wall</b> (1, 2, and 3)	Located beneath Galleria Blvd OC (old Harding Blvd OC) at east abutment	Engineered fill at abutments and approach overlying breccia, conglomerate and sandstone of the Mehrten Formation.	Tieback wall is appropriate at this location.	Increased tieback length/depth due to presence of approximately 30 ft. of engineered fill.

## **8.2 Cuts and Cut-slopes**

Most cuts and cut slopes are expected to occur within engineered fill placed for existing improvements, and within older alluvial sediments that consist of medium dense to dense, silty sands and hard silts and clays. We expect that cut-slopes will be stable at slopes of 2H:1V or flatter within native soils and engineered fills.

Moderately hard rock can be encountered near the surface where underlain by andesitic volcanics (labeled as “Tva” on Figure 3) or granitic rock (“Mzg” on Figure 3). Granitic rock in the eastern portion of the project area is typically deeply weathered and excavatable with isolated, hard knobs that may require blasting and/or drilling/splitting to aid in removal.

Volcanic mudflow breccia, associated with the andesitic volcanics, can be difficult to excavate but is typically rippable with heavy equipment. Oversize material (boulders) can be generated. The breccia is likely to be encountered along I-80 between Eureka Road and Douglas Blvd. and northwest of Antelope Creek along SR 65. For preliminary excavation considerations, minimize cut depth in the areas labeled as “Tva” and “Mzg” on Figure 3.

## **8.3 Fill and Fill-slopes**

We did not identify areas of potentially soft/compressible soils within the existing subsurface information or during our site reconnaissance for those areas that are likely to have significant, engineered fills constructed. We anticipate that settlement of engineered fill established on appropriately prepared subgrade will be minimal and occur primarily during fill placement. Long settlement waiting periods are not expected. We expect engineered fill slopes constructed of local materials will be stable at gradients of 2H:1V or flatter. A slope gradient of 1.5H:1V can be used in front of abutments. Consider the use of slope paving where abutment slopes have a gradient steeper than 2H:1V; slope paving is used to minimize erosion and slope maintenance.

## **8.4 Erosion**

Embankment slopes and areas disrupted by grading are susceptible to erosion from surface runoff. Cut and fill slopes will require erosion control, such as vegetation, and control of surface runoff. Cuts within the andesitic volcanics and granitic rock will be less susceptible to erosion and likely not suitable for planting.

## **8.5 Scour**

Several structures will be located over or adjacent to creek beds and subject to potential scour, these are:

- SR 65 East Roseville Viaduct Widening over Antelope Creek
- I-80 Eastbound Off-Ramp Widening at Miners Ravine
- Miners Ravine Bridge

- E80/N65 Connector, Northbound SR 65 On-Ramp, Eastbound I-80 On-Ramp
- South SR 65/East I-80 Connector adjacent to Secret Ravine

At the East Roseville Viaduct, the As-Built LOTB's indicate that within the main channel area (north end of the viaduct) hard and/or dense cohesive soils are present within 5 to 8 feet of the ground surface. These soils will be resistant to scour.

At the I-80 Eastbound Off-Ramp Widening at Miners Ravine, the As-Built LOTB's indicate that adjacent to the main channel dense to very dense, sandy gravel and silt, and hard, volcanic breccia present within 8 feet of the ground surface. These soils will be resistant to scour.

At Miners Ravine Bridge, the As-Built LOTB's indicate that adjacent to the main channel (approximately elevation 154 ft) very stiff and weakly cemented silt and moderately hard, volcanic breccia is present within 12 to 23 feet of the ground surface. These soils will be resistant to scour.

At the E80/N65 Connector, Northbound SR 65 On-Ramp, and Eastbound I-80 On-Ramp, there is no available subsurface data where these structures will be located within and/or adjacent to Secret Ravine. However, we expect this location to be underlain at relatively shallow depths (on the order of 5 to 10 feet) by scour resistant soils and/or rock of the Turlock Lake Formation and/or Mehrten Formation. Existing and/or newly constructed embankment fill located adjacent to the creek bed will have a high scour potential.

At the South SR 65/East I-80 Connector, there is no available subsurface data where the connector will be adjacent to Secret Ravine. However, we expect this location to be underlain at relatively shallow depths (on the order of 4 to 8 feet) by scour resistant rock of the Mehrten Formation and possibly granitic rock at the east end. Existing embankment fill located adjacent to the creek bed will have a high scour potential.

## **9 PRELIMINARY SOIL CORROSION EVALUATION**

Soil corrosivity has not yet been evaluated for this project. Based on available subsurface data, the soil and rock within the project area is generally expected to be non-corrosive to structural elements (as defined by Caltrans, 2012, Corrosion Guidelines, Version 2.0). Andesitic volcanics (labeled as "Tva" on Figure 3) found in the interchange area, west of Miners Ravine, and northwest of Antelope Creek can have a relatively low pH and require concrete water/cement ratio considerations.

According to the USDA Web Soil Survey (<http://websoilsurvey.nrcs.usda.gov/app/>), the risk of corrosion of concrete is considered low to moderate throughout the project area. The risk of corrosion of steel is considered moderate to high. Corrosion testing and analysis will be completed during the design-level investigations.

## **10 CONSTRUCTION CONSIDERATIONS**

Excavation: As noted above, moderately hard rock can be encountered near the surface in portions of the project area where underlain by volcanic mudflow breccia of the Mehrten Formation (labeled as “Tva” on Figure 3) or granitic rock (labeled as “Mzg” on Figure 3). Excavation of some of these materials can be difficult and can generate large diameter material that will need to be screened and/or crushed prior to use as engineered fill.

Dewatering: We expect that shallow groundwater, if encountered, will be of limited quantity and controllable with sump pumps. In general, we do not anticipate the presence of significant groundwater at shallow depth within footing excavations during dry season construction (June through October) unless adjacent to active creek beds (such as at Antelope Creek, Secret Ravine, and Miners Ravine structure locations). Deep foundations (such as drilled shafts in the interchange median) can encounter perched groundwater and wet foundation construction conditions should be anticipated.

Rock Drilling/Coring: Drilling for Cast-in-drilled-hole (CIDH) piles at locations underlain by volcanic mudflow breccia of the Mehrten Formation (labeled as “Tva” on Figure 3) or granitic rock (labeled as “Mzg” on Figure 3) can require drilling with rock bits and/or rock coring to achieve adequate pile penetration.

## **11 SUBSURFACE EXPLORATION AND LABORATORY TESTING**

To provide design level reports, subsurface exploration and laboratory testing is required. Specifically, we recommend the following:

- Drill, log and sample a minimum of one boring at each proposed bridge abutment and bent location (this can be modified based on applicability of existing data)
- Complete borings and/or exploratory trenches along ramps and at wall locations
- Anticipate rock coring in areas adjacent to or underlain by Mehrten volcanics or granitic rock (shown as areas labeled as “Tva” and “Mzg” on Figure 3).
- Record groundwater depths during drilling
- Complete laboratory tests that include moisture content, density, unconfined compressive strength, direct shear, maximum density (proctor), R-value, and corrosivity

## **12 LIMITATIONS**

This SPGR is based on site review and subsurface information provided to BCI and is not intended for final design. Additional study, including subsurface exploration, laboratory testing, and analyses are required for final design. BCI performed these services in accordance with generally accepted geotechnical engineering principles and practices currently used in this area. We do not warranty our services.

### **13 REFERENCES**

Anderson Geotechnical Consultants, Inc., 1984, Highway 65 and I-80, Site Exploration Results, 11/29/1984

Bryant, W.A. and Hart, E.W., 2007 (Interim Revision), Fault-Rupture Hazard Zones in California; California Department of Conservation, Division of Mines and Geology, Special Publication 42.

Caltrans, 1984, Memorandum, Route 65/80 Separation Foundation Recommendations, 3/21/1984

Caltrans, 1986, Memorandum, Foundation Investigation, Taylor Road Overcrossing, 11/20/1986

Caltrans, 2010, Seismic Design Criteria, Version 1.6.

Caltrans, 2012, Corrosion Guidelines, Version 2.0

Caltrans, November 2013, ARS Online (V2.3.06)

Caltrans, Logs of Test Borings

- Atlantic Street Overcrossing, Caltrans, As-Built, 12/29/1989, Sheets 18 and 19 of 19
- Harding Boulevard Overcrossing (Galleria Blvd), CH2M Hill, As-Built, 10/17/1988, Sheet 12 of 12
- Roseville Parkway Overcrossing, Kleinfelder Inc., As-Built, 11/10/2000, Sheets 47 to 51 of 51
- Miners Ravine Bridge (EB off-ramp), Caltrans, As-Built, 12/29/1989, Sheets 13 and 14 of 14
- Miners Ravine Bridge (WB on-ramp), Caltrans, As-Built, 12/29/1989, Sheets 10 to 12 of 12
- Miners Ravine Bridge (Widen), Kleinfelder, Inc., 11/17/2008, Sheets 477 to 481 of 539
- Route 65/80 Separation, Caltrans, As-Built, 10/6/1987, Sheet 14 of 14
- East Roseville Viaduct, Caltrans, As-Built, 8/6/1987, Sheet 173 to 175 of 175
- Retaining Wall - 39E-41E, Kleinfelder, Inc., 12/2006, Sheet 24 to 29 of 29
- Retaining Wall - 40W-42W, Kleinfelder, Inc., 12/2006, Sheet 23 to 29 of 29
- Retaining Wall - 48W, Kleinfelder, Inc., 11/2008, Sheet 11 to 14 of 14
- Retaining Wall - 49E, Kleinfelder, Inc., 9/2008, Sheet 11 to 14 of 14
- Retaining Wall - 58E, Kleinfelder, Inc., 9/2008, Sheet 11 to 14 of 14
- Retaining Wall - 59W, Kleinfelder, Inc., 11/2008, Sheet 10 to 13 of 13

Helley, E.J. and Harwood, D.S., 1985, Geologic Map of the Late Cenozoic Deposits of the Sacramento Valley and Northern Sierran Foothills: U.S. Geological Survey, Map MF-1790.

Jennings, C.W. and Bryant, W.A., 2010 Fault Activity Map of California, California Geological Survey, Geologic Data Map No. 6. Digital version located at <http://www.quake.ca.gov/gmaps/FAM/faultactivitymap.html>

Livingston, J.G., 1974, Engineering Geologic Map of the Rocklin and Roseville Quadrangles, Placer County, California; maps prepared for the Placer County Planning Department.

**STRUCTURES PRELIMINARY GEOTECHNICAL REPORT**

*Interstate 80 & State Route 65 Interchange Improvement Project*

*BCI Job. No. 1980.1*

*Placer County, California, EA 03-4E3200; 03-PLA-80/6, PM 1.9-6.1/ R4.8-R7.3*

*November 20, 2014 (rev 1)*

Loyd, Ralph, 1995, Mineral Land Classification of Placer County, California; California Department of Conservation, Division of Mines and Geology, DMG Open-File Report 95-10.

Merriam, M. and Shantz, T., 2007, 2007 Caltrans Deterministic PGA Map, Fault Identification Numbers (FID) Shown, September 2007; Caltrans Division of Engineering Services, Geotechnical Services and Division of Research & Innovation, GeoResearch Group

Mulder, J., 2007, Geologic Map of the Late Cenozoic Deposits of the Sacramento Valley, California Department of Water Resources, modified digital reproduction of the Geologic Map of the Late Cenozoic Deposits of the Sacramento Valley and Northern Sierran Foothills, California, by Edward J. Helley and David S. Harwood (USGS Publication MF-1790, 1985).

MWH, 2007, Western Placer Groundwater Management Plan

The Spink Corporation, 1995, Roseville 150 Joint Venture, Road "E" & Antelope Creek Bridge, Roseville 150 Center, Logs by Wallace Kuhl & Associates Inc., Sheet 17 of 17

USDA, 2012, Web Soil Survey (<http://websoilsurvey.nrcs.usda.gov/app/>)

Wagner, D.L. et al, 1981, Geologic Map of the Sacramento Quadrangle, California, California Geological Survey, Map No. 1A, revised 1987.

## **FIGURES**

Figure 1 – Vicinity Map

Figure 2A -2C – Site Map

Figure 3 – Geologic Map


Figure 4 – Regional Fault Map

Figure 5 – Groundwater Elevation Map

Figure 6a and 6b – Preliminary ARS Response Spectra



DIST	COUNTY	ROUTE	POST MILES TOTAL PROJECT
03	Pla	80/65	1.9-6.1/R4.8-R7.3

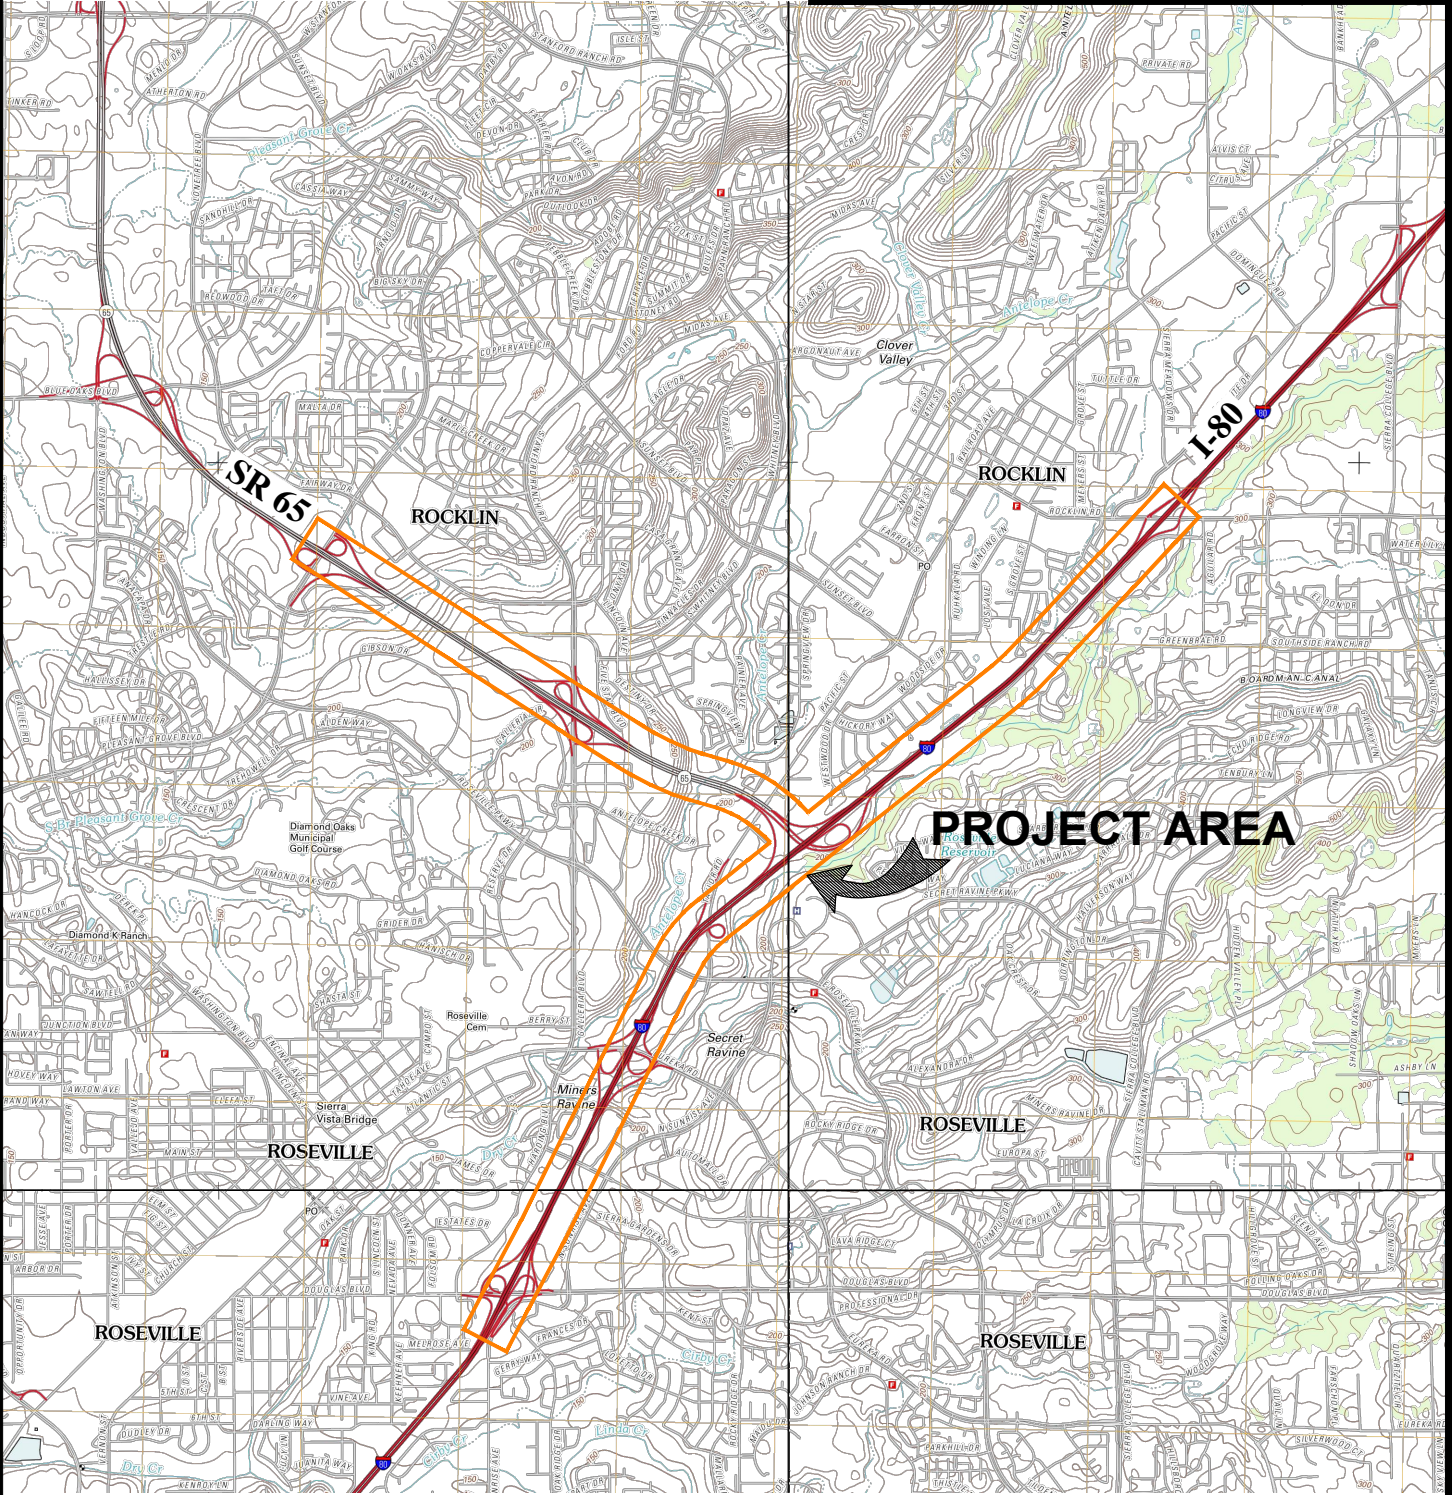

**SOURCE: USGS Roseville, Rocklin, Citrus Heights and Folsom  
Quadrangles, 7.5 Minute Series topographic, 1:24000, dated 2012.**



**SCALE: 1"=4,000'**



11521 Blocker Drive, Suite 110  
Auburn, CA 95603  
Phone: (530) 887-1494  
Fax: (530) 887-1495  
www.blackburnconsulting.com

**VICINITY MAP**  
Interstate 80/State Route 65 Interchange  
Improvement Project, EA 03-4E3200  
Placer County, California


**File No. 1980.4.1**

**November 2014**

**Figure 1**



DIST	COUNTY	ROUTE	POST MILES TOTAL PROJECT
03	Pla	80/65	1.9-6.1/R4.8-R7.3

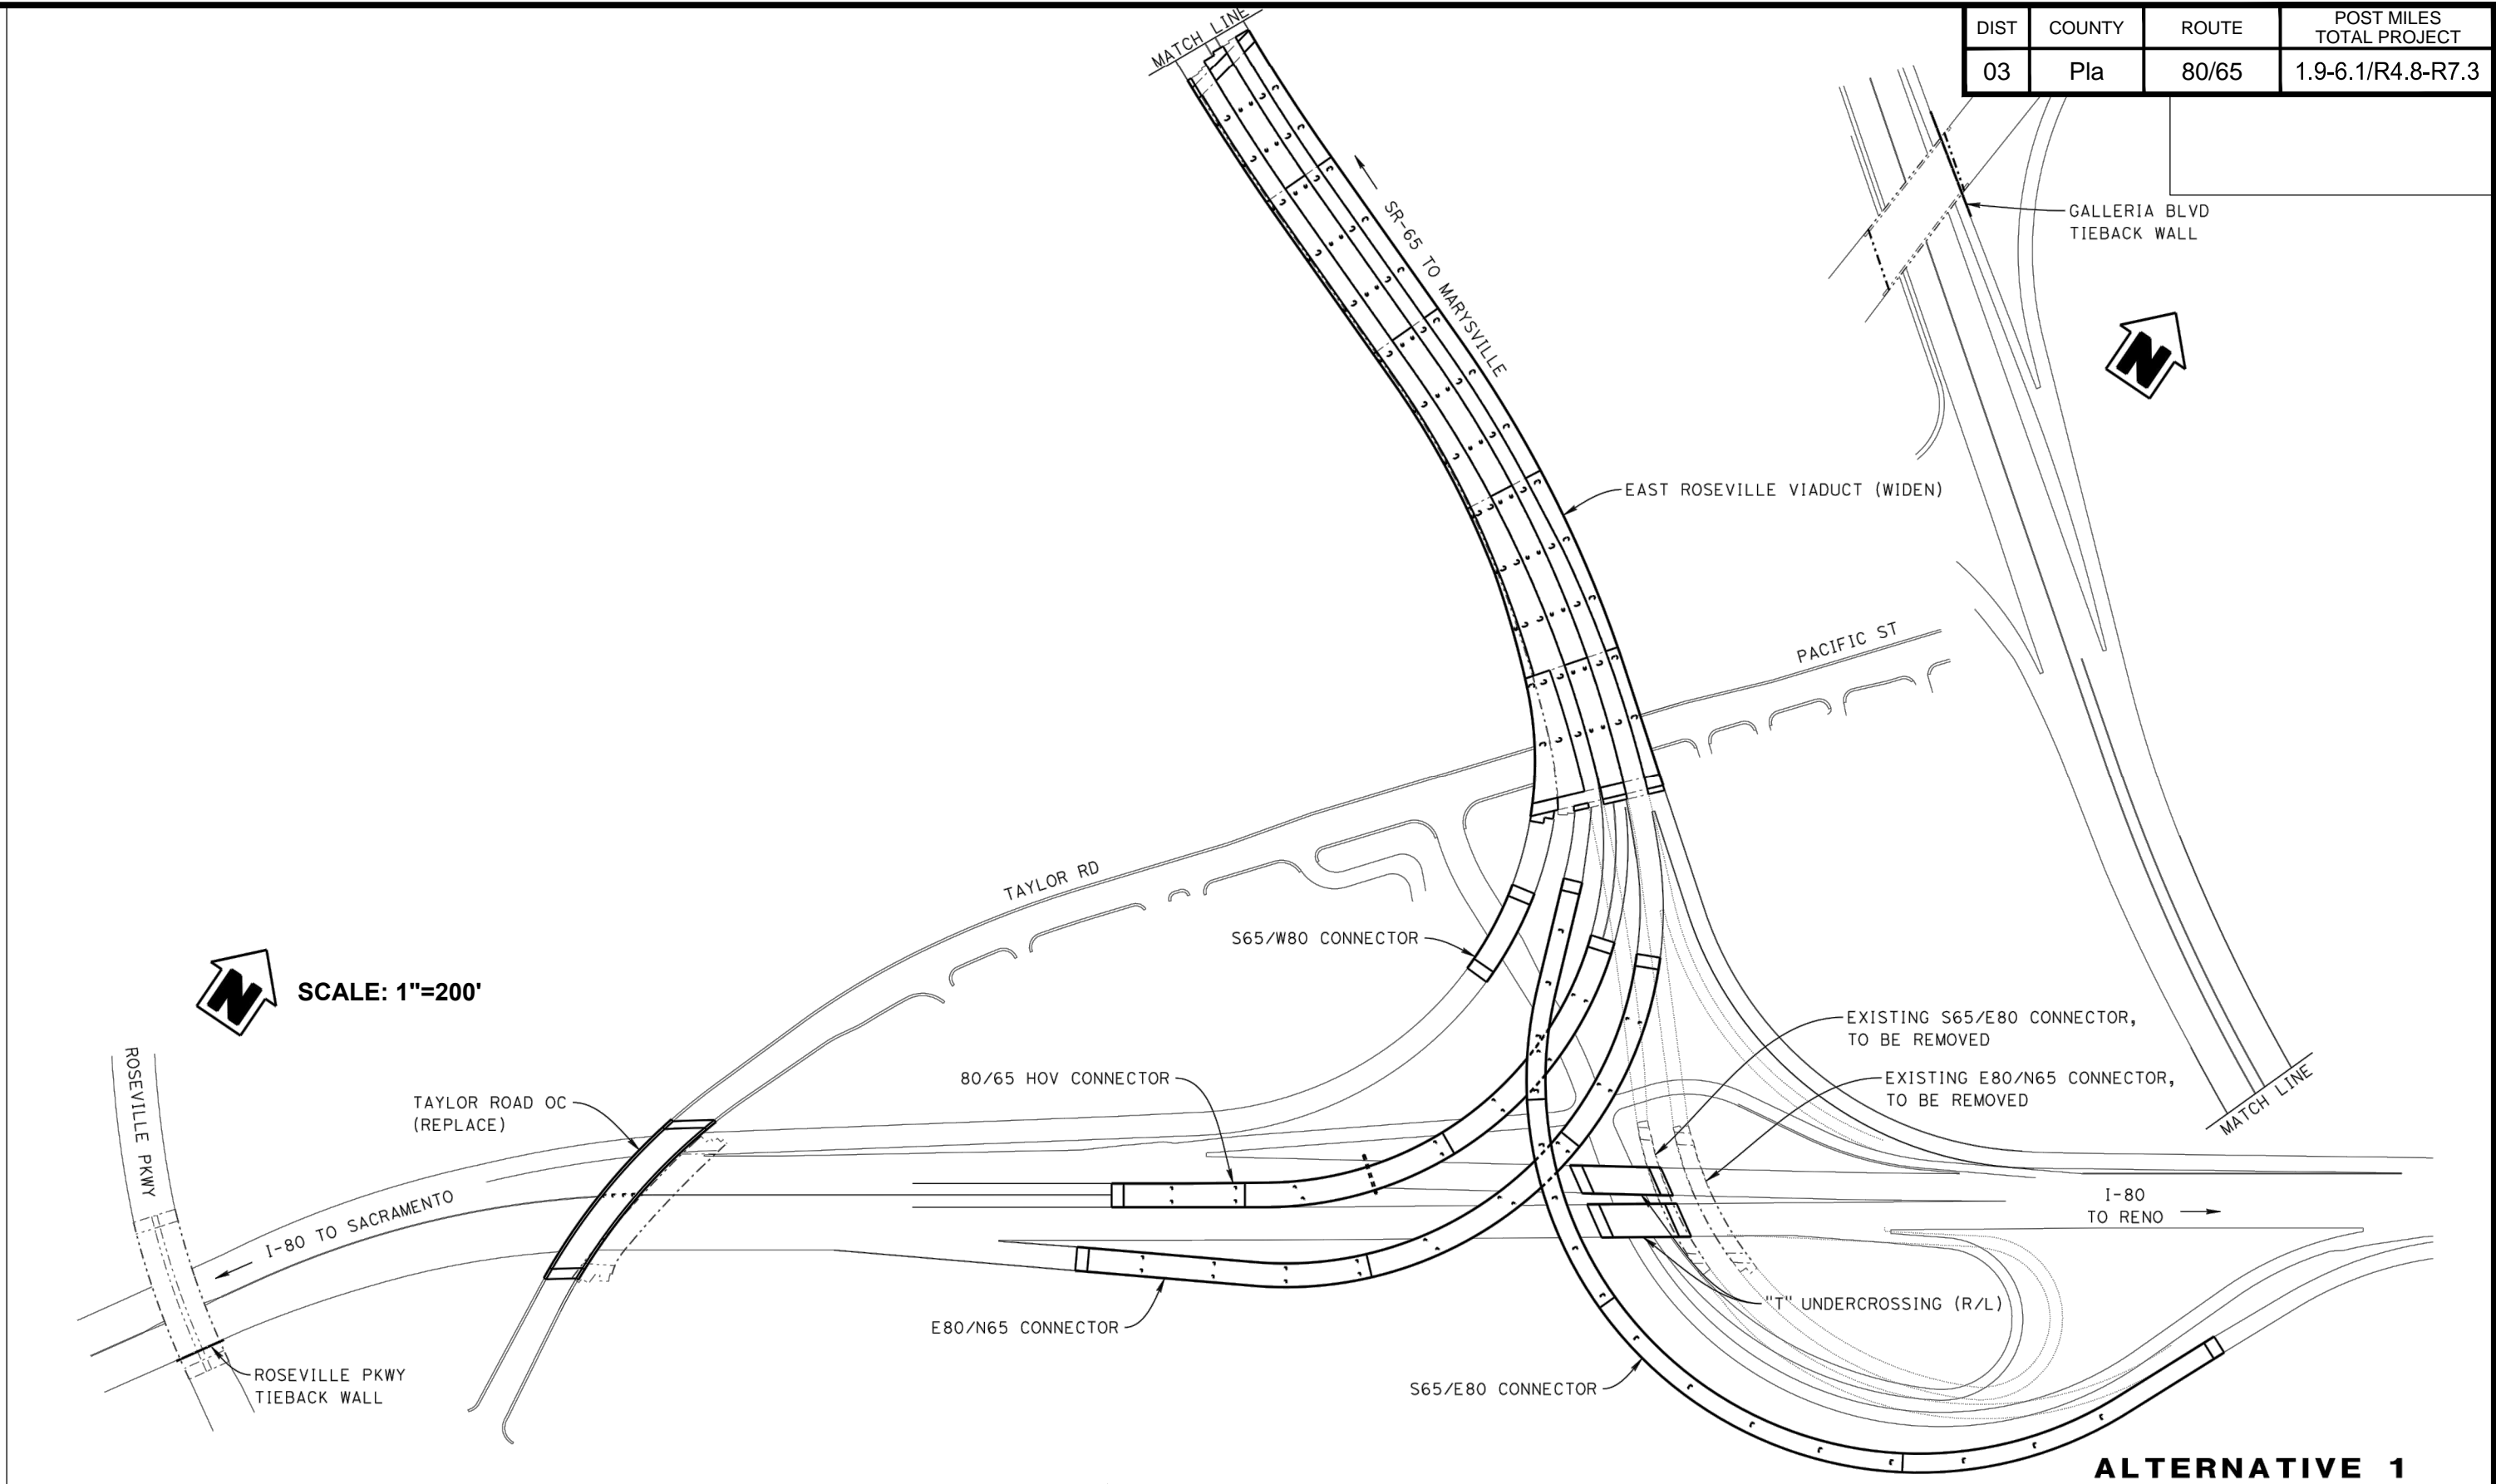

**ALTERNATIVE 1**

SOURCE: Preliminary plans by CH2MHILL, Planning Study Location  
Map, Alternate 1, plot date July 24, 2014.



11921 Blocker Drive, Suite 110  
Auburn, CA 95603  
Phone: (530) 887-1494  
Fax: (530) 887-1495  
www.blackburnconsulting.com

**SITE MAP**  
Interstate 80/State Route 65  
Interchange Improvement Project, EA 03-4E3200  
Placer County, California


File No. 1980.4.1

November 2014

Figure 2a

9/8/2014 1980.4.1 Fig 2 I80\_SR65 Interchange.dwg

DIST	COUNTY	ROUTE	POST MILES TOTAL PROJECT
03	Pla	80/65	1.9-6.1/R4.8-R7.3

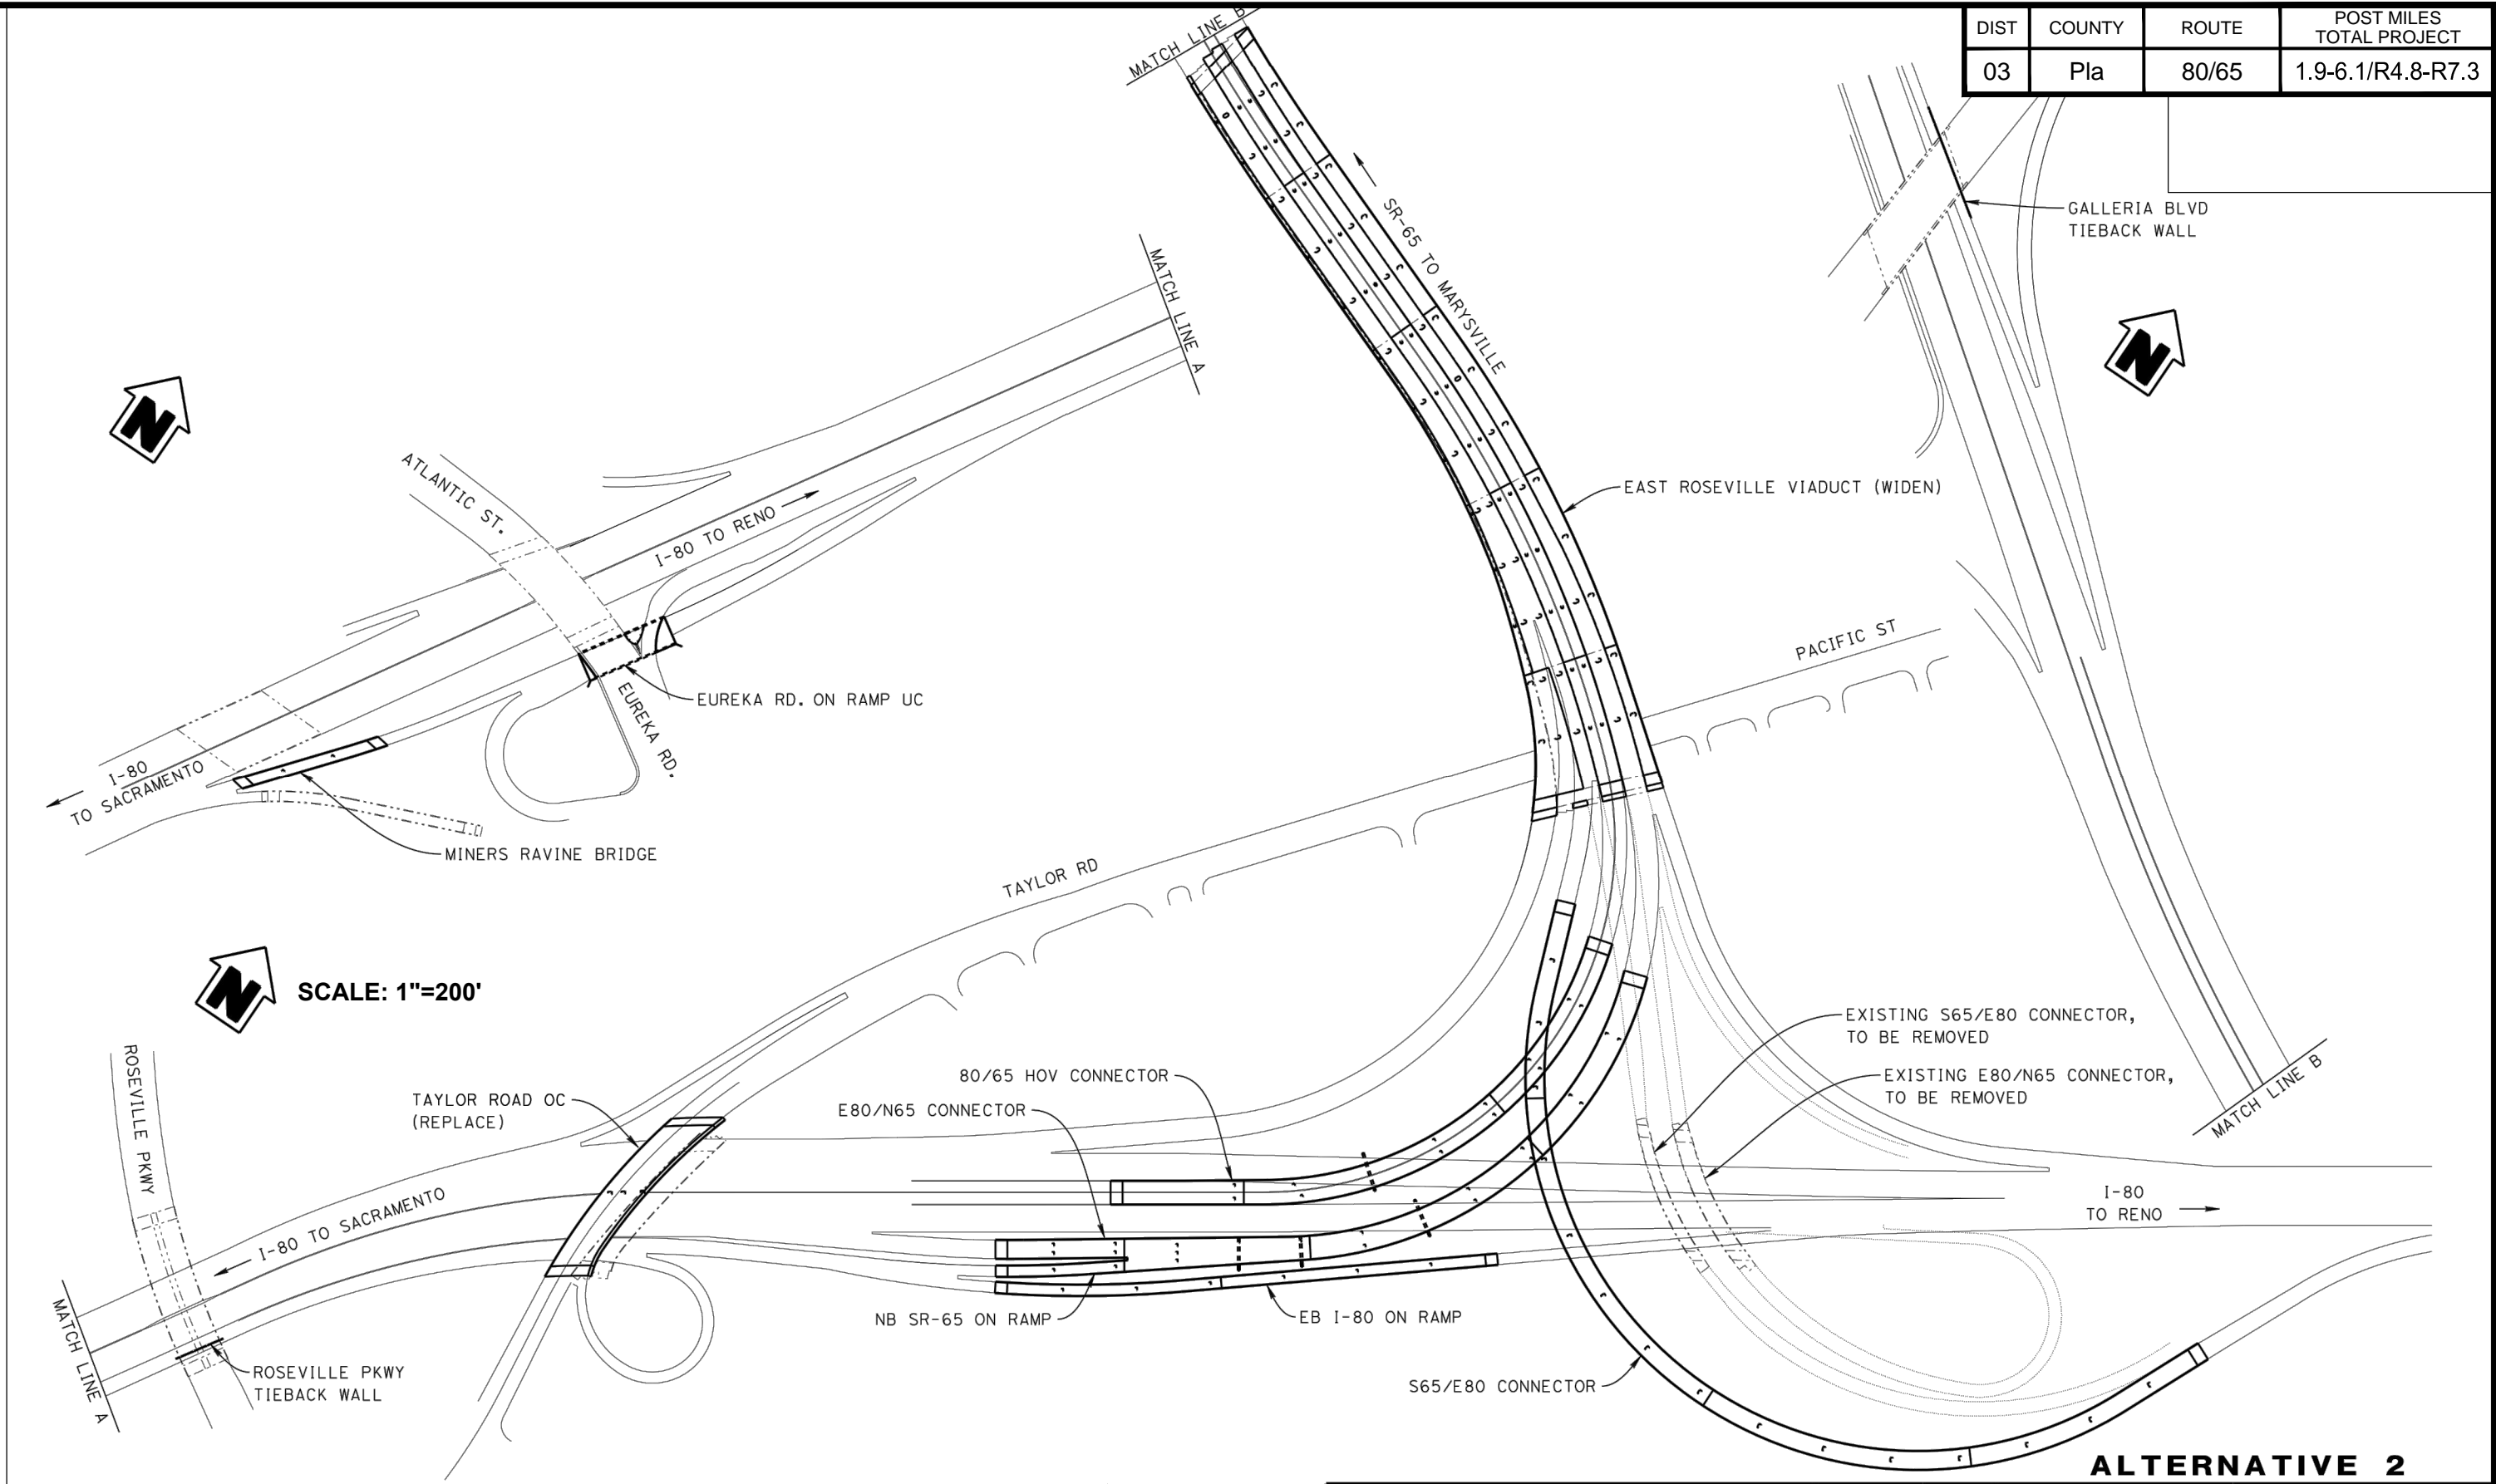

**ALTERNATIVE 2**

SOURCE: Preliminary plans by CH2MHILL, Planning Study Location  
Map, Alternate 2, plot date July 24, 2014.




11921 Blocker Drive, Suite 110  
Auburn, CA 95603  
Phone: (530) 887-1494  
Fax: (530) 887-1495  
www.blackburnconsulting.com

**SITE MAP**  
Interstate 80/State Route 65  
Interchange Improvement Project, EA 03-4E3200  
Placer County, California

File No. 1980.4.1  
November 2014  
Figure 2b

9/8/2014 1980.4.1 Fig 2 180\_SR65 Interchange.dwg

DIST	COUNTY	ROUTE	POST MILES TOTAL PROJECT
03	Pla	80/65	1.9-6.1/R4.8-R7.3

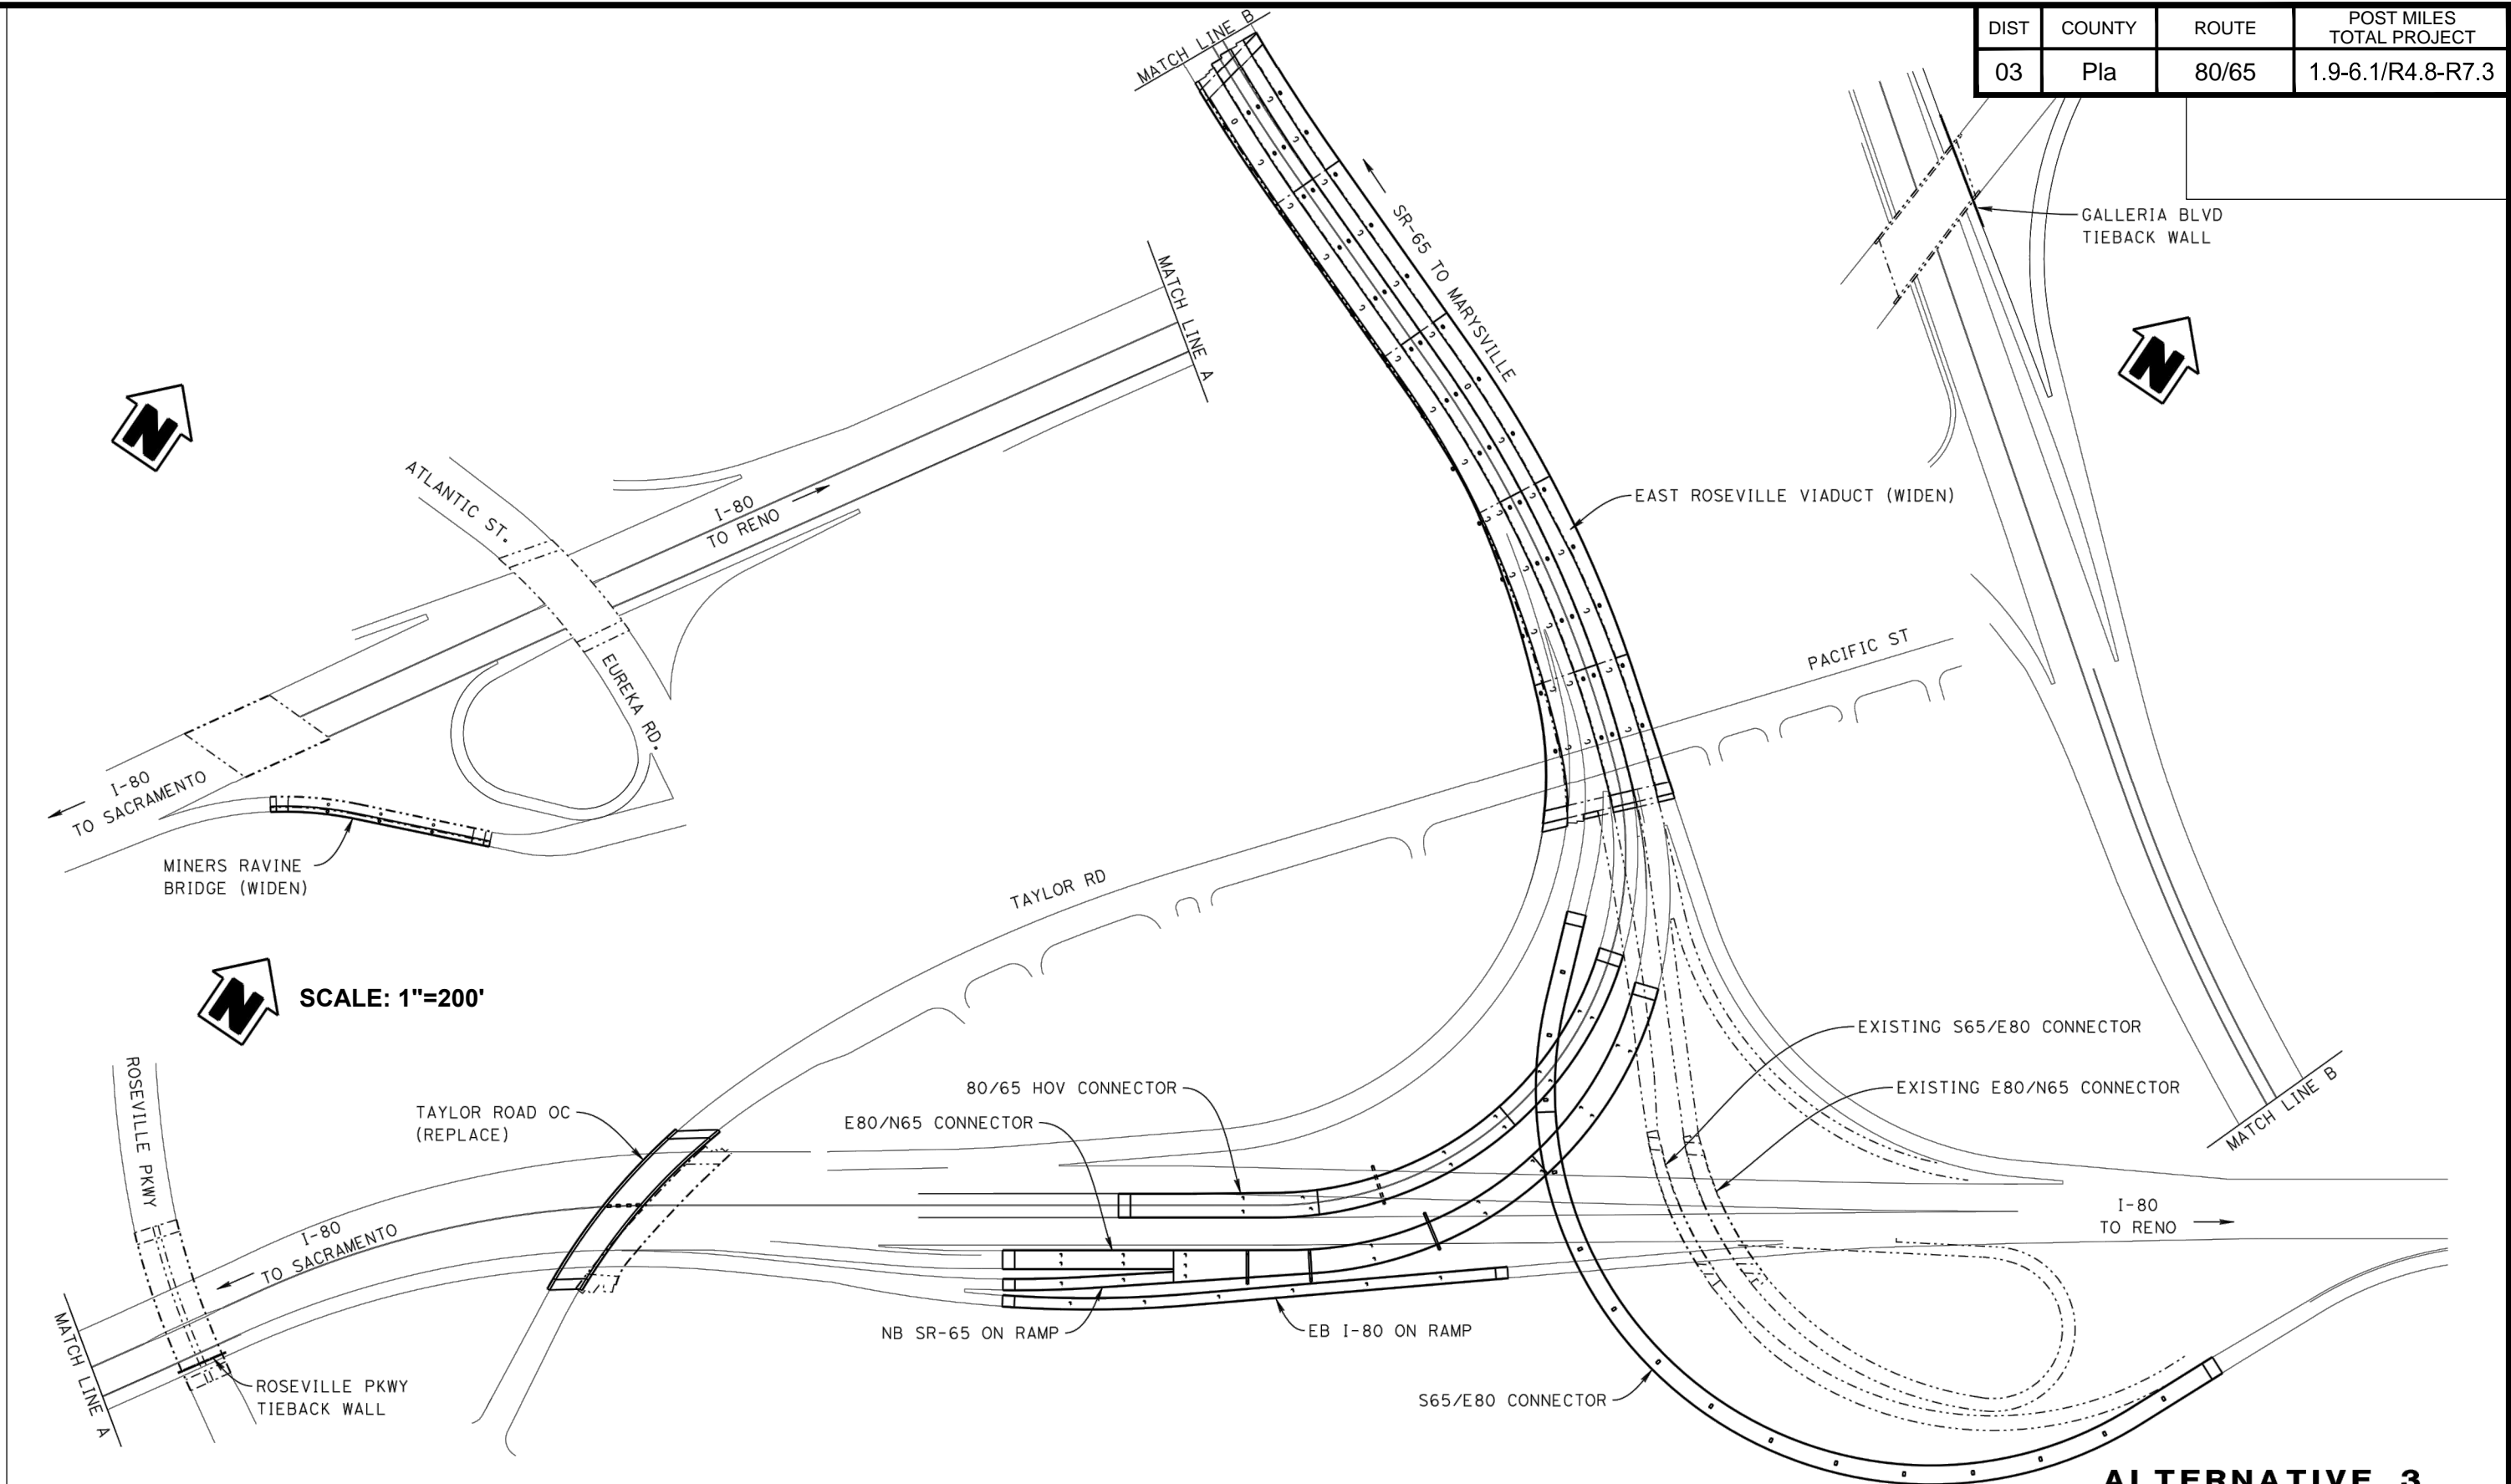

**ALTERNATIVE 3**

SOURCE: Preliminary plans by CH2MHILL, Planning Study Location  
Map, Alternate 3, plot date July 24, 2014.




11921 Blocker Drive, Suite 110  
Auburn, CA 95603  
Phone: (530) 887-1494  
Fax: (530) 887-1495  
www.blackburnconsulting.com

**SITE MAP**  
Interstate 80/State Route 65  
Interchange Improvement Project, EA 03-4E3200  
Placer County, California

File No. 1980.4.1  
November 2014  
Figure 2c

9/8/2014 1980.4.1 Fig 2 180\_SR65 Interchange.dwg

DIST	COUNTY	ROUTE	POST MILES TOTAL PROJECT
03	Pla	80/65	1.9-6.1/R4.8-R7.3

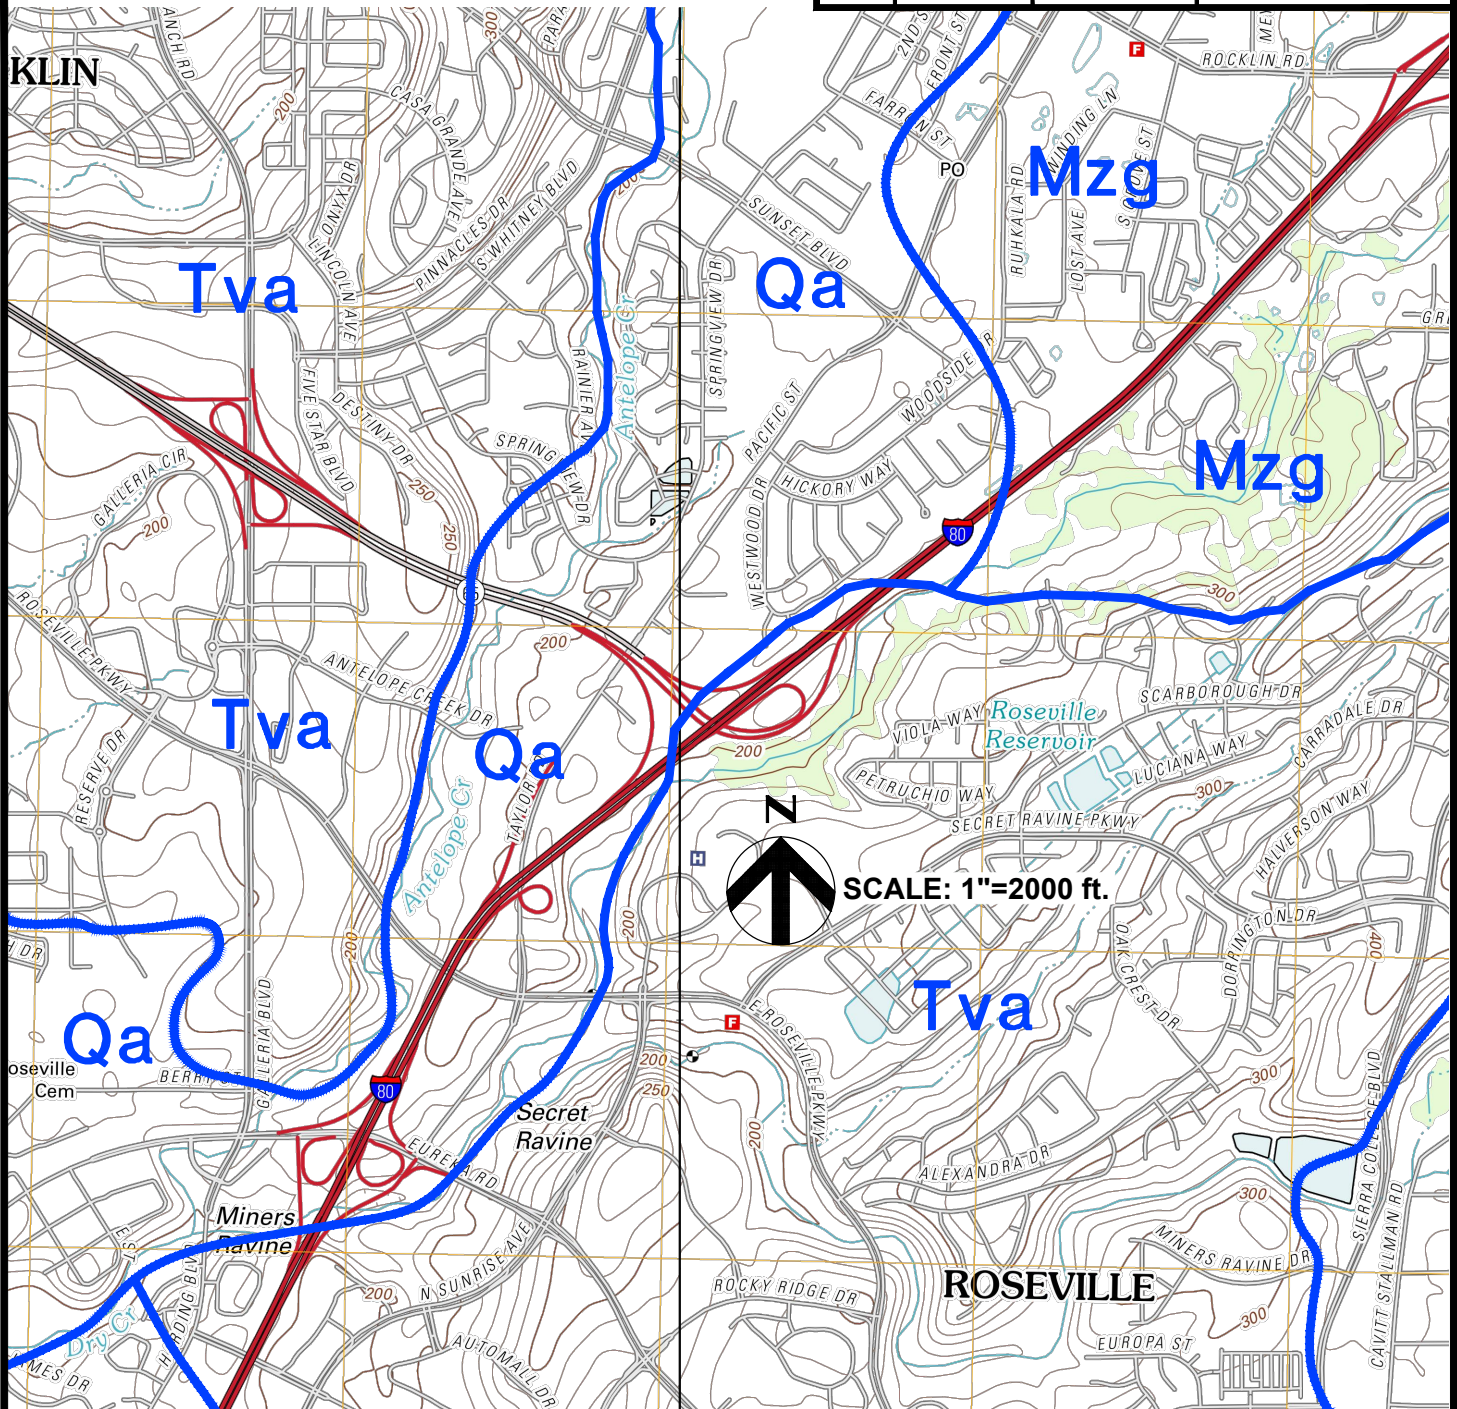


**LEGEND**

Qa - Alluvium (Riverbank and Turlock Lake Formations)

Tva - Andesitic, volcanic mudflows, breccia, and sediments (Mehrten Formation)

Mzg - Granitic rock of the Rocklin Pluton

 - Approximate Geologic Contact

Base Source: USGS Roseville and Rocklin Quadrangles, 7.5 Minute Series topographic, 1:24000, dated 2012.

Geologic Source: Modified after Livingston, 1974, and Loyd, 1995.

9/8/2014 - 1980.4.1.Fin.3.180 - SR65 Interchange.dwg



11521 Blocker Drive, Suite 110  
Auburn, CA 95603  
Phone: (530) 887-1494  
Fax: (530) 887-1495  
www.blackburnconsulting.com


**GEOLOGIC MAP**  
Interstate 80/State Route 65 Interchange  
Improvement Project, EA 03-4E3200  
Placer County, California

File No. 1980.4.1

November 2014

Figure 3

DIST	COUNTY	ROUTE	POST MILES TOTAL PROJECT
03	Pla	80/65	1.9-6.1/R4.8-R7.3

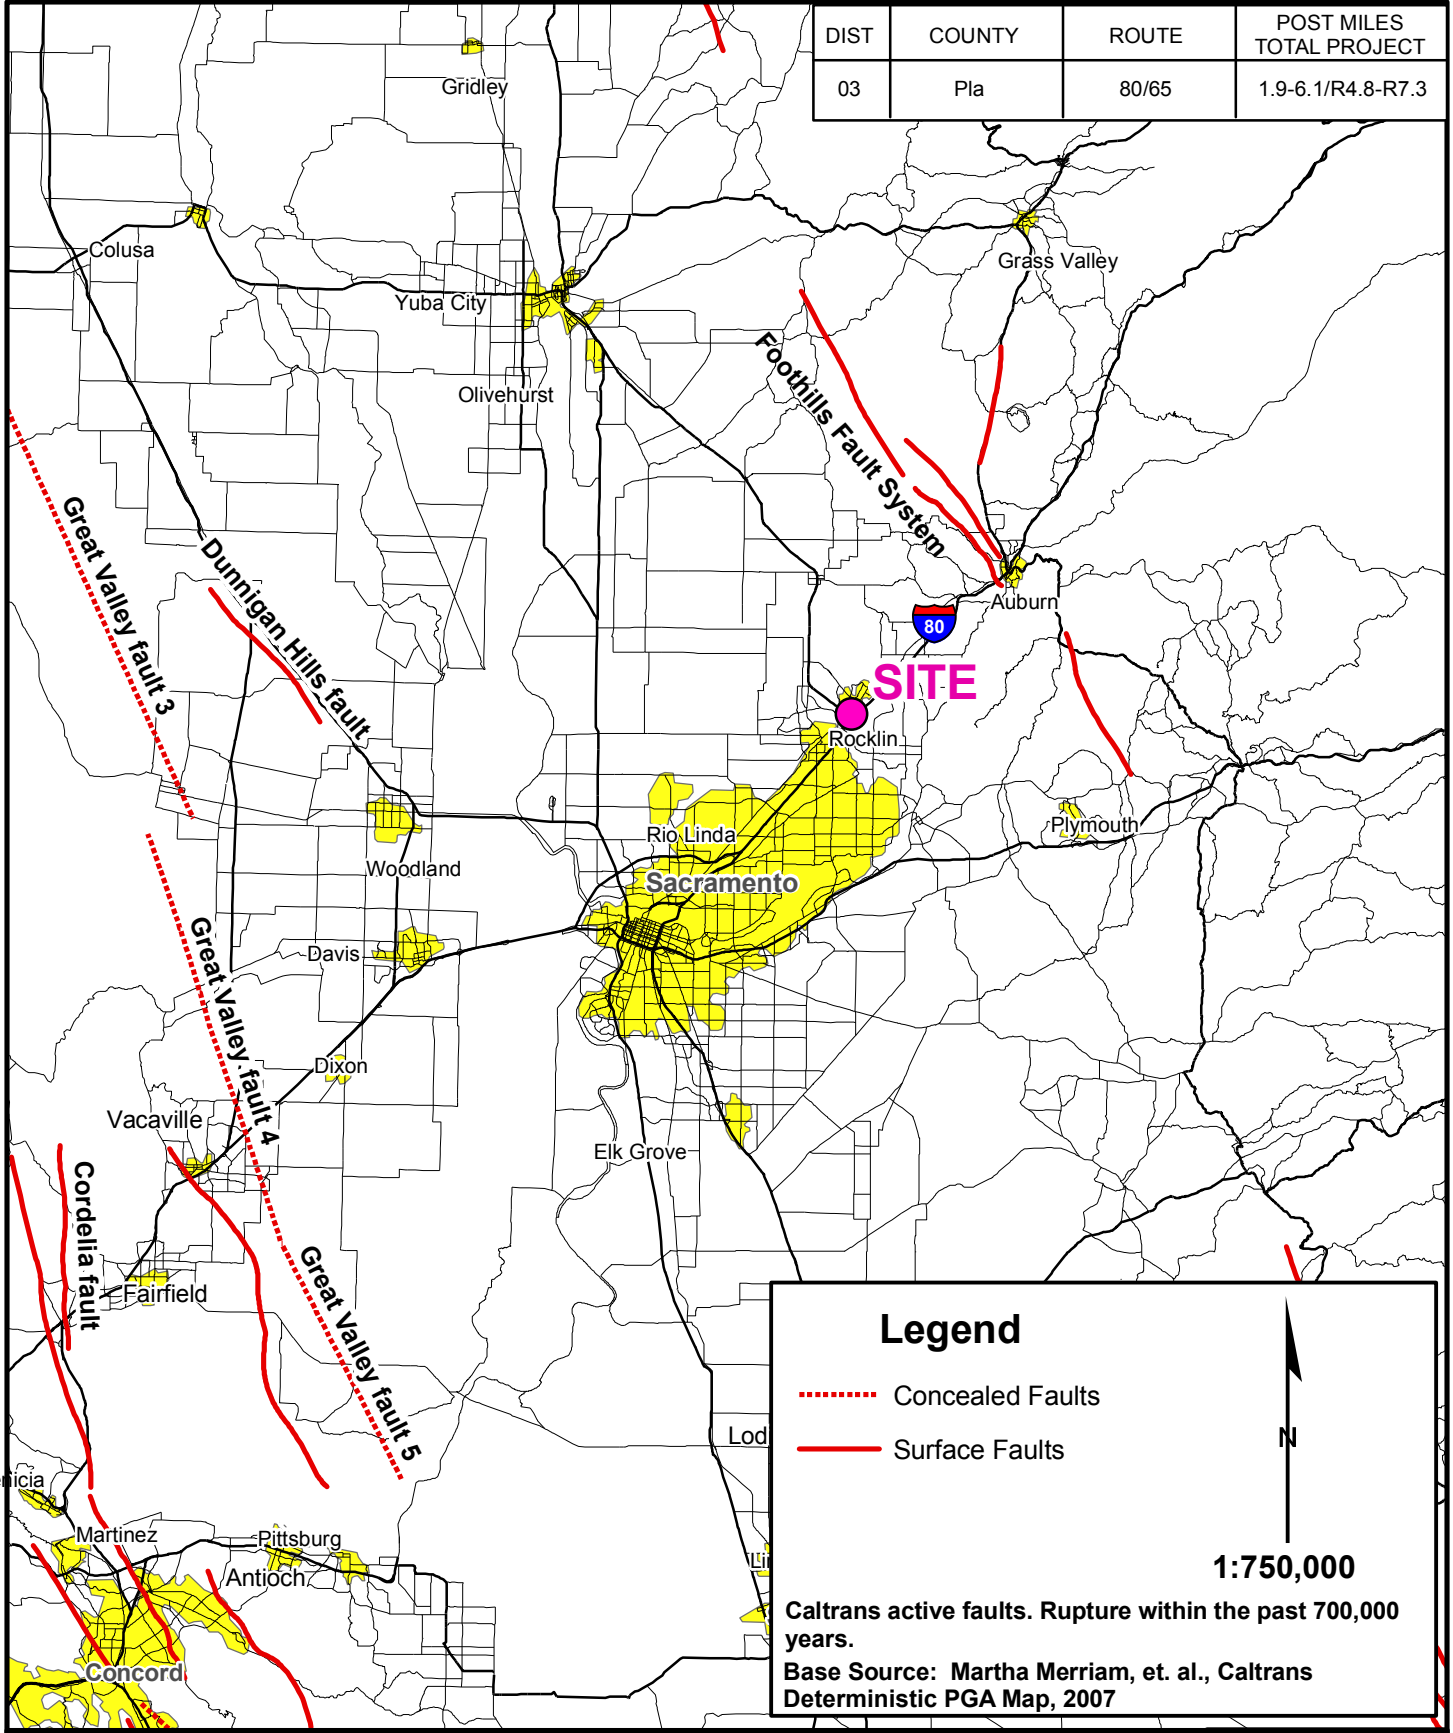

**Legend**

- ..... Concealed Faults
- Surface Faults

▲ Caltrans active faults. Rupture within the past 700,000 years.

Base Source: Martha Merriam, et. al., Caltrans Deterministic PGA Map, 2007

N  
1:750,000




11521 Blocker Drive, Ste 110  
Auburn, CA 95603  
Phone: (530) 887-1494  
Fax: (530) 887-1495-Fax  
www.blackburnconsulting.com

**REGIONAL FAULT MAP**  
 Interstate 80 / State Route 65 Interchange  
 Improvement Project, EA 03-4E3200  
 Placer County, California

File No. 1980.4.1  
 November 2014  
 Figure 4

DIST	COUNTY	ROUTE	POST MILES TOTAL PROJECT
03	Pla	80/65	1.9-6.1/R4.8-R7.3

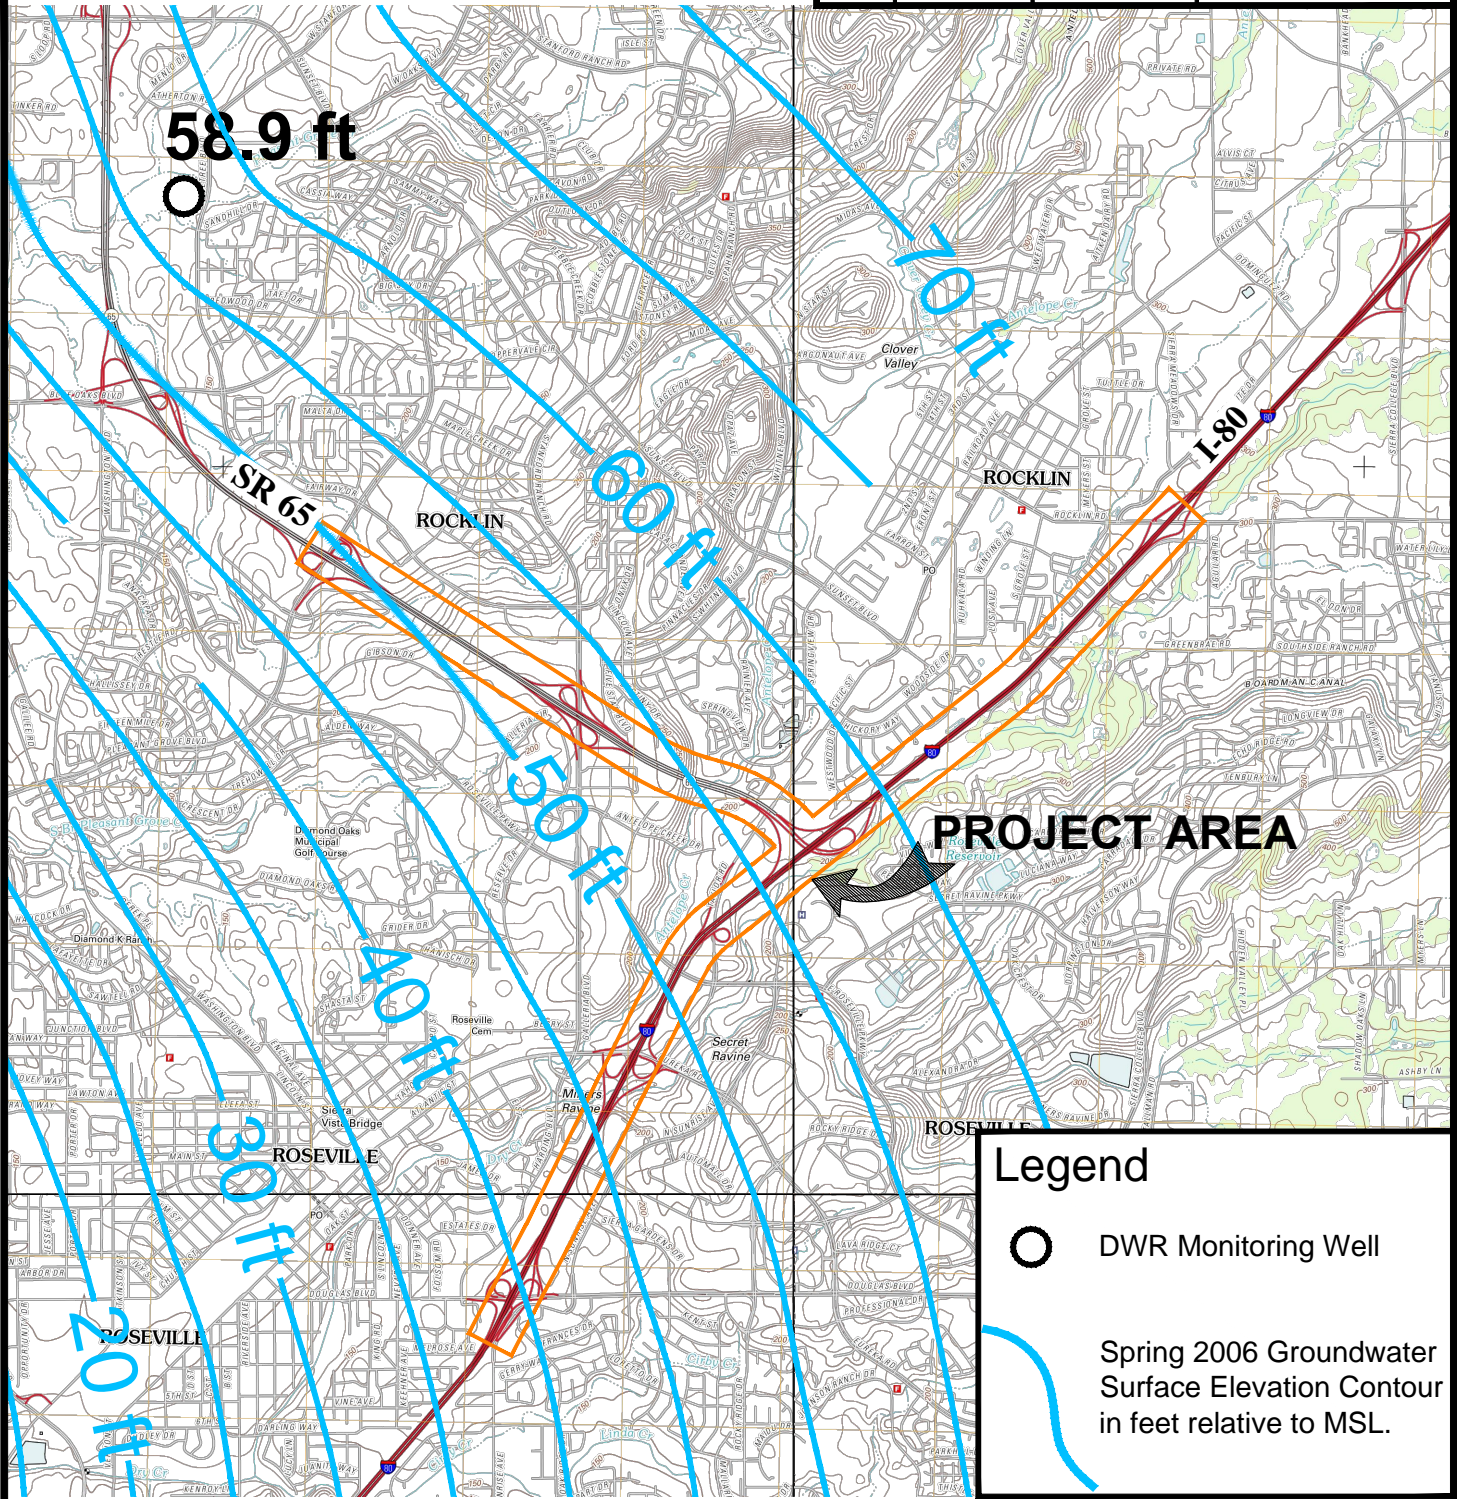

**Legend**

- DWR Monitoring Well
- Spring 2006 Groundwater Surface Elevation Contour in feet relative to MSL.

SOURCE: Figure 2-4 - Groundwater Elevation Map, Western Placer County Groundwater Management Plan by MWH, dated May 2007 and USGS Roseville, Rocklin, Citrus Heights and Folsom Quadrangles, 7.5 Minute Series topographic, 1:24000, dated 2012.

**N**

**SCALE: 1"=4,000'**

9/8/2014 1:980.4.1 Fig 5 180\_SR65 Interchange.dwg




11521 Blocker Drive, Suite 110  
Auburn, CA 95603  
Phone: (530) 887-1494  
Fax: (530) 887-1495  
www.blackburnconsulting.com

**GROUNDWATER ELEVATION MAP**  
Interstate 80/State Route 65 Interchange  
Improvement Project, EA 03-4E3200  
Placer County, California

**File No. 1980.4.1**  
**November 2014**  
**Figure 5**

DIST	COUNTY	ROUTE	POST MILES TOTAL PROJECT
03	Pla	80/65	1.9 -6.1/R4.8 -R7.3

Preliminary Design ARS Curve (5% Damping)

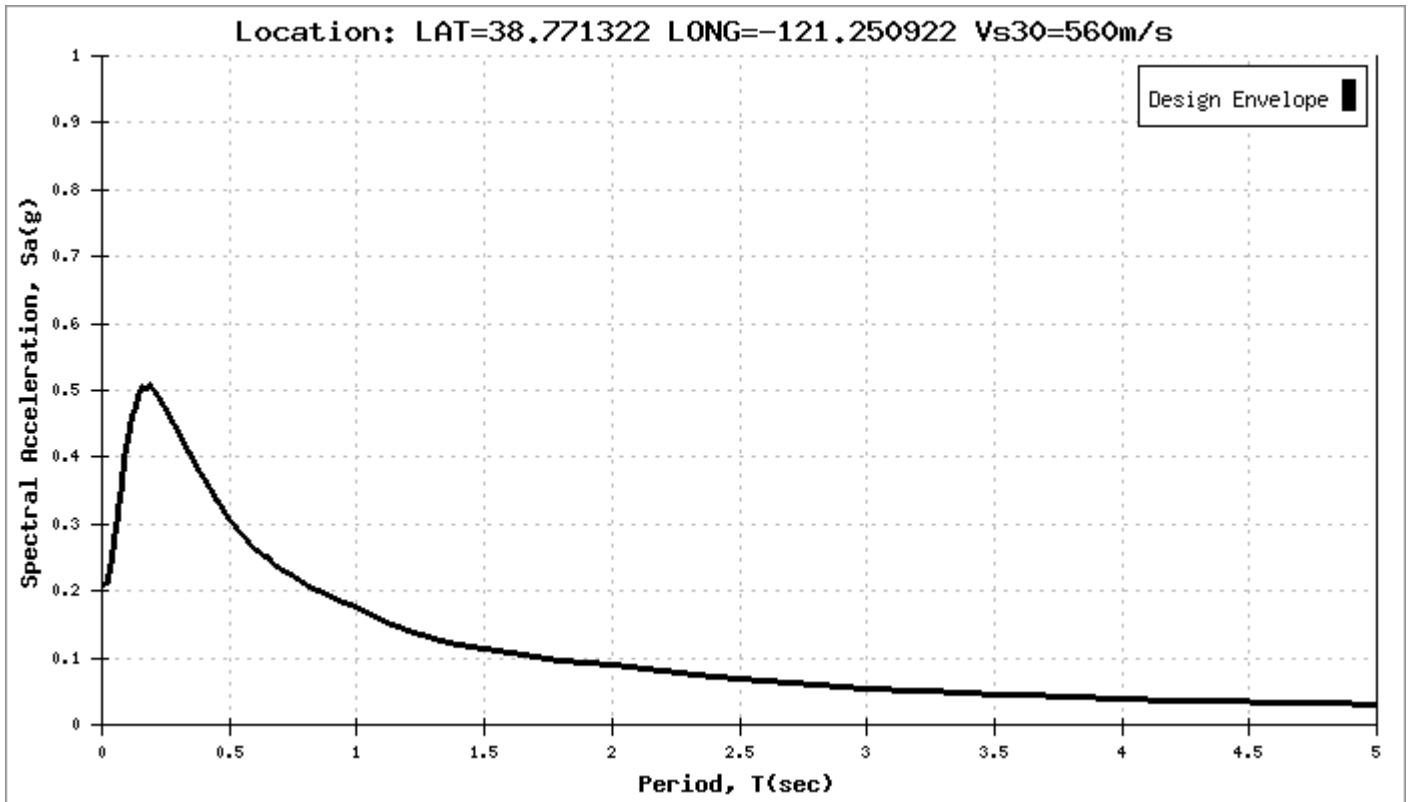

Caltrans ARS Online (V 2.3.06)



11521 Blocker Drive, Suite 110  
 Auburn, CA 95603  
 Phone: (530) 887-1494  
 Fax: (530) 887-1495  
 www.blackburnconsulting.com

**PRELIMINARY ARS**  
 Interstate 80/State Route 65 Interchange  
 Improvement Project, EA 03-4E3200  
 Placer County, California

File No. 1980.4.1

November 2014

Figure 6a

**Figure 6b**  
**Preliminary Design ARS Spectrum Data**

<b>Period</b>	<b>SA</b>	<b>Period</b>	<b>SA</b>	<b>Period</b>	<b>SA</b>	<b>Period</b>	<b>SA</b>
<b>0</b>	0.210	<b>0.085</b>	0.386	<b>0.35</b>	0.400	<b>1.4</b>	0.121
<b>0.01</b>	0.210	<b>0.09</b>	0.399	<b>0.36</b>	0.394	<b>1.5</b>	0.114
<b>0.02</b>	0.214	<b>0.095</b>	0.413	<b>0.38</b>	0.381	<b>1.6</b>	0.108
<b>0.022</b>	0.217	<b>0.1</b>	0.425	<b>0.4</b>	0.369	<b>1.7</b>	0.102
<b>0.025</b>	0.221	<b>0.11</b>	0.444	<b>0.42</b>	0.355	<b>1.8</b>	0.097
<b>0.029</b>	0.227	<b>0.12</b>	0.461	<b>0.44</b>	0.341	<b>1.9</b>	0.093
<b>0.03</b>	0.228	<b>0.13</b>	0.476	<b>0.45</b>	0.335	<b>2</b>	0.089
<b>0.032</b>	0.233	<b>0.133</b>	0.480	<b>0.46</b>	0.329	<b>2.2</b>	0.079
<b>0.035</b>	0.240	<b>0.14</b>	0.488	<b>0.48</b>	0.317	<b>2.4</b>	0.072
<b>0.036</b>	0.243	<b>0.15</b>	0.499	<b>0.5</b>	0.306	<b>2.5</b>	0.068
<b>0.04</b>	0.252	<b>0.16</b>	0.502	<b>0.55</b>	0.278	<b>2.6</b>	0.065
<b>0.042</b>	0.257	<b>0.17</b>	0.503	<b>0.6</b>	0.254	<b>2.8</b>	0.06
<b>0.044</b>	0.262	<b>0.18</b>	0.504	<b>0.65</b>	0.233	<b>3</b>	0.055
<b>0.045</b>	0.265	<b>0.19</b>	0.505	<b>0.667</b>	0.227	<b>3.2</b>	0.051
<b>0.046</b>	0.267	<b>0.2</b>	0.504	<b>0.7</b>	0.216	<b>3.4</b>	0.047
<b>0.048</b>	0.272	<b>0.22</b>	0.490	<b>0.75</b>	0.201	<b>3.5</b>	0.045
<b>0.05</b>	0.277	<b>0.24</b>	0.477	<b>0.8</b>	0.188	<b>3.6</b>	0.043
<b>0.055</b>	0.294	<b>0.25</b>	0.470	<b>0.85</b>	0.180	<b>3.8</b>	0.04
<b>0.06</b>	0.310	<b>0.26</b>	0.463	<b>0.9</b>	0.173	<b>4</b>	0.038
<b>0.065</b>	0.326	<b>0.28</b>	0.449	<b>0.95</b>	0.167	<b>4.2</b>	0.036
<b>0.067</b>	0.332	<b>0.29</b>	0.442	<b>1</b>	0.161	<b>4.4</b>	0.035
<b>0.07</b>	0.342	<b>0.3</b>	0.436	<b>1.1</b>	0.148	<b>4.6</b>	0.033
<b>0.075</b>	0.357	<b>0.32</b>	0.421	<b>1.2</b>	0.138	<b>4.8</b>	0.032
<b>0.08</b>	0.371	<b>0.34</b>	0.407	<b>1.3</b>	0.128	<b>5</b>	0.031

Period = seconds; SA = Spectral Acceleration (g)



## **APPENDIX A**

### **Logs of Test Borings**

Atlantic Street Overcrossing

Harding Boulevard OC

Roseville Parkway Overcrossing

Miners Ravine Bridge (EB off-ramp)

Miners Ravine Bridge (WB on-ramp)

Miners Ravine Bridge (Widen)

Route 65/80 Separation

East Roseville Viaduct

Retaining Wall - 39E-41E

Retaining Wall – 40W-42W

Retaining Wall – 48W

Retaining Wall – 49E


Retaining Wall – 58E

Retaining Wall – 59W



DIST	COUNTY	ROUTE	POST MILES TOTAL PROJECT	SHEET NO.	TOTAL SHEETS
03	Pls	80	2.4/3.2	207	226

Robert L. Campbell #165  
 REGISTERED - CERTIFIED  
 ENGINEERING GEOLOGIST  
 3-7-88  
 PLANS APPROVAL DATE

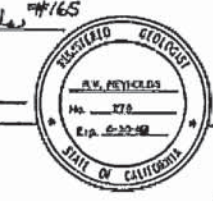

**LEGEND OF BORING OPERATIONS**

1. Boring logs shall be prepared on standard forms. Each log shall include the following information:  
 a. Name of project  
 b. Name of engineer  
 c. Date of boring  
 d. Name of boring contractor  
 e. Name of operator  
 f. Name of recorder  
 g. Name of witness  
 h. Name of sampler  
 i. Name of tester  
 j. Name of analyst  
 k. Name of reviewer  
 l. Name of approver  
 m. Name of checker  
 n. Name of printer  
 o. Name of binder  
 p. Name of folder  
 q. Name of file  
 r. Name of cabinet  
 s. Name of room  
 t. Name of building  
 u. Name of street  
 v. Name of city  
 w. Name of state  
 x. Name of country  
 y. Name of continent  
 z. Name of planet

**LEGEND OF EARTH MATERIALS**



1. Gravel  
 2. Sand  
 3. Silt  
 4. Clay  
 5. Organic matter  
 6. Shell material  
 7. Limestone  
 8. Dolomite  
 9. Quartzite  
 10. Gneiss  
 11. Schist  
 12. Metasediment  
 13. Metavolcanic  
 14. Metigneous  
 15. Metamorphic

**CONSISTENCY CLASSIFICATION FOR SOILS**

According to the Standard Penetration Test (SPT) blow count (N<sub>60</sub>) and plasticity index (PI):  
 - Very loose  
 - Loose  
 - Slightly compact  
 - Compact  
 - Very dense

**UNIFIED SOIL CLASSIFICATION SYSTEM**

M: Silty clay  
 CL: Clay  
 OL: Organic clay  
 MH: Silty silt  
 CH: Silt  
 OH: Organic silt  
 ML: Silty sand  
 SW: Sand  
 WL: Silty sand  
 GW: Sand  
 GM: Silty gravel  
 GMG: Organic silty gravel  
 GC: Gravel  
 GWG: Organic gravel

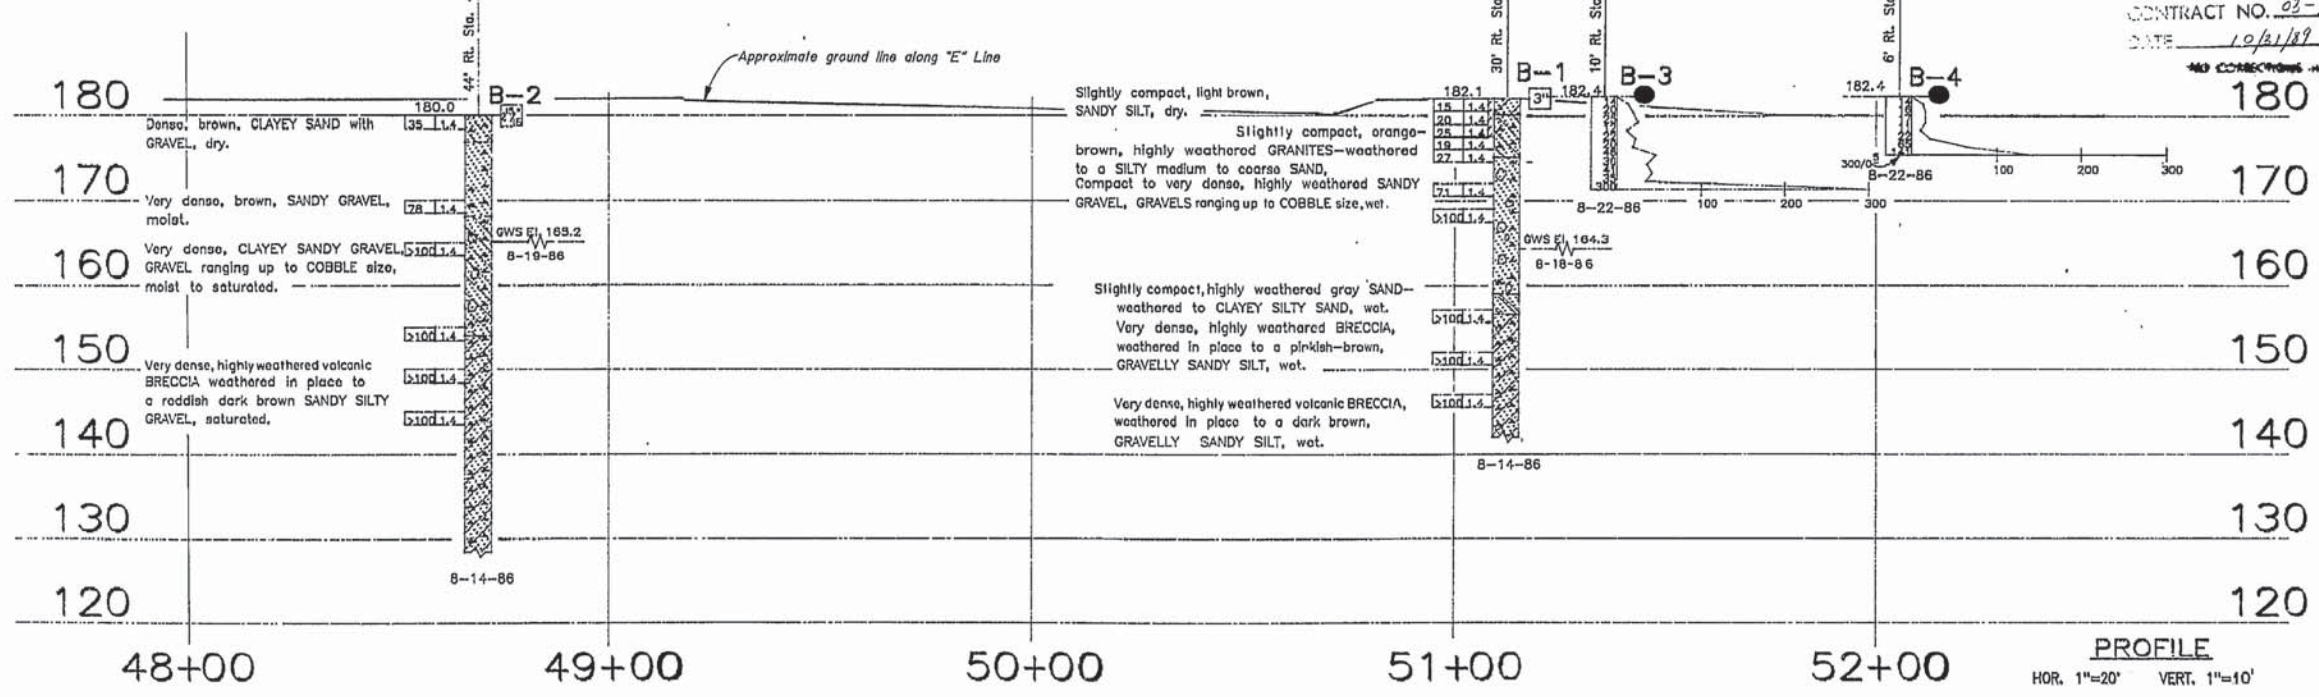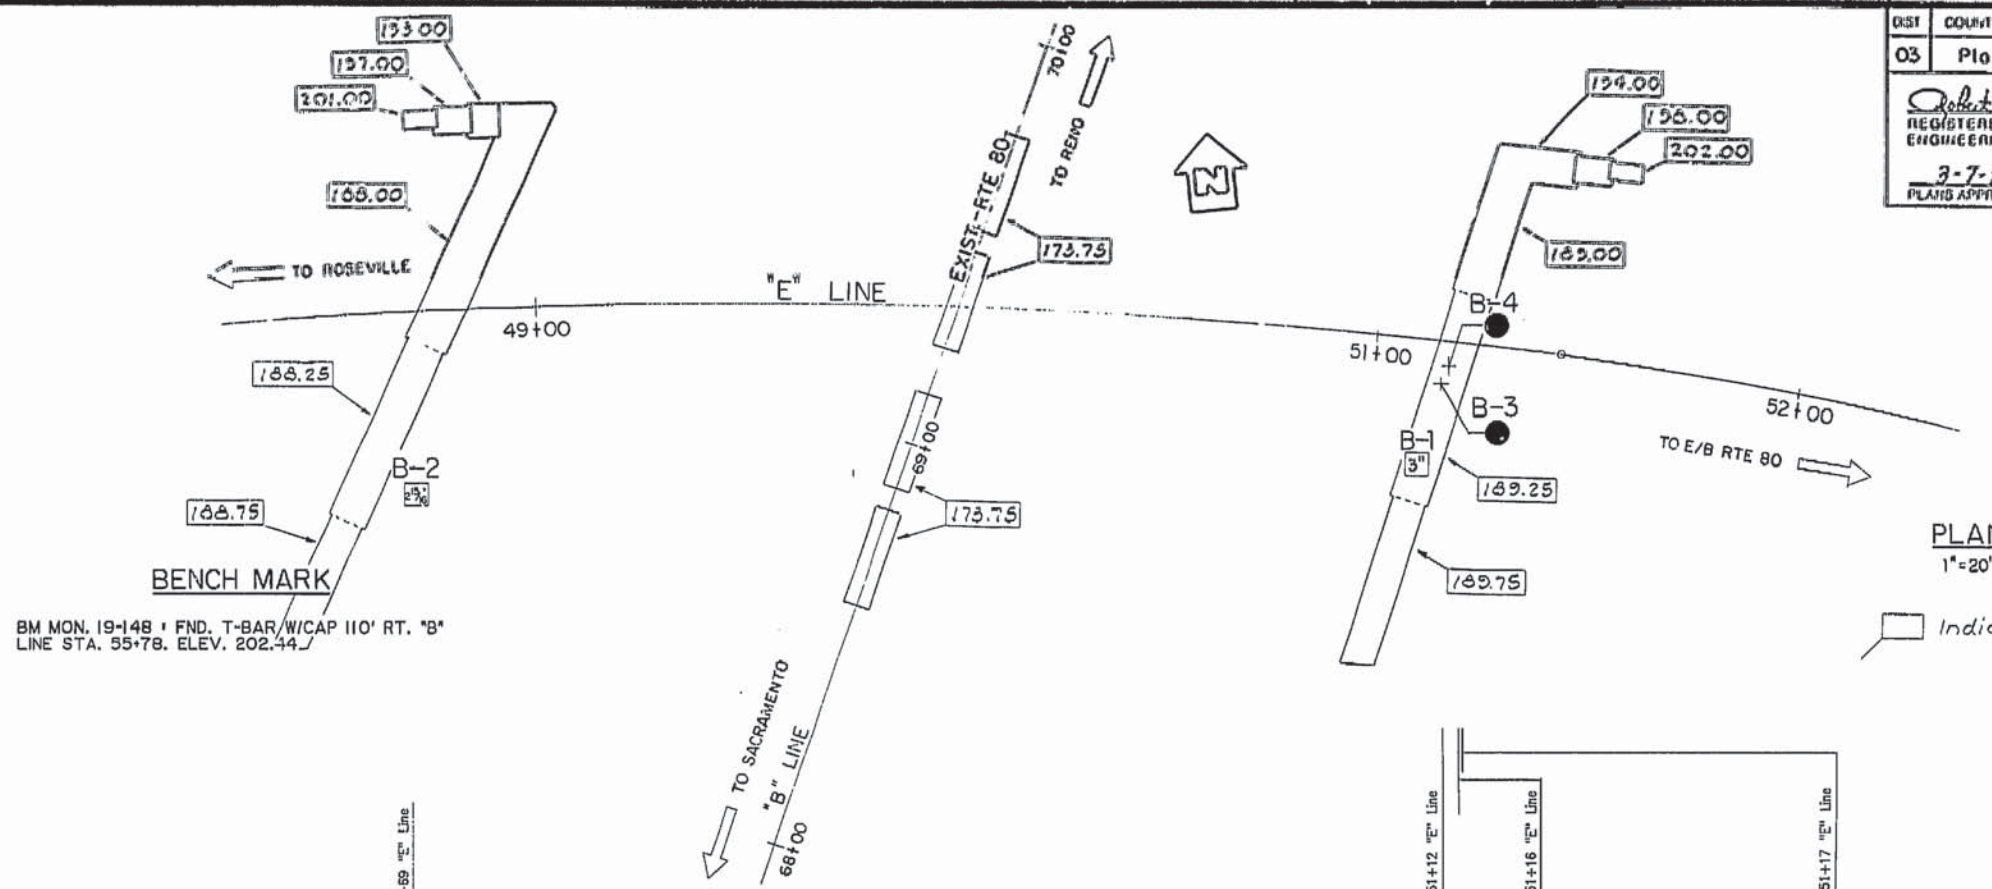

NO CORRECTIONS FOR  
**AS BUILT**  
 CORRECTIONS BY S. HURTHANSON  
 CONTRACT NO. 03-242924  
 DATE 10/11/87 2/27/90

207

<b>GEOTECHNICAL BRANCH - TRANSPORTATION LABORATORY</b>				State of CALIFORNIA DEPARTMENT OF TRANSPORTATION		STRUCTURES - DESIGN II BRIDGE NO. 10-58 POST MILE 3.0		ATLANTIC STREET OVERCROSSING LOG OF TEST BORINGS 1 OF 2	
DRAWN BY: Leony L. Lopez CHECKED BY:	10/85	PROJECT NO. 39099	FEDERAL PROJECT NO. 560	CONTRACT NO. 03-242924	SHEET NO. 18	OF 19	DATE: 12-29-85	BY: [Signature]	TITLE: [Signature]

**AS BUILT PLANS**  
 Contract No. 03-242924  
 Date Completed 12-29-85  
 Document No. \_\_\_\_\_

I HEREBY CERTIFY THAT THIS IS A TRUE AND ACCURATE COPY OF THE ABOVE DOCUMENT TAKEN UNDER MY DIRECTION AND CONTROL ON THIS DATE IN SACRAMENTO, CALIFORNIA PURSUANT TO AUTHORIZATION BY THE DIRECTOR OF TRANSPORTATION.  
 DATE: 10-15-96 BY: [Signature] TITLE: [Signature]





DIST	COUNTY	ROUTE	POST KILOMETERS TOTAL PROJECT	SHEET NO.	TOTAL SHEETS
03	Pla	80		119	152

Elizabeth M. Smith  
 GEOTECHNICAL PROFESSIONAL  
 REGISTERED PROFESSIONAL ENGINEER  
 No. 02373  
 Exp. 6/30/99  
 STATE OF CALIFORNIA

PLANS APPROVAL DATE \_\_\_\_\_  
 KLEINFELDER INC.  
 3077 FITE CIRCLE  
 SACRAMENTO, CA 95827

CITY OF ROSEVILLE  
 ENGINEERING DEPARTMENT  
 316 VERNON ST. ROOM 106  
 ROSEVILLE, CA 95678

The State of California or its officers or agents shall not be responsible for the accuracy or completeness of electronic copies of this plan sheet.

**AS BUILT**  
 CORRECTION BY: *[Signature]*  
 CONTRACT NO.: 03-2A4804  
 DATE: 11-10-00  
 No Changes

**LEGEND OF EARTH MATERIALS**

**LEGEND OF BORINGS**

**LEGEND OF TESTS**

**LEGEND OF SOIL CLASSIFICATION**

**LEGEND OF CLAY AND SILT CLASSIFICATION**

**LEGEND OF SAND AND GRAVEL CLASSIFICATION**

**LEGEND OF GRAVEL CLASSIFICATION**

**LEGEND OF SAND CLASSIFICATION**

**LEGEND OF SILT CLASSIFICATION**

**LEGEND OF CLAY CLASSIFICATION**

**LEGEND OF ORGANIC CLASSIFICATION**

**LEGEND OF SPECIAL CLASSIFICATION**

**LEGEND OF UNDESIRABLE MATERIALS**

**LEGEND OF TESTS**

**LEGEND OF SOIL CLASSIFICATION**

**LEGEND OF CLAY AND SILT CLASSIFICATION**

**LEGEND OF SAND AND GRAVEL CLASSIFICATION**

**LEGEND OF SILT CLASSIFICATION**



**LEGEND OF CLAY CLASSIFICATION**

**LEGEND OF ORGANIC CLASSIFICATION**

**LEGEND OF SPECIAL CLASSIFICATION**

**LEGEND OF UNDESIRABLE MATERIALS**

- Note:**
- 63 mm samples were taken using a modified California split-barrel sampler with an inside diameter of 49 mm and an outside diameter of 63 mm.
  - The boring logs and related information represent the opinion of the geotechnical engineer as to the character of the materials at the locations shown. Soil and groundwater conditions between adjacent test holes and at other locations may differ from those shown. Groundwater conditions may change with passage of time.
  - Test boring elevations are approximate and are interpolated based on topographic base sheet mapping prepared for this project.
  - Test boring locations were determined in the field based on taping and pacing from mapped site features. The locations of the explorations should be considered accurate only to the degree implied by the measuring methods used.
  - An automatic hammer was used to drive sampler.
  - Visual classification of earth materials was based on field inspection and was confirmed or revised with laboratory test results.
  - Benchmark: Mark 19-147-3 (CALTRANS Designation) 1/2" rebar with metal cap in well 240.402 (788.72') LT. B 47+92.10 POT (Interstate 80) "U.S.G.S." Elevation 51.039 (167.45')

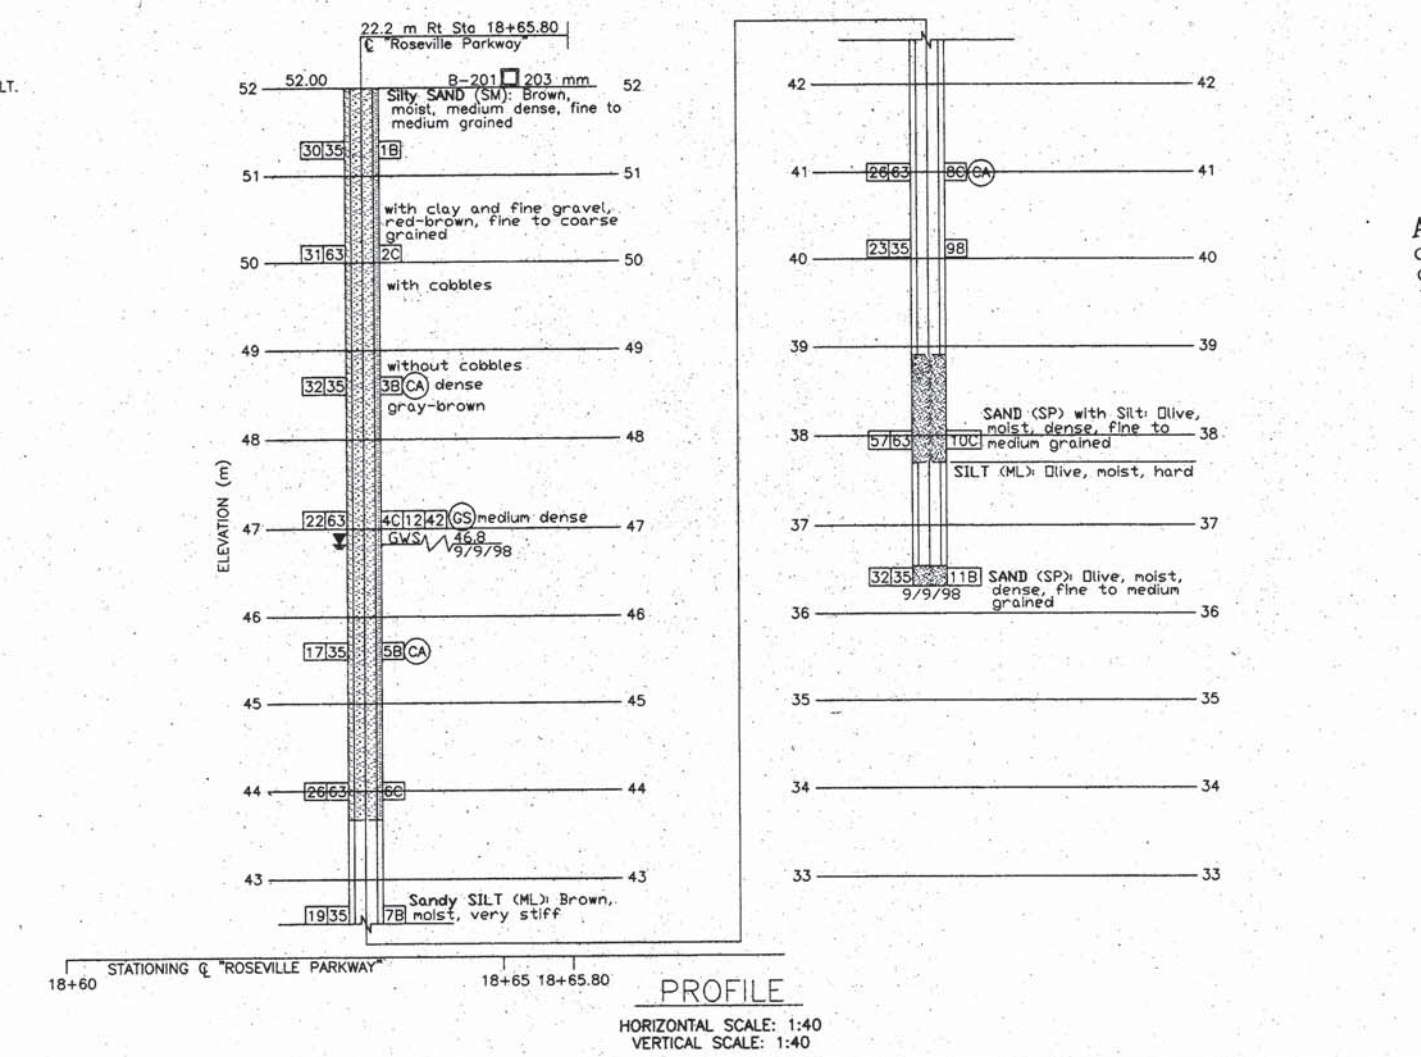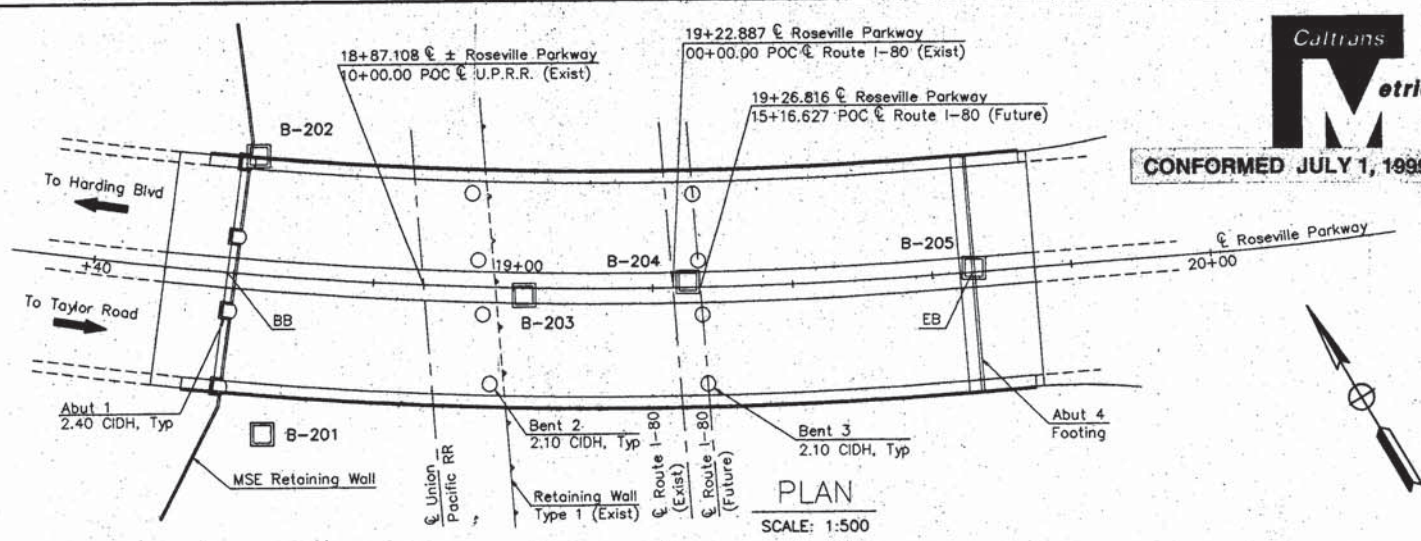

JOEL ESCABAR DESIGN OVERSIGHT 6-18-99	DRAWN BY D. CLENDENEN	L. REAGAN, ENG. FIELD INVESTIGATION BY: DATE: 9/9/98	PREPARED FOR THE <b>STATE OF CALIFORNIA</b> DEPARTMENT OF TRANSPORTATION	Walt LaFranchi PROJECT ENGINEER	BRIDGE NO. 19-0177 POST KM 5.62	<b>ROSEVILLE PARKWAY OVERCROSSING</b> <b>LOG OF TEST BORINGS NO. 1</b>
SIGN OFF DATE	CHECKED BY E.M. SMITH	ORIGINAL SCALE IN CENTIMETERS FOR REDUCED PLANS	0 2 4 6 8	CU 03 EA 2A4801	DISREGARD PRINTS BEARING EARLIER REVISION DATES	REVISION DATES (PRELIMINARY STAGE ONLY) 1/27/99 3/27/99 5/3/99

FILE PATH: 23-483459

SHEET 47 OF 51

DIST	COUNTY	ROUTE	POST KILOMETERS TOTAL PROJECT	SHEET NO.	TOTAL SHEETS
03	Pla	80		120	152

*Elizabeth M. Smith*  
 GEOTECHNICAL PROFESSIONAL  
 No. 22273  
 Exp. 6/30/99  
 STATE OF CALIFORNIA  
 BOARD OF EXAMINERS  
 PROFESSIONAL ENGINEERS

PLANS APPROVAL DATE \_\_\_\_\_  
 KLEINFELDER INC.  
 3077 FITE CIRCLE  
 SACRAMENTO, CA 95827

CITY OF ROSEVILLE  
 ENGINEERING DEPARTMENT  
 316 VERNON ST. ROOM 106  
 ROSEVILLE, CA 95678

The State of California or its officers or agents shall not be responsible for the accuracy or completeness of electronic copies of this plan sheet.


**AS BUILT**  
 CORRECTION BY: *Frank Cull*  
 CONTRACT NO.: *23-2A4804*  
 DATE: *11-10-00*

*No Change*







CONFORMED JULY 1, 1999

- Note:**
- 63 mm samples were taken using a modified California split-barrel sampler with an inside diameter of 49 mm and an outside diameter of 63 mm.
  - The boring logs and related information represent the opinion of the geotechnical engineer as to the character of the materials at the locations shown. Soil and groundwater conditions between adjacent test holes and at other locations may differ from those shown. Groundwater conditions may change with passage of time.
  - Test boring elevations are approximate and are interpolated based on topographic base sheet mapping prepared for this project.
  - Test boring locations were determined in the field based on taping and pacing from mapped site features. The locations of the explorations should be considered accurate only to the degree implied by the measuring methods used.
  - An automatic hammer was used to drive sampler.
  - Visual classification of earth materials was based on field inspection and was confirmed or revised with laboratory test results.
  - Benchmark: Mark 19-147-3 (CALTRANS Designation) 1/2" rebar with metal cap in well 240.402 (788.72) LT. B 47+92.10 POT (Interstate 80) "U.S.G.S." Elevation 51.039 (167.45')

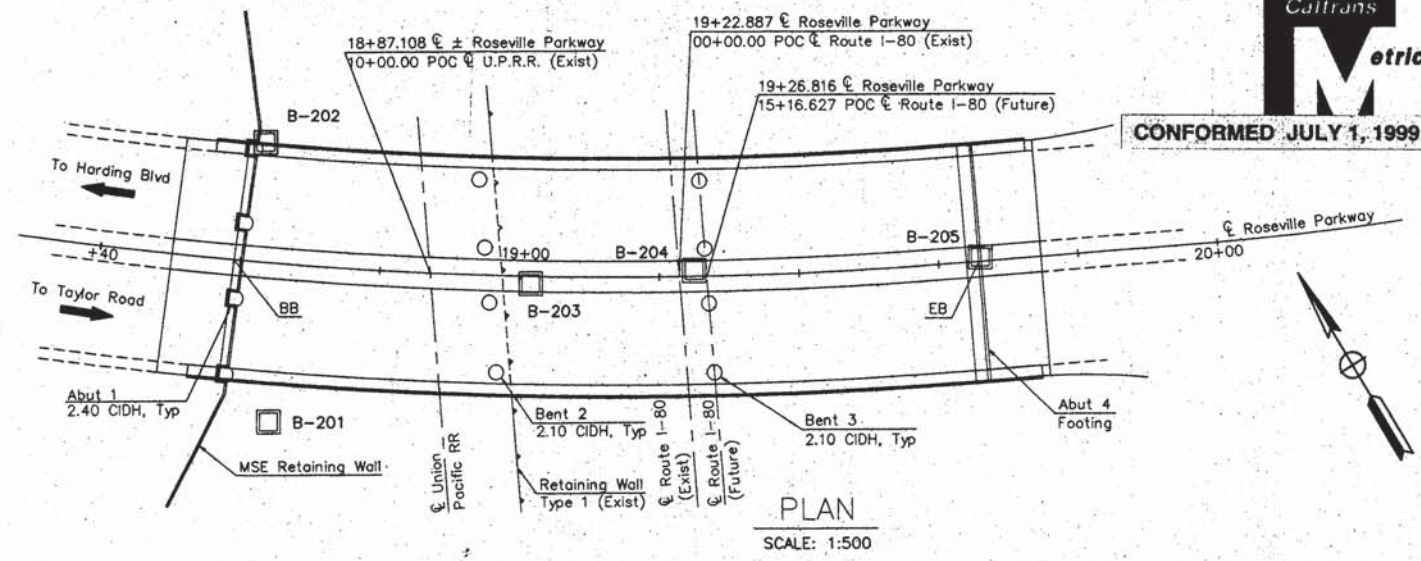

PLAN  
SCALE: 1:500

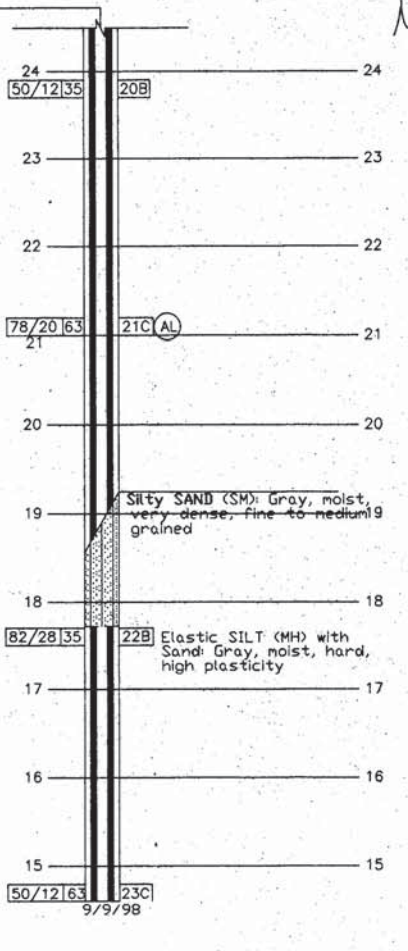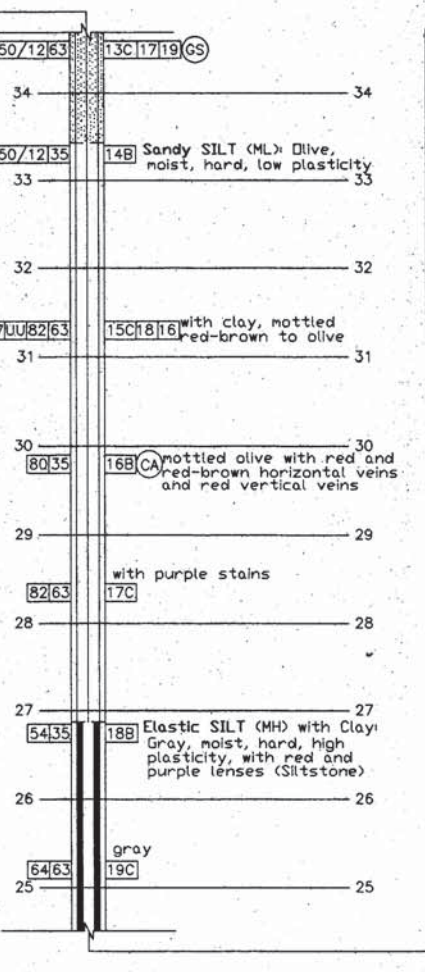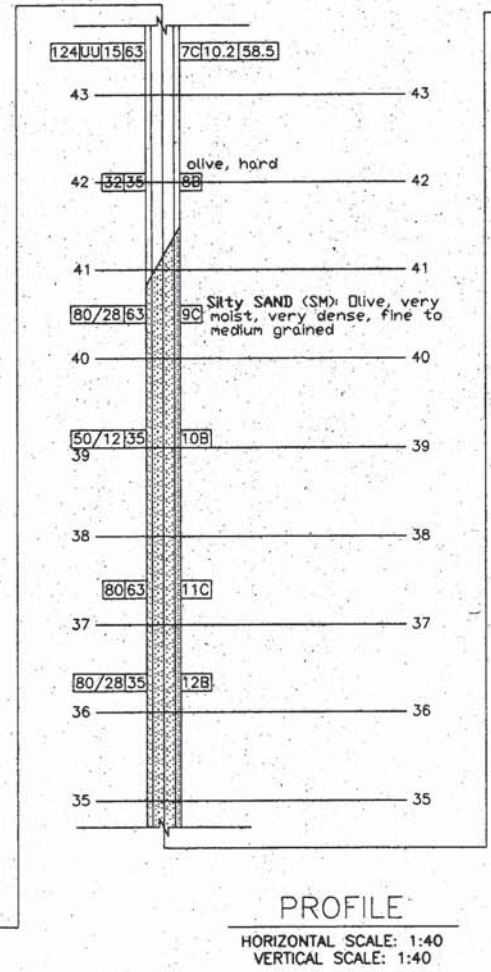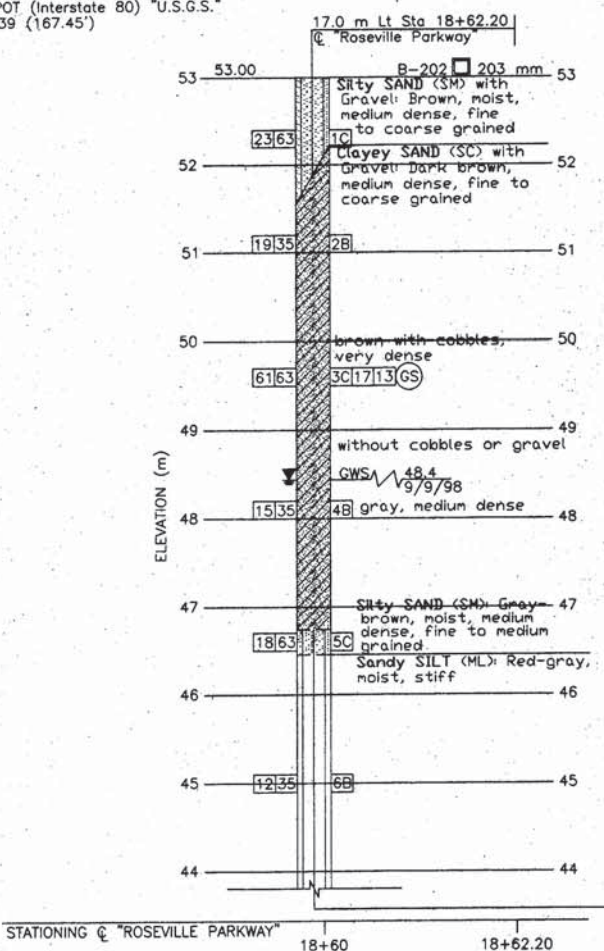

PROFILE  
HORIZONTAL SCALE: 1:40  
VERTICAL SCALE: 1:40

LEGEND OF EARTH MATERIALS

**LEGEND OF EARTH MATERIALS (USCS)**  
 BASED ON ASTM D2487, D2488

**LEGEND OF EARTH MATERIALS (ASTM)**  
 BASED ON ASTM D1546 AND D1586

**LEGEND OF EARTH MATERIALS (ASTM)**  
 BASED ON ASTM D1546 AND D1586

**LEGEND OF EARTH MATERIALS (ASTM)**  
 BASED ON ASTM D1546 AND D1586

RELATIVE DENSITY AND CONSISTENCY CLASSIFICATION SANDS AND GRAVELS	CLAYS AND SILTS
VERY LOOSE LOOSE MEDIUM DENSE DENSE VERY DENSE	VERY SOFT SOFT FIRM STIFF VERY STIFF HARD

JOEL ESCABAR  
 DESIGN OVERSIGHT  
 6-18-99

DRAWN BY: D. CLENDENEN  
 CHECKED BY: E.M. SMITH

L. REAGAN, ENG.  
 FIELD INVESTIGATION BY:  
 DATE: 9/9/98

PREPARED FOR THE  
**STATE OF CALIFORNIA**  
 DEPARTMENT OF TRANSPORTATION

Walt LaFranchi  
 PROJECT ENGINEER

BRIDGE NO.  
19-0177  
POST KM  
5.62

**ROSEVILLE PARKWAY OVERCROSSING**  
**LOG OF TEST BORINGS NO. 2**

FILE PATH: 23-483459	ORIGINAL SCALE IN CENTIMETERS FOR REDUCED PLANS	CU 03 EA 2A4801	DISREGARD PRINTS BEARING EARLIER REVISION DATES	REVISION DATES (PRELIMINARY STAGE ONLY)	SHEET 48 OF 51
----------------------	---	--------------------	---	---	----------------

DIST	COUNTY	ROUTE	POST KILOMETERS TOTAL PROJECT	SHEET NO.	TOTAL SHEETS
03	Plia	80		121	152

Elizabeth M. Smith  
 GEOTECHNICAL PROFESSIONAL  
 No. 62373  
 Exp. 8/30/99  
 STATE OF CALIFORNIA

KLEINFELDER INC.  
 3077 FITE CIRCLE  
 SACRAMENTO, CA 95827

CITY OF ROSEVILLE  
 ENGINEERING DEPARTMENT  
 316 VERNON ST. ROOM 106  
 ROSEVILLE, CA 95678





The State of California or its officers or agents shall not be responsible for the accuracy or completeness of electronic copies of this plan sheet.

**AS BUILT**  
 CORRECTION BY: *[Signature]*  
 CONTRACT NO.: 03-244804  
 DATE: *No Changes*






CONFORMED - JULY 1, 1999



- Note:**
- 63 mm samples were taken using a modified California split-barrel sampler with an inside diameter of 49 mm and an outside diameter of 63 mm.
  - The boring logs and related information represent the opinion of the geotechnical engineer as to the character of the materials at the locations shown. Soil and groundwater conditions between adjacent test holes and at other locations may differ from those shown. Groundwater conditions may change with passage of time.
  - Test boring elevations are approximate and are interpolated based on topographic base sheet mapping prepared for this project.
  - Test boring locations were determined in the field based on toping and pacing from mapped site features. The locations of the explorations should be considered accurate only to the degree implied by the measuring methods used.
  - An automatic hammer was used to drive sampler.
  - Visual classification of earth materials was based on field inspection and was confirmed or revised with laboratory test results.
  - Benchmark: Mark 19-147-3 (CALTRANS Designation) 1/2" rebar with metal cap in well 240.402 (788.72') LT. B 47+92.10 POT (Interstate 80) "U.S.G.S." Elevation 51.039 (167.45')

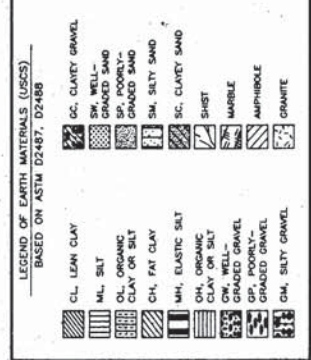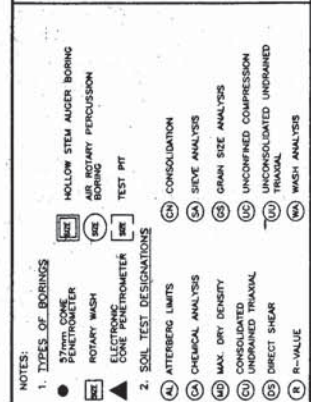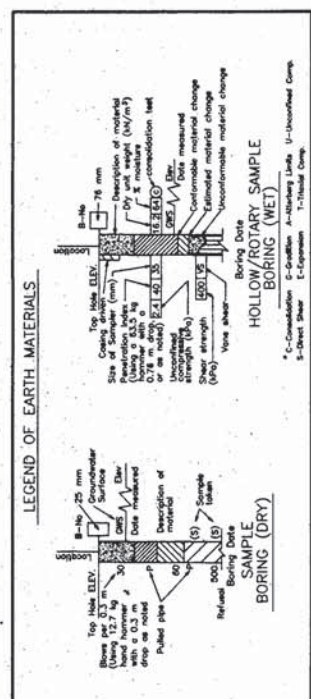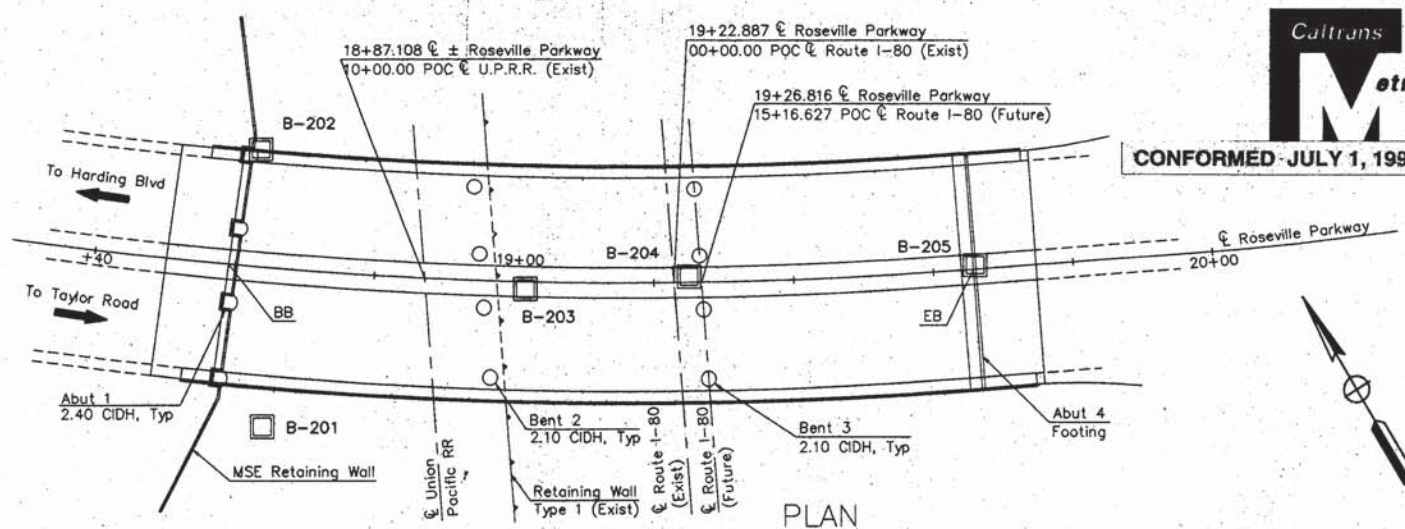

RELATIVE DENSITY AND CONSISTENCY CLASSIFICATION	CLAYS AND SILTS
B.C. - IN ASTM D1586 S.C. - IN ASTM D1586 C.U. - IN ASTM D1586 C.L. - IN ASTM D1586 C.H. - IN ASTM D1586 C.O. - IN ASTM D1586 C.F. - IN ASTM D1586 C.M. - IN ASTM D1586 C.S. - IN ASTM D1586 C.G. - IN ASTM D1586 C.P. - IN ASTM D1586 C.Q. - IN ASTM D1586 C.R. - IN ASTM D1586 C.T. - IN ASTM D1586 C.V. - IN ASTM D1586 C.W. - IN ASTM D1586 C.X. - IN ASTM D1586 C.Y. - IN ASTM D1586 C.Z. - IN ASTM D1586	C.C. - IN ASTM D1586 C.O. - IN ASTM D1586 C.M. - IN ASTM D1586 C.S. - IN ASTM D1586 C.G. - IN ASTM D1586 C.P. - IN ASTM D1586 C.Q. - IN ASTM D1586 C.R. - IN ASTM D1586 C.T. - IN ASTM D1586 C.V. - IN ASTM D1586 C.W. - IN ASTM D1586 C.X. - IN ASTM D1586 C.Y. - IN ASTM D1586 C.Z. - IN ASTM D1586

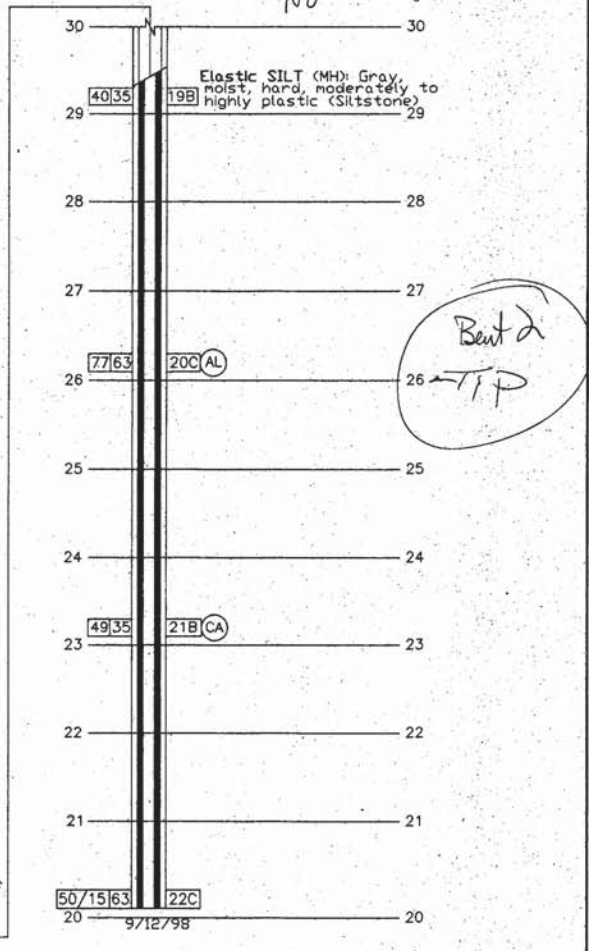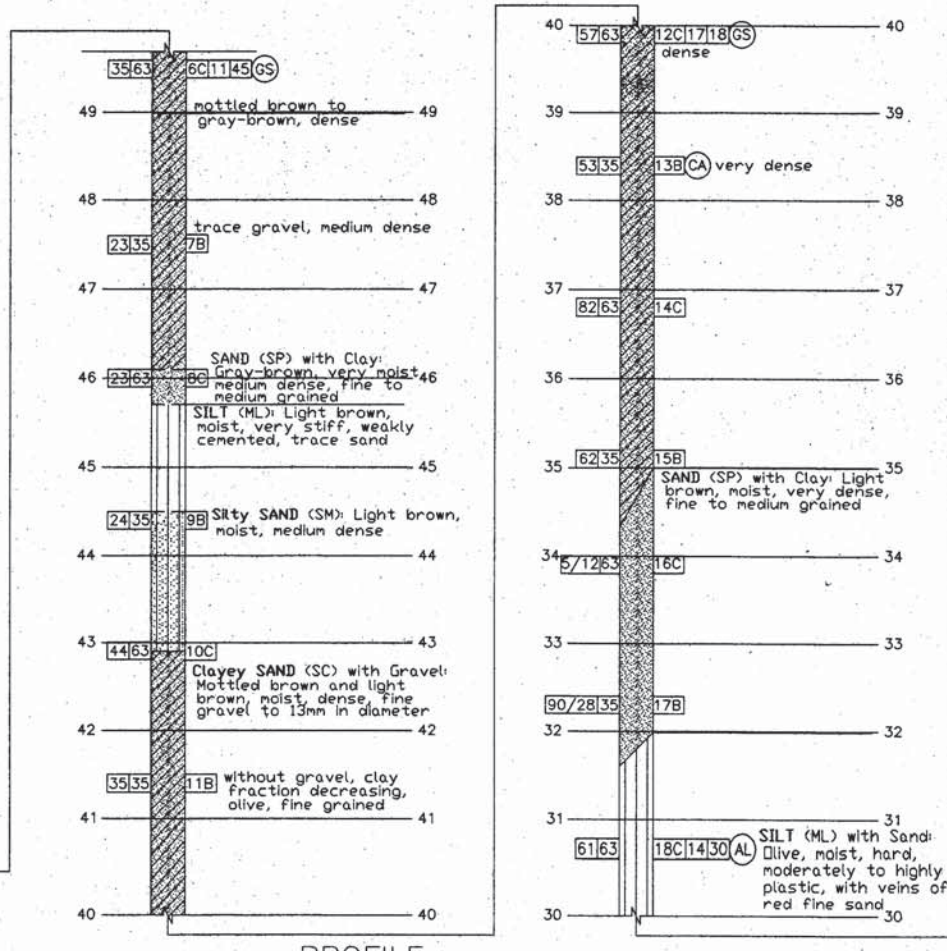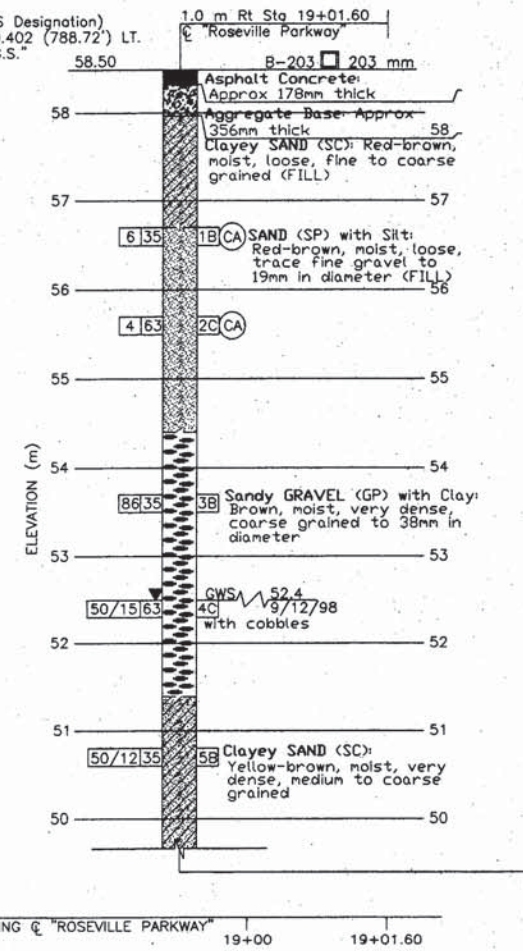






JOEL ESCABAR DESIGN OVERSIGHT 6-18-99	DRAWN BY: D. CLENDENEN CHECKED BY: E.M. SMITH	L. REAGAN, ENG. FIELD INVESTIGATION BY: DATE: 9/12/98	PREPARED FOR THE <b>STATE OF CALIFORNIA</b> DEPARTMENT OF TRANSPORTATION Wait LaFranchi PROJECT ENGINEER	BRIDGE NO. 19-0177 POST KM 5.62	<b>ROSEVILLE PARKWAY OVERCROSSING</b> <b>LOG OF TEST BORINGS NO. 3</b>
FILE PATH: 23-483459	ORIGINAL SCALE IN CENTIMETERS FOR REDUCED PLANS: 0 2 4 6 8	CU 03 EA 2A4801	DISREGARD PRINTS BEARING EARLIER REVISION DATES	REVISION DATES (PRELIMINARY STAGE ONLY) 1/27/99 3/27/99 5/5/99	SHEET OF 49 51

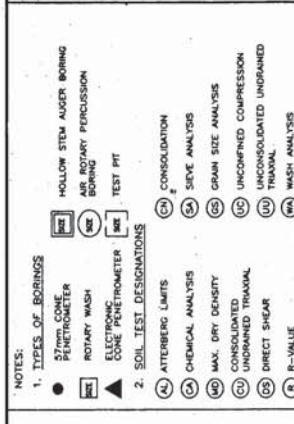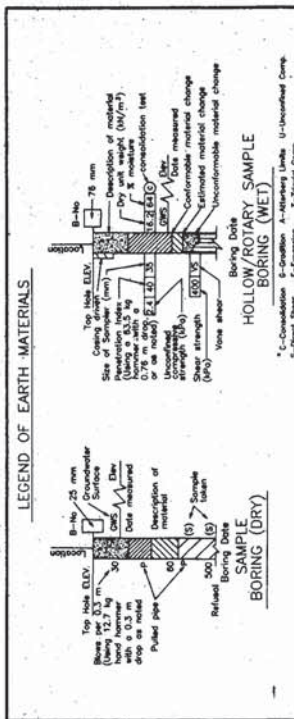

RELATIVE DENSITY AND CONSISTENCY CLASSIFICATION	CLAYS AND SILTS																				
<table border="1"> <tr><td>VERY LOOSE</td><td>0 - 4</td></tr> <tr><td>LOOSE</td><td>5 - 10</td></tr> <tr><td>MEDIUM DENSE</td><td>11 - 20</td></tr> <tr><td>DENSE</td><td>21 - 30</td></tr> <tr><td>VERY DENSE</td><td>31 - 50</td></tr> </table>	VERY LOOSE	0 - 4	LOOSE	5 - 10	MEDIUM DENSE	11 - 20	DENSE	21 - 30	VERY DENSE	31 - 50	<table border="1"> <tr><td>VERY SOFT</td><td>&lt; 2</td></tr> <tr><td>SOFT</td><td>2 - 4</td></tr> <tr><td>STIFF</td><td>4 - 15</td></tr> <tr><td>VERY STIFF</td><td>15 - 30</td></tr> <tr><td>HARD</td><td>OVER 30</td></tr> </table>	VERY SOFT	< 2	SOFT	2 - 4	STIFF	4 - 15	VERY STIFF	15 - 30	HARD	OVER 30
VERY LOOSE	0 - 4																				
LOOSE	5 - 10																				
MEDIUM DENSE	11 - 20																				
DENSE	21 - 30																				
VERY DENSE	31 - 50																				
VERY SOFT	< 2																				
SOFT	2 - 4																				
STIFF	4 - 15																				
VERY STIFF	15 - 30																				
HARD	OVER 30																				

- Note:**
- 63 mm samples were taken using a modified California split-barrel sampler with an inside diameter of 49 mm and an outside diameter of 63 mm.
  - The boring logs and related information represent the opinion of the geotechnical engineer as to the character of the materials at the locations shown. Soil and groundwater conditions between adjacent test holes and at other locations may differ from those shown. Groundwater conditions may change with passage of time.
  - Test boring elevations are approximate and are interpolated based on topographic base sheet mapping prepared for this project.
  - Test boring locations were determined in the field based on taping and pacing from mapped site features. The locations of the explorations should be considered accurate only to the degree implied by the measuring methods used.
  - An automatic hammer was used to drive sampler.
  - Visual classification of earth materials was based on field inspection and was confirmed or revised with laboratory test results.
  - Benchmark: Mark 19-147-3 (CALTRANS Designation) 1/2" rebar with metal cap in well 240.402 (788.72') LT. B 47+92.10 POT (Interstate 80) "U.S.G.S." Elevation 51.039 (167.45')

**AS BUILT**  
 CORRECTION BY: *Paul Lull*  
 CONTRACT NO.: *03-2A4804*  
 DATE: *11-10-00*  
*No Changes*

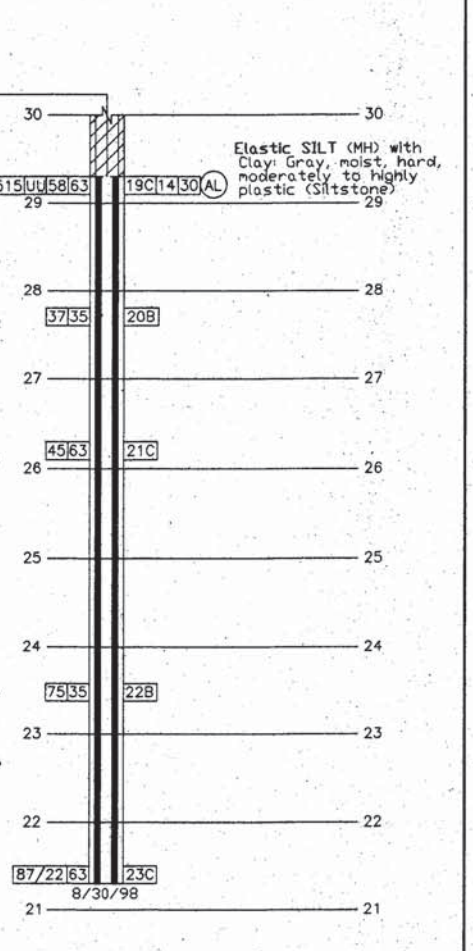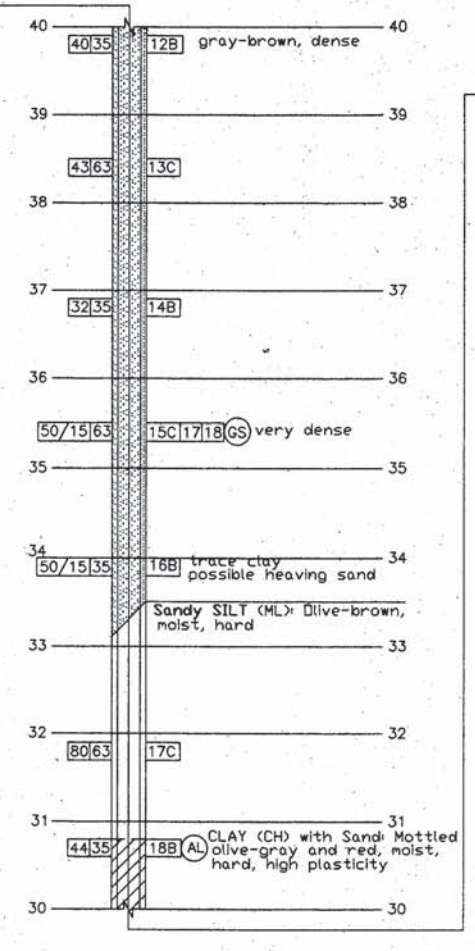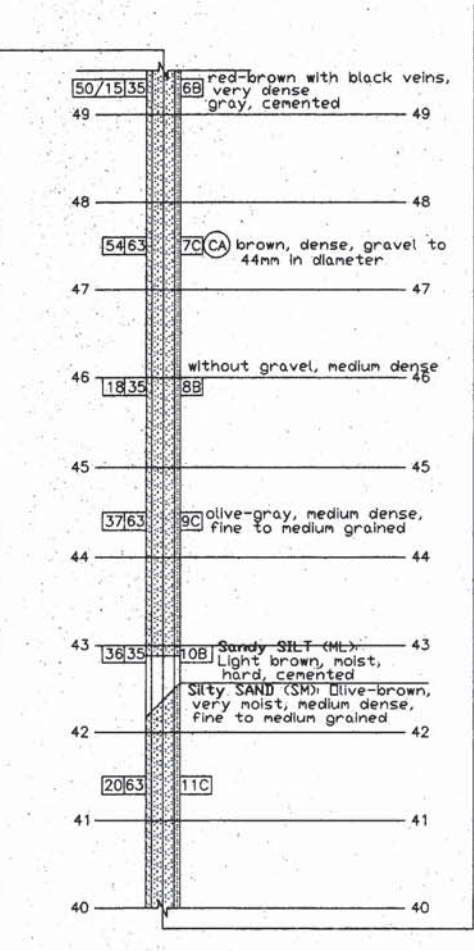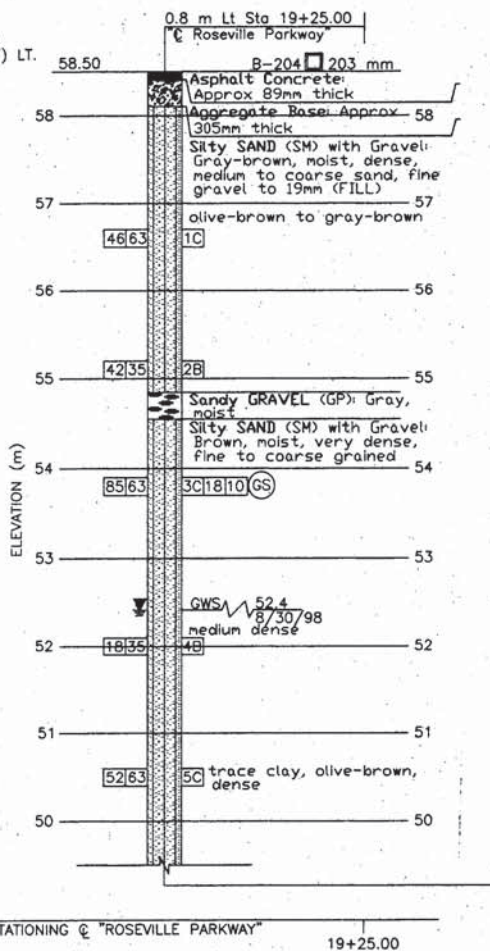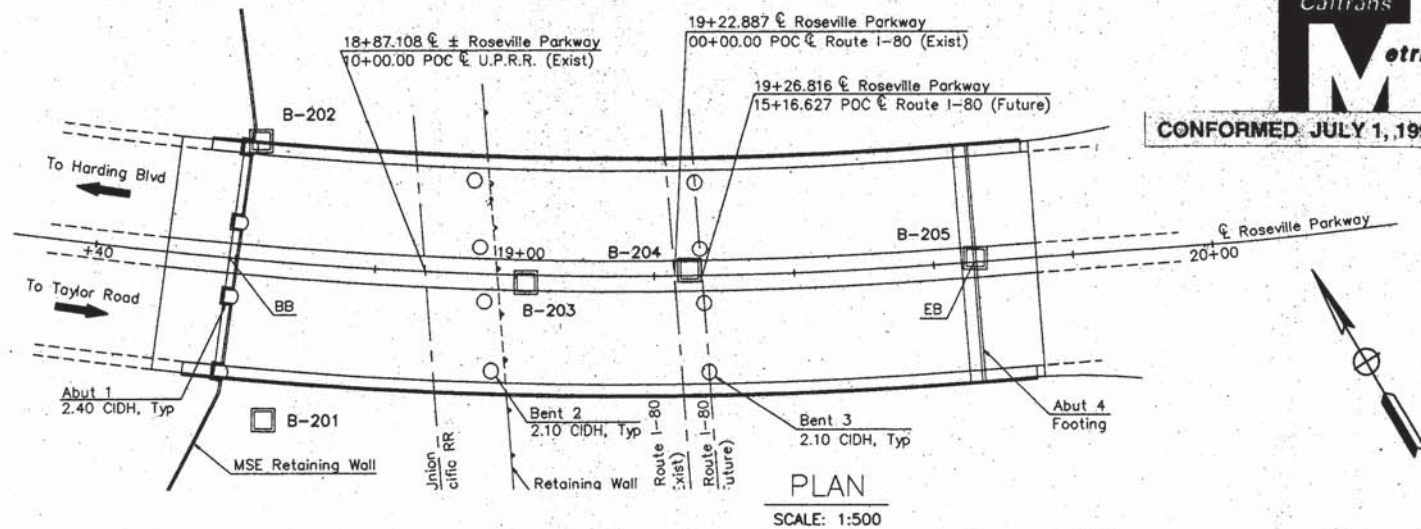

CONFORMED JULY 1, 1999

DIST	COUNTY	ROUTE	POST KILOMETERS TOTAL PROJECT	SHEET NO.	TOTAL SHEETS
03	Pls	80		122	152

Elizabeth M. Smith  
 GEOTECHNICAL PROFESSIONAL  
 KLEINFELDER INC.  
 3077 FITE CIRCLE  
 SACRAMENTO, CA 95827  
 CITY OF ROSEVILLE  
 ENGINEERING DEPARTMENT  
 316 VERNON ST. ROOM 106  
 ROSEVILLE, CA 95678

The State of California or its officers or agents shall not be responsible for the accuracy or completeness of electronic copies of this plan sheet.

JOEL ESCABAR DESIGN OVERSIGHT DATE: 6-18-99	DRAWN BY: D. CLENDENEN CHECKED BY: E.M. SMITH	L. REAGAN, ENG. FIELD INVESTIGATION BY: DATE: 8/30/98	PREPARED FOR THE <b>STATE OF CALIFORNIA</b> DEPARTMENT OF TRANSPORTATION	Walt LaFranchi PROJECT ENGINEER	BRIDGE NO. 19-0177 POST KM 5.62	<b>ROSEVILLE PARKWAY OVERCROSSING</b> <b>LOG OF TEST BORINGS NO. 4</b>
FILE PATH: 23-483459	ORIGINAL SCALE IN CENTIMETERS FOR REDUCED PLANS	0 2 4 6 8	CU 03 EA 2A4801	DISREGARD PRINTS BEARING EARLIER REVISION DATES	REVISION DATES (PRELIMINARY STAGE ONLY) 1/2/99 3/2/99 5/5/99	SHEET OF 50 51



DIST	COUNTY	ROUTE	POST KILOMETERS TOTAL PROJECT	SHEET NO.	TOTAL SHEETS
03	Pla	80		123	152

Robert M. Smith  
 GEOTECHNICAL PROFESSIONAL  
 No. 62217  
 Exp. 8/30/99  
 STATE OF CALIFORNIA  
 PROFESSIONAL SEAL


PLANS APPROVAL DATE  
 KLEINFELDER INC.  
 3077 FITE CIRCLE  
 SACRAMENTO, CA 95827

CITY OF ROSEVILLE  
 ENGINEERING DEPARTMENT  
 316 VERNON ST. ROOM 106  
 ROSEVILLE, CA 95678



The State of California or its officers or agents shall not be responsible for the accuracy or completeness of electronic copies of this plan sheet.

**AS BUILT**  
 CORRECTION BY: *[Signature]*  
 CONTRACT NO.: 03-2A4804  
 DATE: 11-10-07

*No Changes*

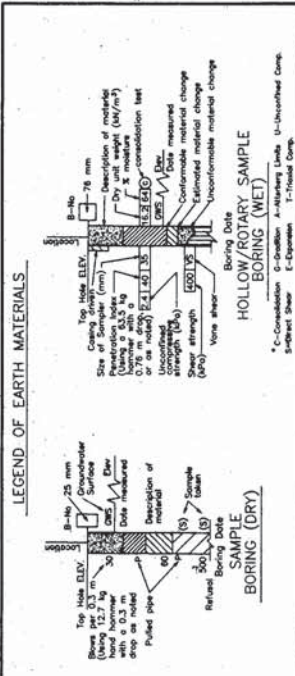

- Note:**
- 63 mm samples were taken using a modified California split-barrel sampler with an inside diameter of 49 mm and an outside diameter of 63 mm.
  - The boring logs and related information represent the opinion of the geotechnical engineer as to the character of the materials at the locations shown. Soil and groundwater conditions between adjacent test holes and at other locations may differ from those shown. Groundwater conditions may change with passage of time.
  - Test boring elevations are approximate and are interpolated based on topographic base sheet mapping prepared for this project.
  - Test boring locations were determined in the field based on taping and pacing from mapped site features. The locations of the explorations should be considered accurate only to the degree implied by the measuring methods used.
  - An automatic hammer was used to drive sampler.
  - Visual classification of earth materials was based on field inspection and was confirmed or revised with laboratory test results.
  - Benchmark: Mark 19-147-3 (CALTRANS Designation) 1/2" rebar with metal cap in well 240.402 (788.72') LT. B 47+92.10 POT (Interstate 80) "U.S.G.S." Elevation 51.039 (167.45')

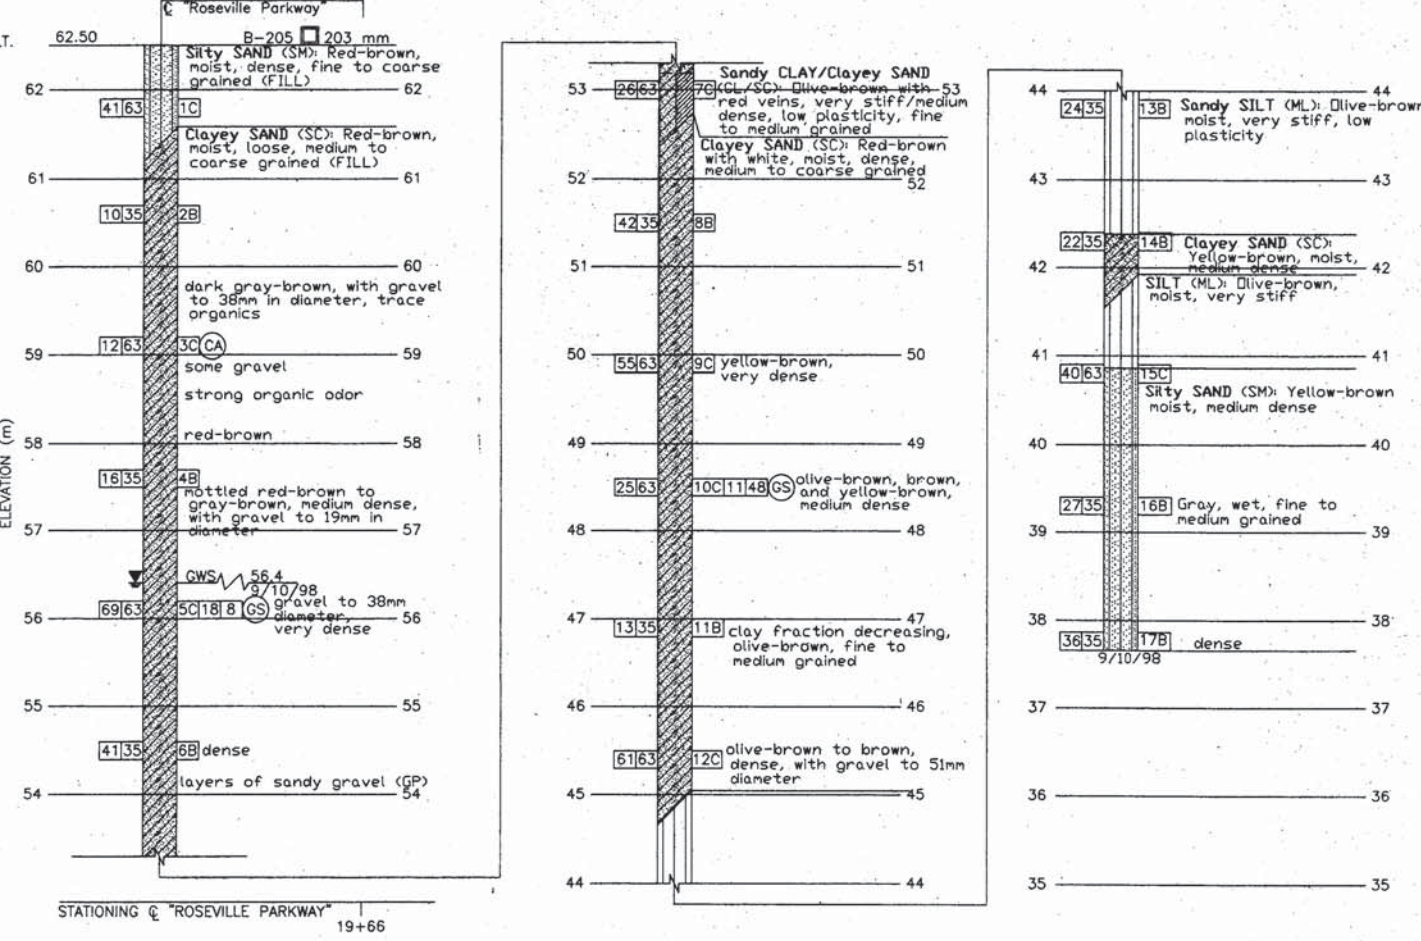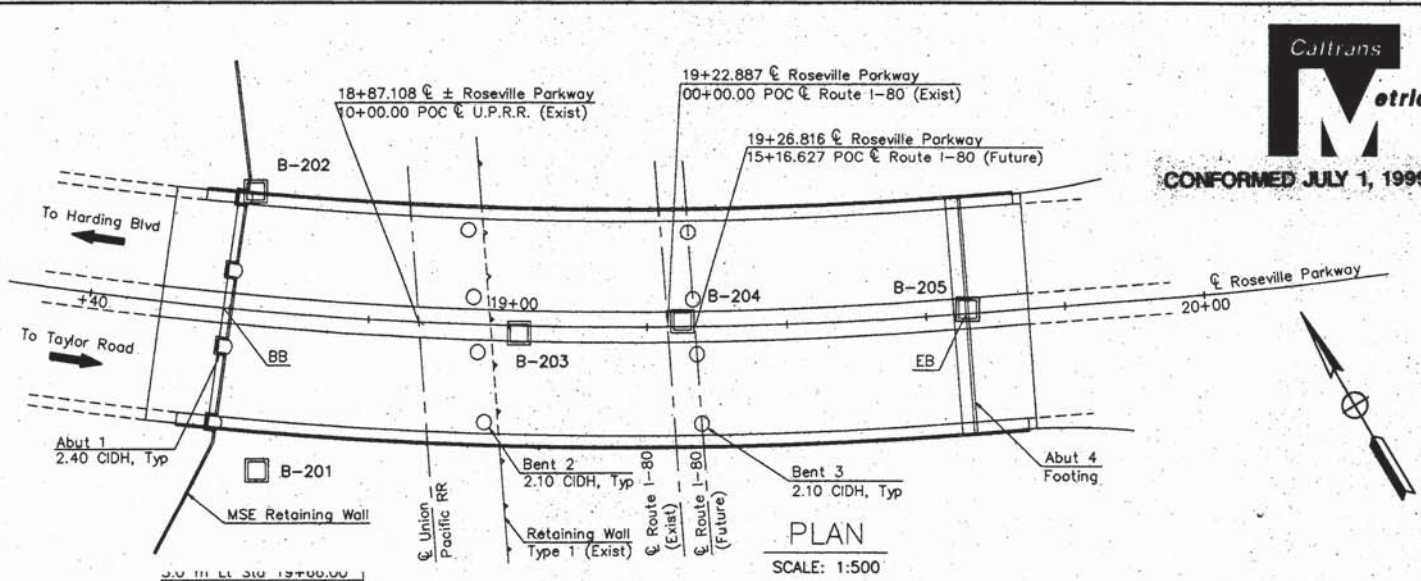

JOEL ESCABAR DESIGN OVERSIGHT SIGN OFF DATE: 6-18-99	DRAWN BY: D. CLENDENEN CHECKED BY: E.M. SMITH	L. REAGAN, ENG. FIELD INVESTIGATION BY: DATE: 9/10/98	PREPARED FOR THE <b>STATE OF CALIFORNIA</b> DEPARTMENT OF TRANSPORTATION Walt LaFranchi PROJECT ENGINEER	BRIDGE NO. 19-0177 POST KM 5.62	<b>ROSEVILLE PARKWAY OVERCROSSING</b> <b>LOG OF TEST BORINGS NO. 5</b>	REVISION DATES (PRELIMINARY STAGE ONLY) 1/27/99, 3/27/99, 5/5/99	SHEET OF 51 51
--	--	---	--	--	---	---	-------------------

FILE PATH: 23-483459

ORIGINAL SCALE IN CENTIMETERS FOR REDUCED PLANS

CU 03  
EA 2A4801

DISREGARD PRINTS BEARING EARLIER REVISION DATES










DIST	COUNTY	ROUTE	KILOMETER POST TOTAL PROJECT	SHEET No	TOTAL SHEETS
03	Plac	80	4.5/8.3	477	539

5-14-08  
 REGISTERED CIVIL ENGINEER  
 11-17-08  
 PLANS APPROVAL DATE  
 The State of California or its officers or agents shall not be responsible for the accuracy or completeness of electronic copies of this plan sheet.  
 KLEINFELDER INC.  
 3077 FITE CIR.  
 SACRAMENTO, CA 95826

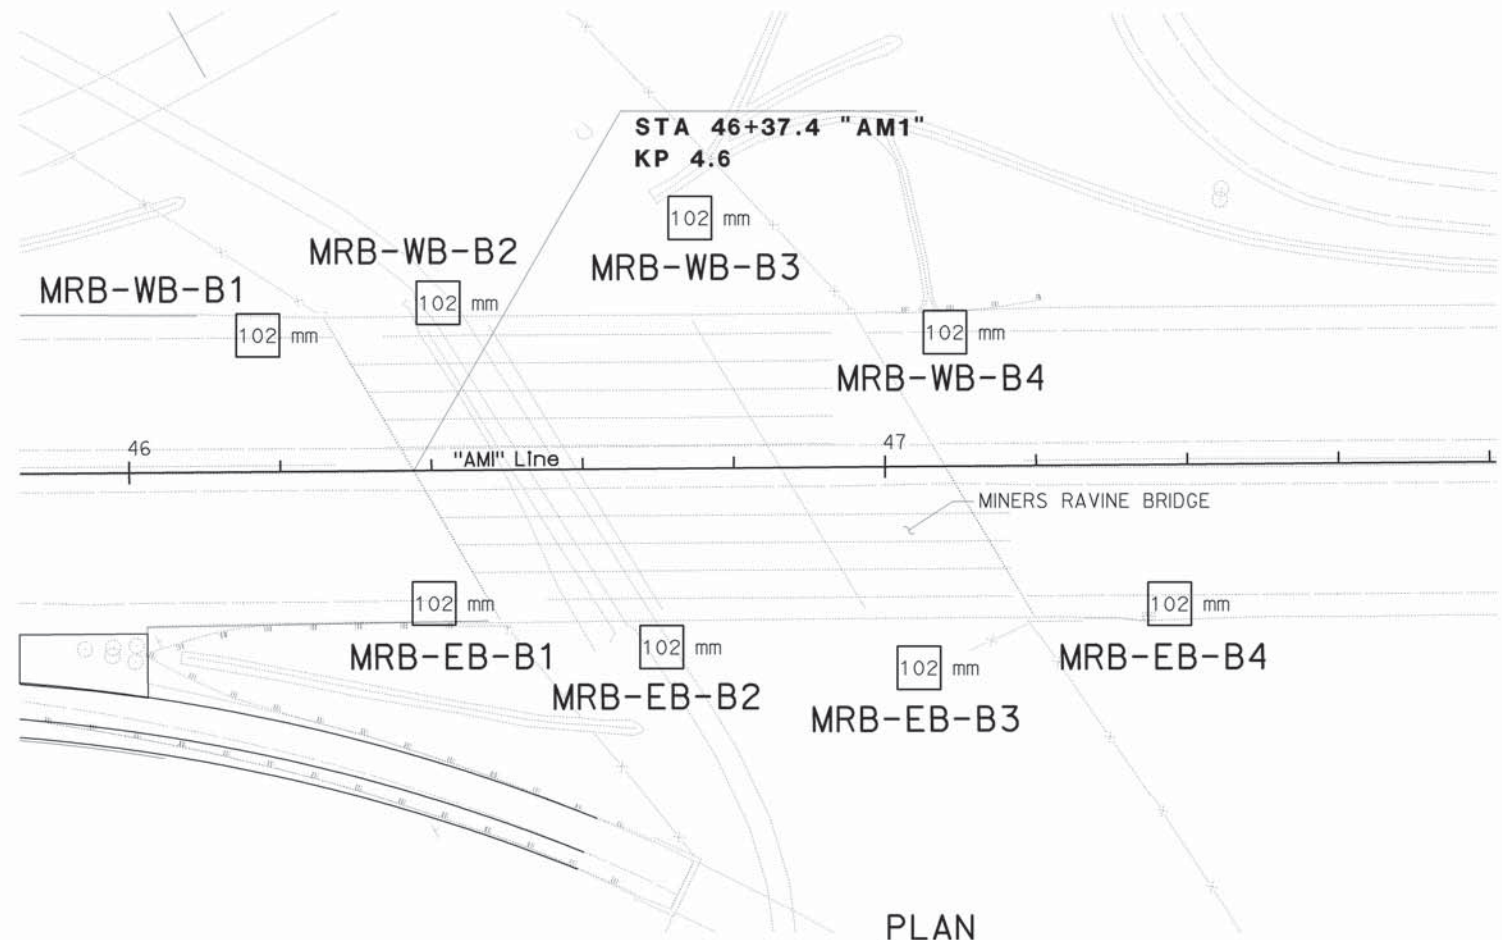

PLAN  
1:500

**LEGEND OF BORING OPERATIONS**

**ELECTRONIC CONE PENETROMETER TEST**  
 Cone Penetrometer (dimensions and testing standards as shown on drawings)

**57 mm CONE PENETRATION BORING**  
 No. count recorded  
 No. count corrected  
 Blowing rate in seconds per 300 mm  
 MB 100 permeability number (if applicable)

**ROTARY SAMPLE BORING (WET)**  
 Description of material  
 Size of sample (mm)  
 Location of sample (mm)  
 Shear strength (kPa)  
 Vane shear (kPa)

**SAMPLE BORING (DRY)**  
 Description of material  
 Size of sample (mm)  
 Location of sample (mm)

**LEGEND OF EARTH MATERIALS**

**CONSISTENCY CLASSIFICATION FOR SOILS**  
 According to the Standard Penetration Test

**LEGEND OF EARTH MATERIALS**  
 CLAYEY SILT  
 FEAT and/or ORGANIC MATTER  
 SAND  
 SILT  
 CLAY  
 SANDY CLAY or CLAYEY SAND  
 SANDY SILT or SILTY SAND  
 SILTY CLAY  
 COBBLE  
 LIMONITE ROCK  
 SEDIMENTARY ROCK  
 METAMORPHIC

Notes:

- 51 mm samples were taken using a California split-barrel sampler with an inside diameter (I.D.) of 51 mm and an outside diameter (O.D.) of 64 mm.
- A CME automatic hammer (63.5 kg) with a 760 mm drop was used to advance the sampler.
- Blowcounts noted for boring are field blowcounts and have not been corrected.
- 35 mm samples were taken using a SPT split-barrel sampler with an inside diameter (I.D.) of 35 mm and an outside diameter (O.D.) of 51 mm.
- 63.5 mm core samples were taken using an HQ core sampler with a 63.5 mm inside diameter (I.D.) and 94 mm outside diameter (O.D.) core barrel.
- Blowcounts 50/125 means 50 blows per 125 mm penetration.
- Efficiency factor for CME automatic hammer is 1.1.
- Borings were drilled with Rotary wash method. Groundwater not measured in borehole.
- The descriptions and classifications of soil, including consistency and relative density descriptions, used by the field personnel for the exploration bore holes on "Soil and Rock Logging Classification Manual (Field Guide)", Engineering Service Center, Office of Structural Foundations, August 1996.

BENCHMARKS

STATION	OFFSET	N	E	ELEV	DESCRIPTION
15+79.190	4.62 Rt	618564.792	2062442.621	44.552	

SURVEY CONTROL

- Coordinates bearing and distances are based on the California coordinate system of Nad 1983 HPGN, zone 6. (EPOCH 1991.35). Elevations are based on NGVD 29.

Mark Stanley DESIGN OVERSIGHT 05/14/08 SIGN OFF DATE	DRAWN BY A. Sanchez	CHECKED BY B. Anderson/ M. Stanley	FIELD INVESTIGATION BY: DATE:	BRIDGE NO. 19-0056	KILOMETER POST 4.6	MINERS RAVINE BRIDGE (WIDEN) LOG OF TEST BORINGS 1 OF 5
---	------------------------	---------------------------------------	----------------------------------	-----------------------	-----------------------	--



FILE => 19-0056-x-lotb1of5.dgn  
 USERNAME => s135318 DATE PLOTTED => 21-NOV-2008 TIME PLOTTED => 15:31






DIST	COUNTY	ROUTE	KILOMETER POST TOTAL PROJECT	SHEET No	TOTAL SHEETS
03	Plg	80	4.5/8.3	479	539

5-14-08  
 REGISTERED CIVIL ENGINEER  
 11-17-08  
 PLANS APPROVAL DATE  
 The State of California or its officers or agents shall not be responsible for the accuracy or completeness of electronic copies of this plan sheet.  
 KLEINFELDER INC.  
 3077 FITE CIR.  
 SACRAMENTO, CA 95826

FOR PLAN VIEW AND ADDITIONAL NOTES, SEE "LOG OF TEST BORINGS" SHEET 1 OF 5

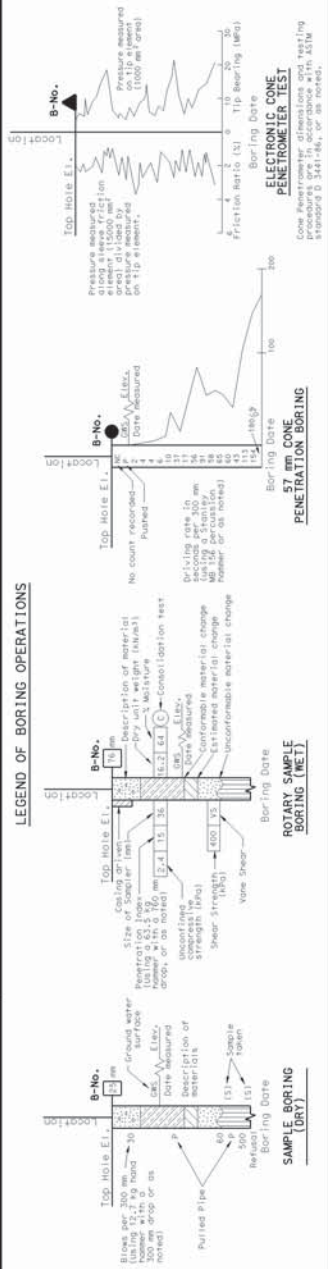


**LEGEND OF EARTH MATERIALS**

GRAVEL	CLAYEY SILT
SAND	PEAT and/or ORGANIC MATTER
SILT	FILL MATERIAL
CLAY	COBBLE
SANDY CLAY or CLAYEY SAND	IGNEOUS ROCK
SANDY SILT or SILTY SAND	SEDIMENTARY ROCK
SILTY CLAY	METAMORPHIC

**CONSISTENCY CLASSIFICATION FOR SOILS**

SPT	Flow Value	Consistency
0-4	Very Loose	Very Soft
5-10	Loose	Soft
11-20	Medium Dense	Firm
31-50	Dense	Stiff
51-100	Very Dense	Very Stiff
>100		Hard

NOTE: Classification of earth material as shown on this sheet is based upon field inspection and is not to be construed to imply mechanical analysis.

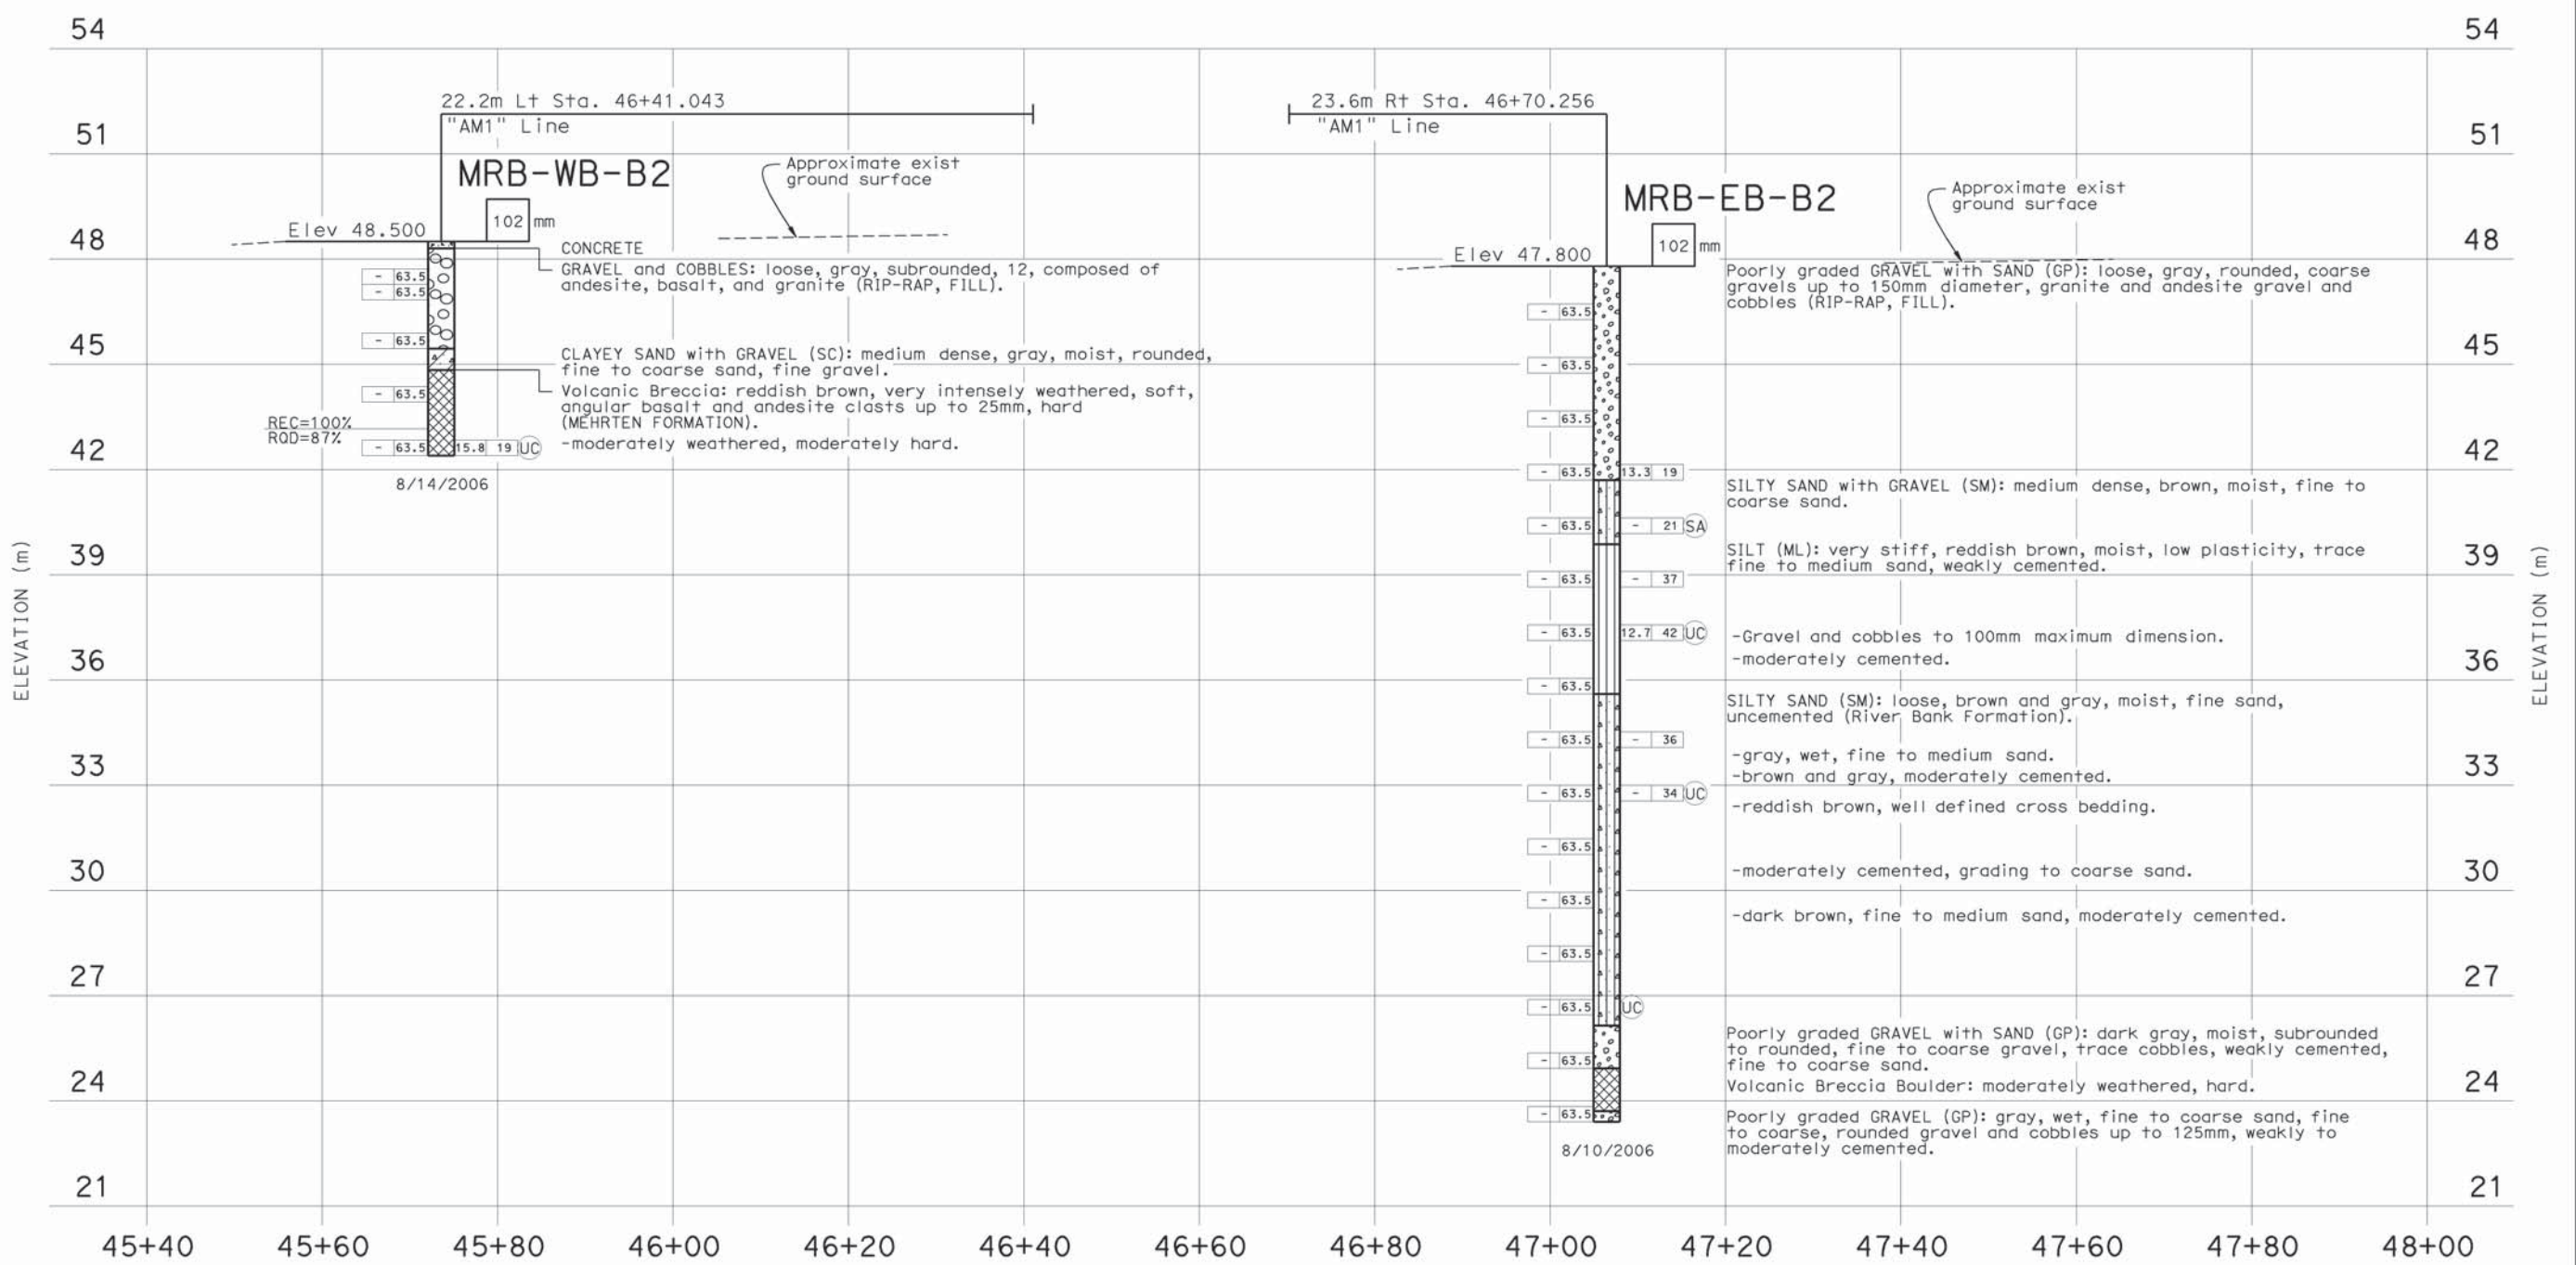

PROFILE  
 HOR. 1:400  
 VER. 1:100

Mark Stanley DESIGN OVERSIGHT 05/14/08 SIGN OFF DATE	DRAWN BY A. Sanchez	FIELD INVESTIGATION BY: DATE:	BRIDGE NO. 19-0056	MINERS RAVINE BRIDGE (WIDEN)
	CHECKED BY B. Anderson/ M. Stanley		PROJECT ENGINEER	LOG OF TEST BORINGS 3 OF 5
			DEPARTMENT OF TRANSPORTATION	




DIST	COUNTY	ROUTE	KILOMETER POST TOTAL PROJECT	SHEET No	TOTAL SHEETS
03	Plg	80	4.5/8.3	480	539

5-14-08  
 REGISTERED CIVIL ENGINEER  
 11-17-08  
 PLANS APPROVAL DATE  
 The State of California or its officers or agents shall not be responsible for the accuracy or completeness of electronic copies of this plan sheet.



KLEINFELDER INC.  
 3077 FITE CIR.  
 SACRAMENTO, CA 95826

FOR PLAN VIEW AND ADDITIONAL NOTES, SEE "LOG OF TEST BORINGS" SHEET 1 OF 5

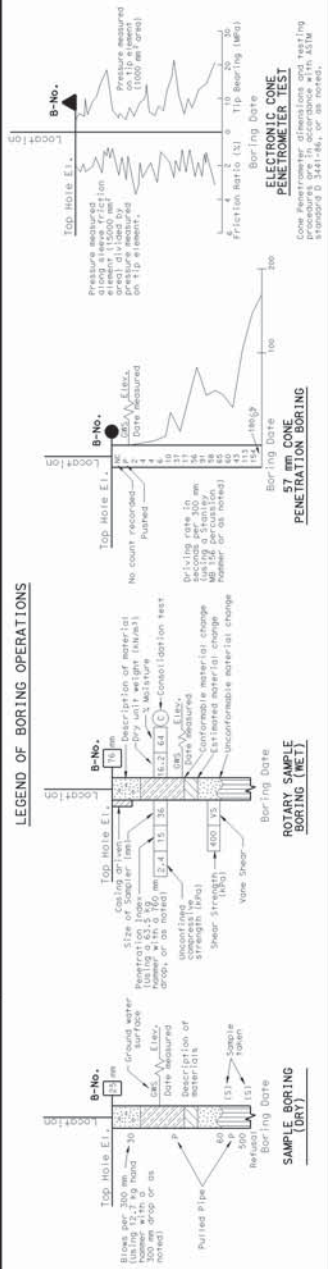


LEGEND OF EARTH MATERIALS

GRAVEL	CLAYEY SILT
SAND	PEAT and/or ORGANIC MATTER
SILT	FILL MATERIAL
CLAY	COBBLE
SANDY CLAY or CLAYEY SAND	INDURATED ROCK
SANDY SILT or SILTY SAND	SEDIMENTARY ROCK
SILTY CLAY	METAMORPHIC

CONSISTENCY CLASSIFICATION FOR SOILS

SPT	Flow Value	Consistency
0-4	Very Loose	Very Soft
5-10	Loose	Soft
11-20	Medium Dense	Firm
21-30	Dense	Stiff
31-50	Very Dense	Very Stiff
50		Hard

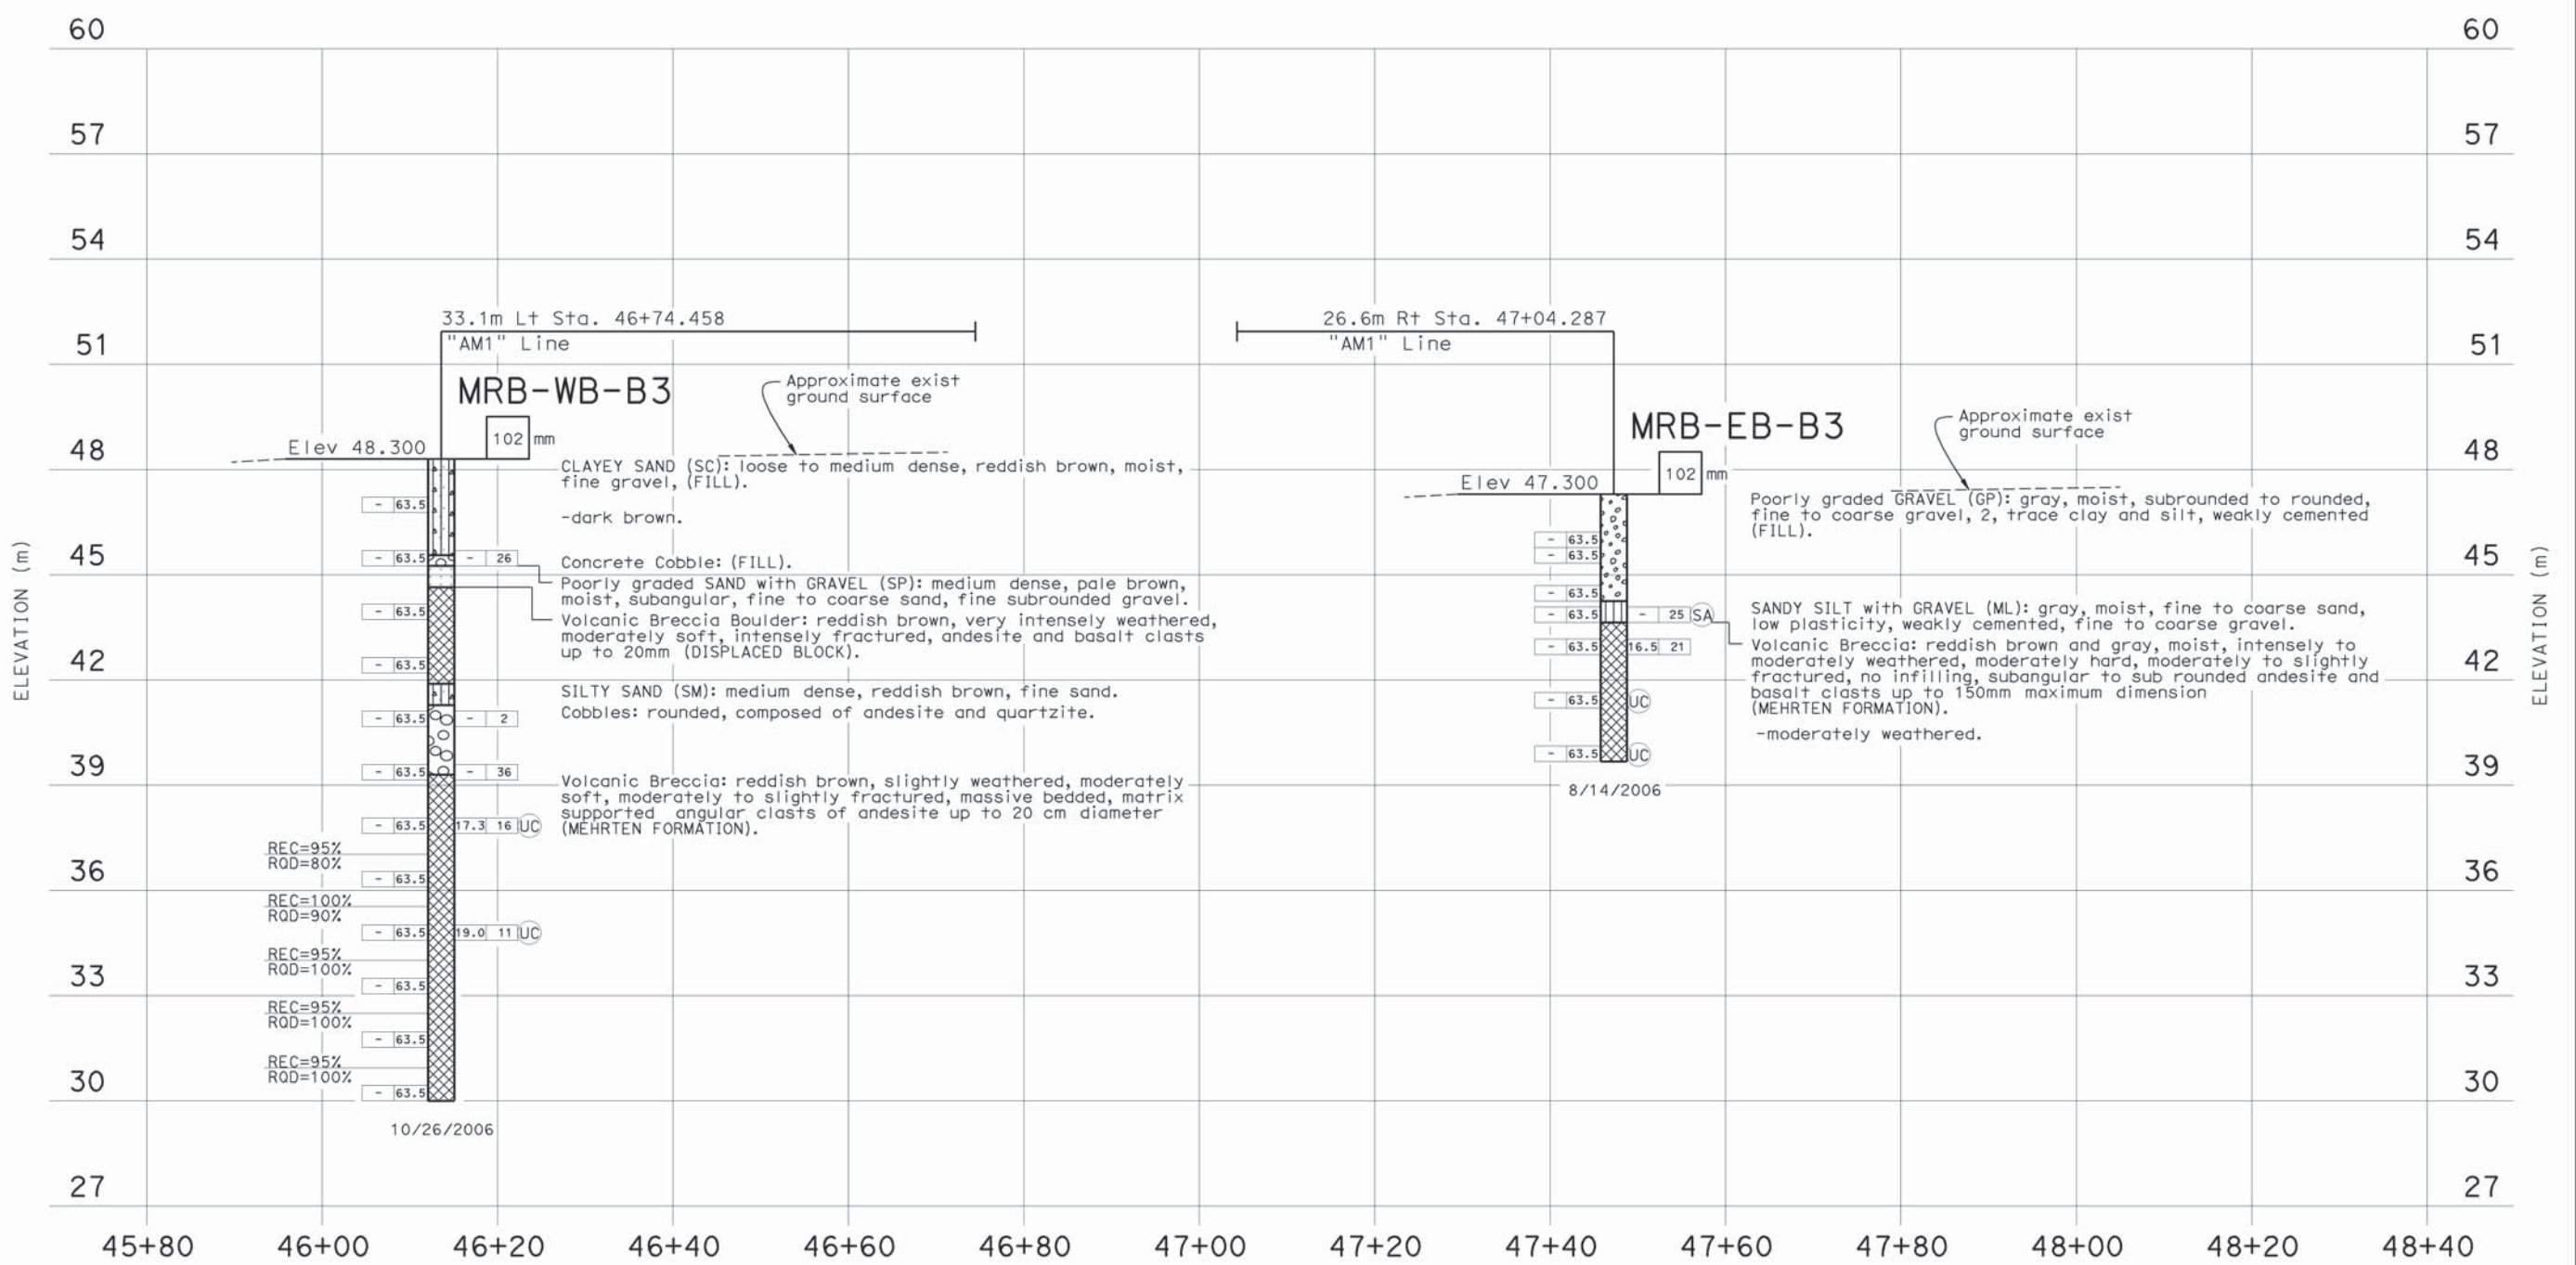

PROFILE  
 HOR. 1:400  
 VER. 1:100

Mark Stanley DESIGN OVERSIGHT 05/14/08 SIGN OFF DATE	DRAWN BY A. Sanchez	FIELD INVESTIGATION BY: DATE:	BRIDGE NO. 19-0056	MINERS RAVINE BRIDGE (WIDEN)
	CHECKED BY B. Anderson/ M. Stanley		PROJECT ENGINEER	LOG OF TEST BORINGS 4 OF 5
			DEPARTMENT OF TRANSPORTATION	





DIST	COUNTY	ROUTE	KILOMETER POST TOTAL PROJECT	SHEET No	TOTAL SHEETS
03	Placer	80	4.5/8.3	481	539

5-14-08  
REGISTERED CIVIL ENGINEER


11-17-08  
PLANS APPROVAL DATE

MARK H. STANLEY  
No. GE 2397  
Exp. 9-30-08  
REGISTERED PROFESSIONAL ENGINEER  
STATE OF CALIFORNIA  
GEOTECHNICAL

The State of California or its officers or agents shall not be responsible for the accuracy or completeness of electronic copies of this plan sheet.

KLEINFELDER INC.  
3077 FITE CIR.  
SACRAMENTO, CA 95826

FOR PLAN VIEW AND ADDITIONAL NOTES, SEE "LOG OF TEST BORINGS" SHEET 1 OF 5

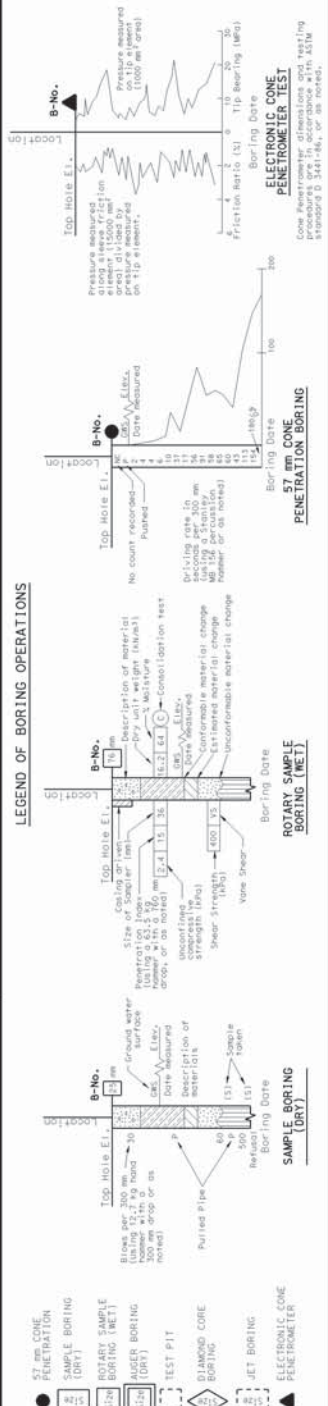


**LEGEND OF EARTH MATERIALS**

GRAVEL	CLAYEY SILT
SAND	PEAT and/or ORGANIC MATTER
SILT	FILL MATERIAL
CLAY	COBBLE
SANDY CLAY or CLAYEY SAND	INDURATED ROCK
SANDY SILT or SILTY SAND	SEDIMENTARY ROCK
SILTY CLAY	METAMORPHIC

**CONSISTENCY CLASSIFICATION FOR SOILS**

SPT Blow Count (0-30)	0-4	Very Loose
5-10	Loose	
11-30	Medium Dense	
31-50	Dense	
50	Very Dense	
51-100	Very Stiff	
101-200	Hard	
201-300	Very Hard	
301-400	Extremely Hard	

NOTE: Classification of earth material as shown on this sheet is based upon field inspection and is not to be construed to imply mechanical analysis.

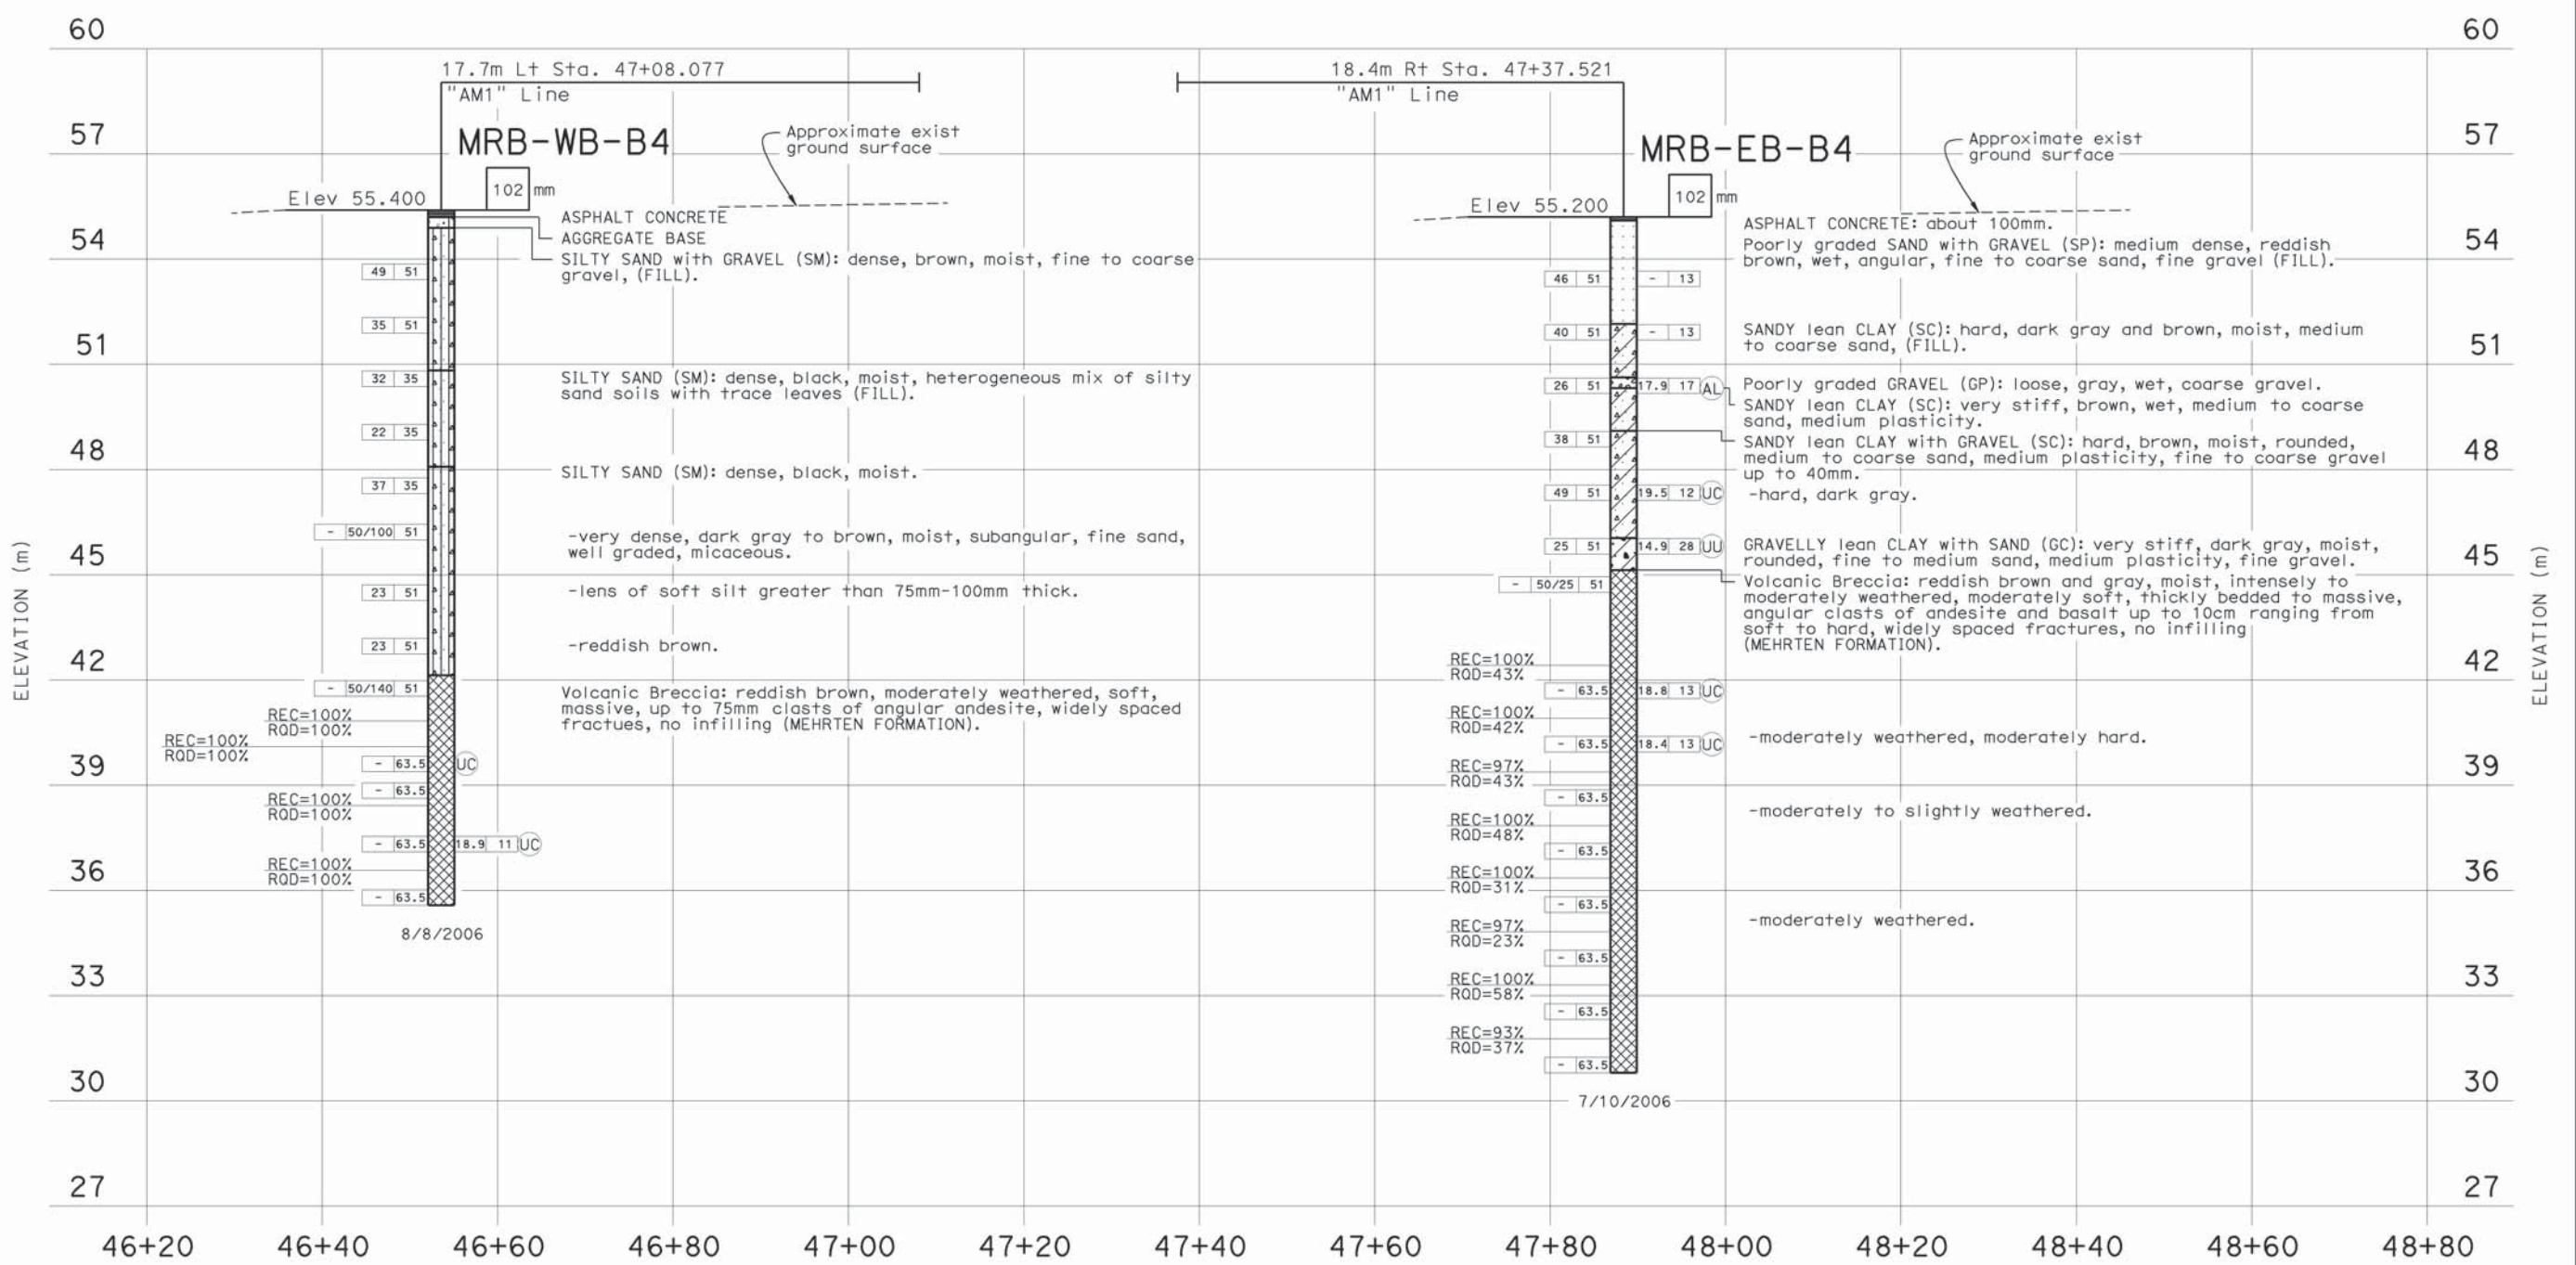

Mark Stanley DESIGN OVERSIGHT 05/14/08 SIGN OFF DATE	DRAWN BY A. Sanchez	FIELD INVESTIGATION BY: DATE:	BRIDGE NO. 19-0056	MINERS RAVINE BRIDGE (WIDEN)
CHECKED BY B. Anderson/ M. Stanley	PROJECT ENGINEER	DEPARTMENT OF TRANSPORTATION	KILOMETER POST 4.6	LOG OF TEST BORINGS 5 OF 5

DIST.	COUNTY	ROUTE	POST MILES - TOTAL PROJECT	POST MILE	DATE
03	Pld	80, 65	3.74, 3.14, 0.16, 3.12, 2.17, 5		


Robert L. DeRosia #165  
 ENGINEER IN CHARGE  
 DATE APPROVED: June 24, 1985

**LEGEND OF BORING OPERATIONS**

PENETRATION BORING  
 JET BORING  
 CORE BORING  
 ROTARY BORING (WET)  
 ROTARY BORING (DRY)  
 CONE BORING (DRY)  
 CONE PENETROMETER  
 SAMPLER BORING (DRY)

**LEGEND OF EARTH MATERIALS**

GRAVEL  
 SAND  
 SILT  
 CLAY  
 SILTY SAND  
 SILTY CLAY  
 CLAYEY SILT  
 CLAYEY SAND  
 CLAYEY SILTSTONE  
 SANDSTONE  
 SILTSTONE  
 CLAYSTONE  
 SHALE  
 SLATE  
 LIMESTONE  
 GRANITE  
 GNEISS  
 QUARTZITE  
 METASANDSTONE  
 METASILTSTONE  
 METACLAYSTONE  
 METASHALE  
 METASLATE  
 METALIMESTONE  
 METAGRANITE  
 METAGNEISS  
 METAQUARTZITE  
 METAMETASANDSTONE  
 METAMETASILTSTONE  
 METAMETACLAYSTONE  
 METAMETASHALE  
 METAMETASLATE  
 METAMETALIMESTONE  
 METAMETAGRANITE  
 METAMETAGNEISS  
 METAMETAQUARTZITE

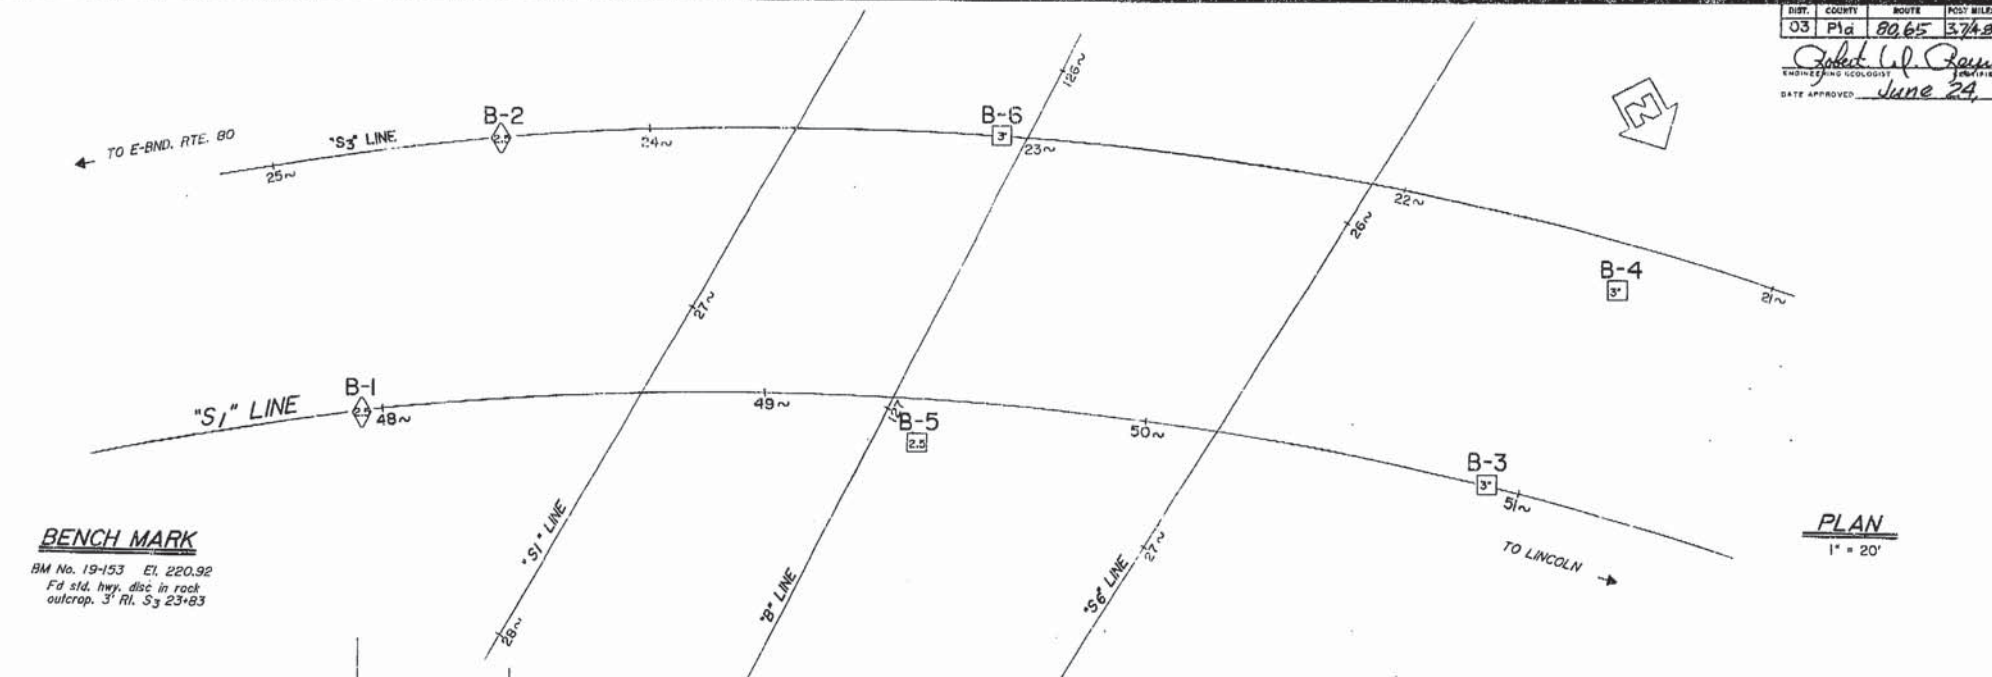

PLAN  
1" = 20'

NO CORRECTIONS THIS SHEET  
**AS BUILT**  
 C.P. CORRECTIONS BY J. DE ROSIA  
 4-11-88  
 CONTRACT NO. 05-242914  
 DATE 8-6-87


**CONSISTENCY CLASSIFICATION FOR SOILS**

According to the Standard Penetration Test (Blows/ft.)

Penetration Index (Blows/ft.)	Consistency
0 - 5	Very soft
5 - 10	Soft
10 - 20	Medium
20 - 30	Stiff
30 - 40	Very stiff
40 - 50	Hard
50 - 70	Very hard
70 - 100	Extremely hard

**UNIFIED SOIL CLASSIFICATION SYSTEM**

G - Gravel  
 S - Sand  
 M - Silty sand  
 CL - Clayey silt  
 OL - Organic silty clay  
 MH - Medium plastic silt  
 CH - High plastic clay  
 ML - Low plastic silt  
 CL - Low plastic clay  
 OL - Organic low plastic clay  
 GM - Gravelly medium plastic silt  
 GC - Gravelly high plastic clay  
 GM - Gravelly medium plastic clay  
 GC - Gravelly high plastic silt  
 GM - Gravelly medium plastic sand  
 GC - Gravelly high plastic sand

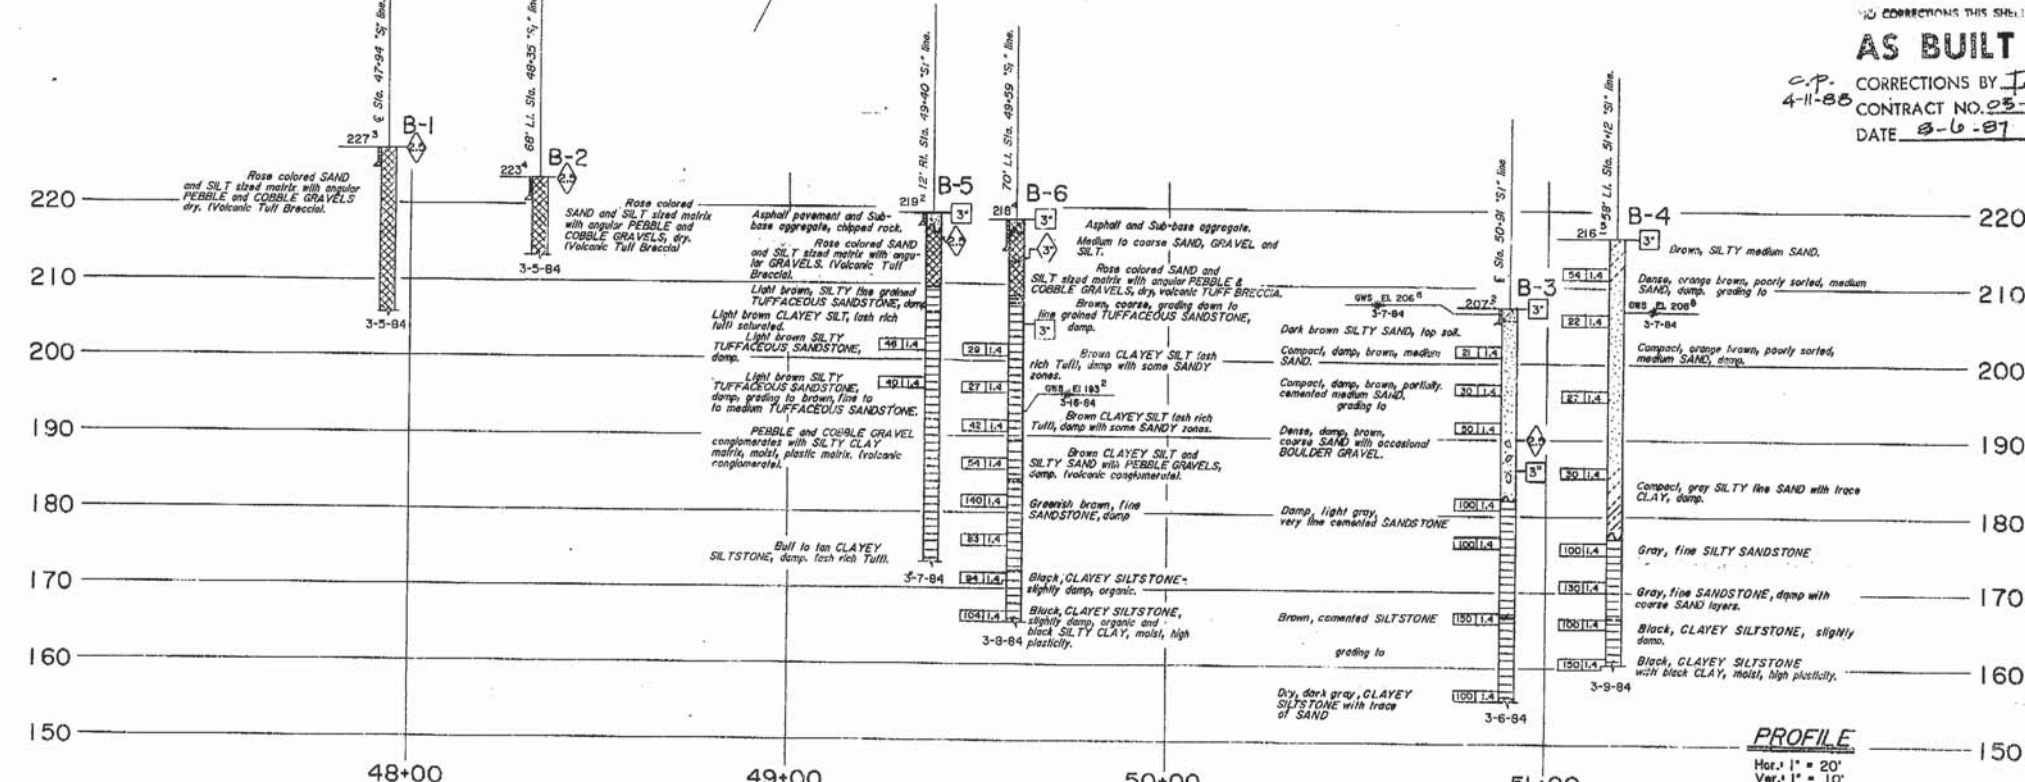

PROFILE  
Hor. 1" = 20'  
Ver. 1" = 10'

ENGINEERING GEOLOGY AND TECHNICAL SERVICES BRANCH - TRANSPORTATION LABORATORY

State of CALIFORNIA DEPARTMENT OF TRANSPORTATION

STRUCTURES - DESIGN

BRIDGE NO. 19-151 R/L  
POST MILE 4.8  
ROUTE 65/80 SEPARATION LOG OF TEST BORINGS


DRAWN BY: IRMA HOWELL 4/84  
 CHECKED BY: Michael S. Yee CE 11049  
 PROJECT GEOLOGIST: [Signature] CE 271  
 ENGINEER GEOLIST: [Signature] CE 271

CHARGE UNIT: [Blank]  
 AUTHORITY: [Blank]  
 SPEC. DESIGN: [Blank]

ORIGINAL SCALE IN INCHES FOR REDUCED PLANS: [Blank]  
 SCALE: 1" = 20'  
 CU 03  
 WO 242911

I HEREBY CERTIFY THAT THIS IS A TRUE AND ACCURATE COPY OF THE ABOVE DOCUMENT TAKEN UNDER MY DIRECTION AND CONTROL ON THIS DATE IN SACRAMENTO, CALIFORNIA PURSUANT TO AUTHORIZATION BY THE DIRECTOR OF TRANSPORTATION.

DATE 5-4-88  
 SUPERVISOR OF MICROFILM SERVICE: [Signature]

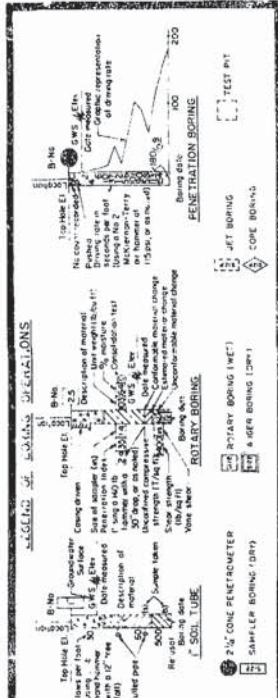


**LEGEND OF EARTH MATERIALS**

**CONSISTENCY CLASSIFICATION FOR SOILS**

**UNIFIED SOIL CLASSIFICATION SYSTEM**


Symbol	Description
Gravel	Gravel
Sand	Sand
Silt	Silt
Clay	Clay
Sandy clay	Sandy clay
Clayey sand	Clayey sand
Sandy silt	Sandy silt
Silt	Silt
Clayey silt	Clayey silt
Silty clay	Silty clay
Clay	Clay
Clayey clay	Clayey clay
Silty clay	Silty clay
Clay	Clay

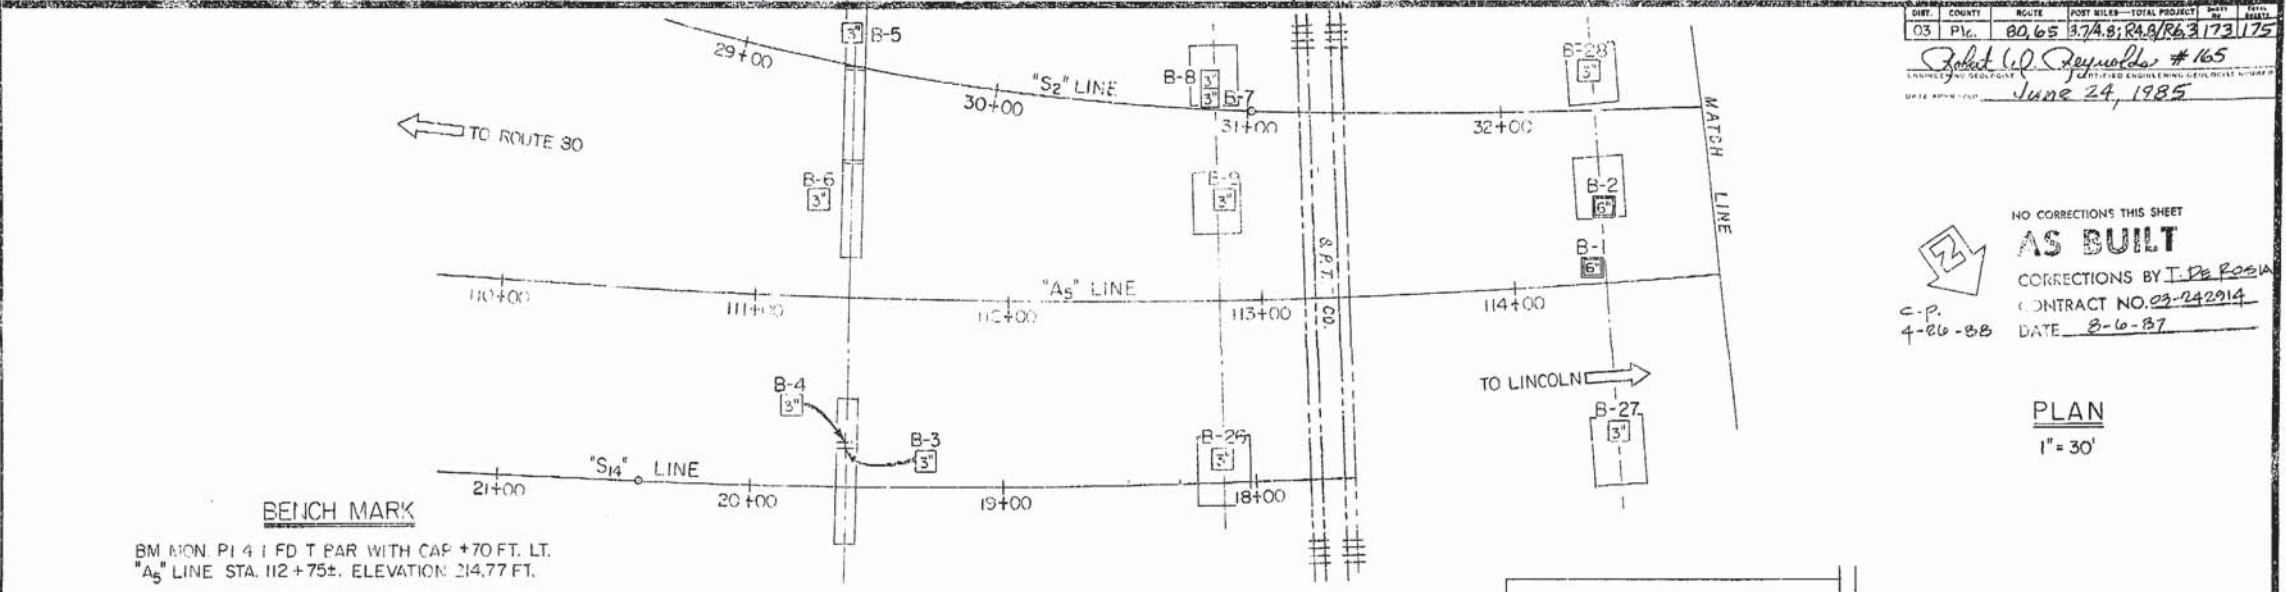

NO CORRECTIONS THIS SHEET  
**AS BUILT**  
 CORRECTIONS BY *T. De Rosa*  
 CONTRACT NO. *03-242914*  
 DATE *8-6-87*

*Robert G. Reynolds #165*  
 June 24, 1985

**PLAN**  
 1" = 30'

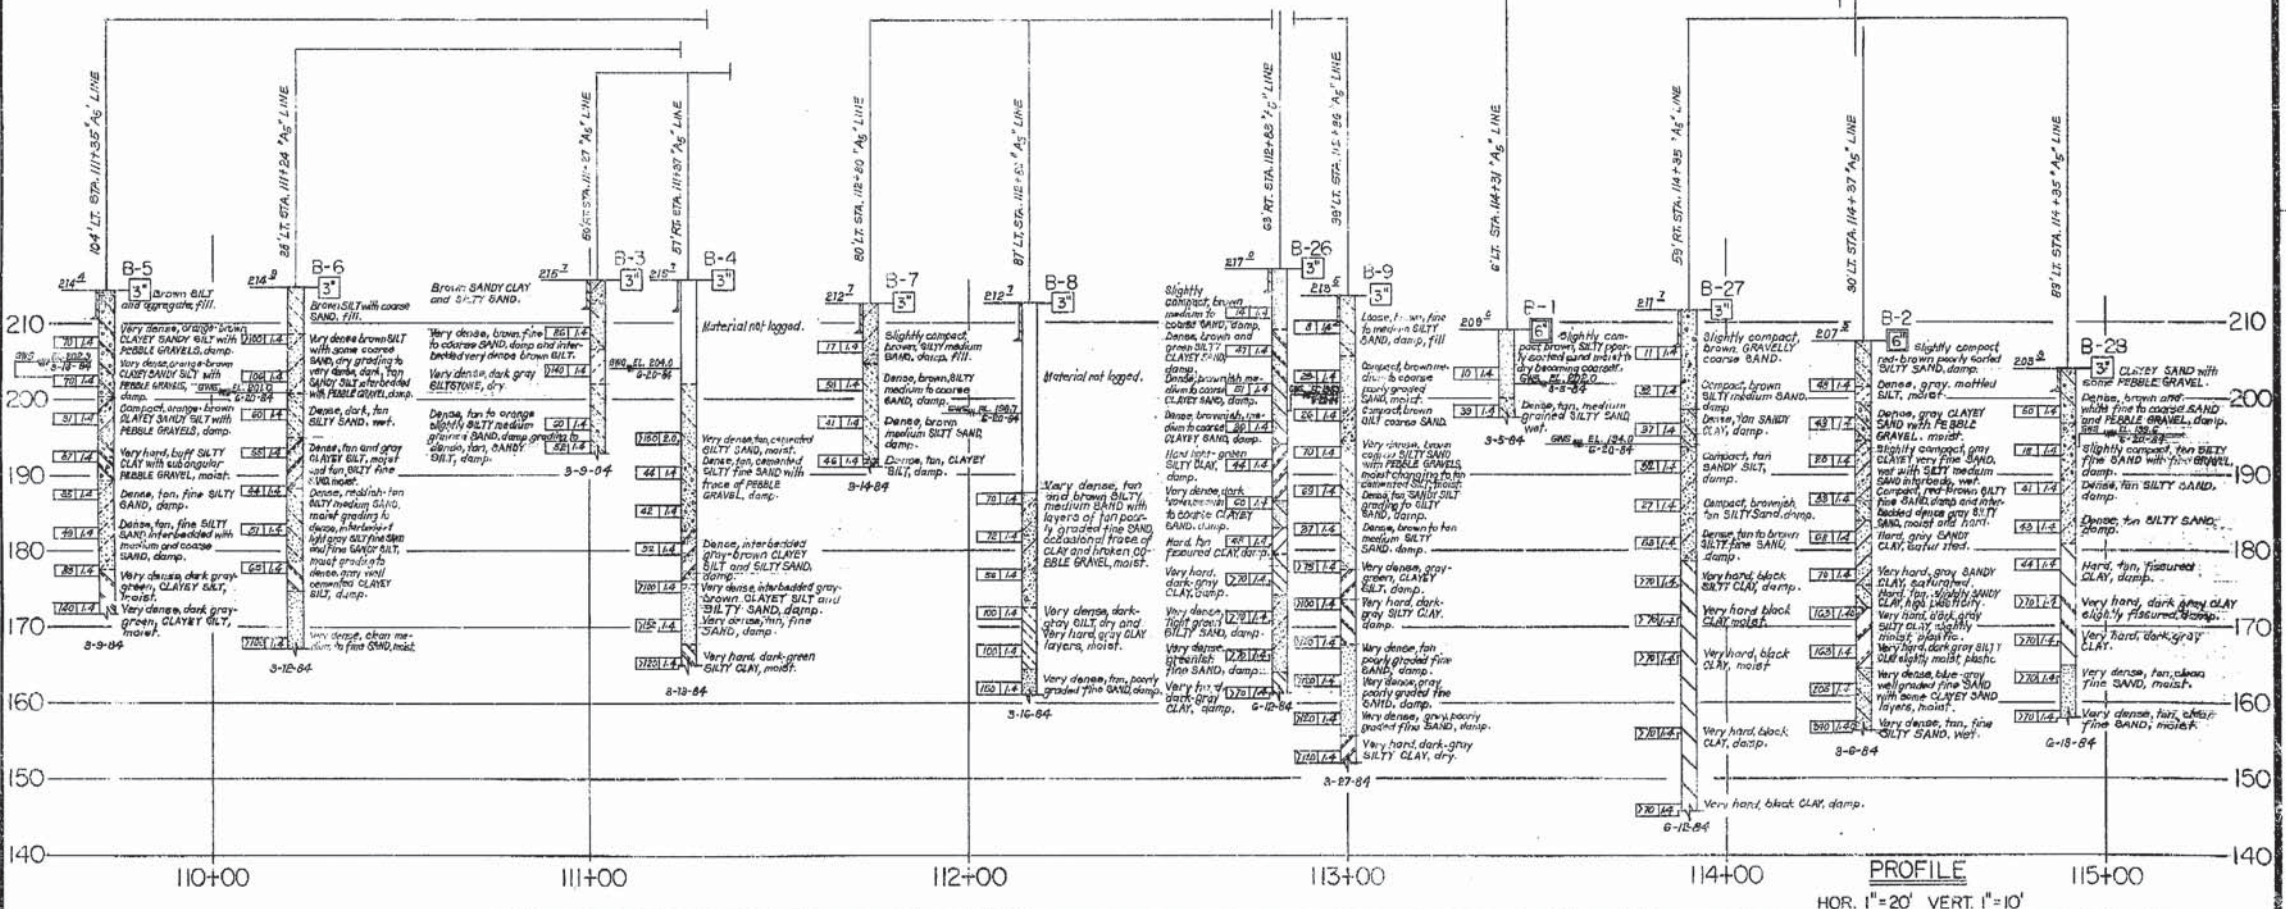

**GEOTECHNICAL BRANCH - TRANSPORTATION LABORATORY**

State of CALIFORNIA DEPARTMENT OF TRANSPORTATION

BRIDGE NO. 10-152 R/L  
 POST MILE R.5.1  
 EAST ROSEVILLE VIADUCT  
 LOG OF TEST BORINGS 1 OF 3

BRIDGE NO. 10-152 R/L  
 POST MILE R.5.1

BRIDGE NO. 10-152 R/L  
 POST MILE R.5.1


BRIDGE NO. 10-152 R/L  
 POST MILE R.5.1

I HEREBY CERTIFY THAT THIS IS A TRUE AND ACCURATE COPY OF THE ABOVE DOCUMENT TAKEN UNDER MY DIRECTION AND CONTROL ON THIS DATE IN SACRAMENTO, CALIFORNIA PURSUANT TO AUTHORIZATION BY THE DIRECTOR OF TRANSPORTATION.

5-4-88 *Donald Blackford*

174

DIST. COUNTY ROUTE POST MILES-TOTAL PROJECT  
 03 PLIA 80,65 374.8 RA 9/R6.3 174 175  
 Project No. 165  
 DATE APPROVED June 24, 1985

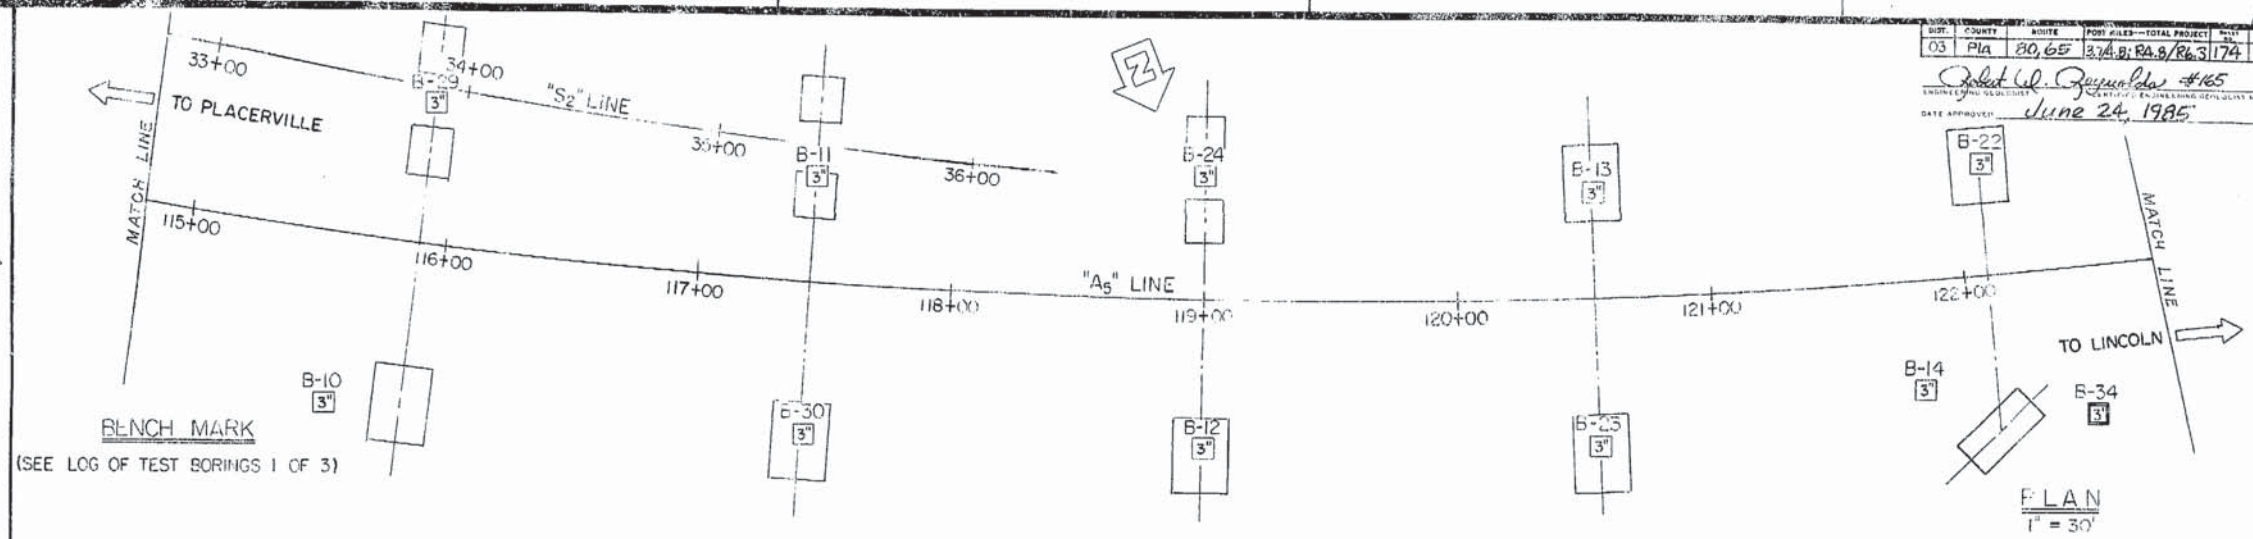

BENCH MARK  
 (SEE LOG OF TEST BORINGS 1 OF 3)

PLAN  
 1" = 30'

NO CORRECTIONS TO THIS PLAN  
**AS BUILT**  
 C.P. 4-26-88 CORRECTIONS BY J. DE ROSIA  
 CONTRACT NO. C2-242914  
 DATE 6-6-87

**LEGEND OF BORING OPERATIONS**

- TEST PIT
- ROD BORING
- COLE BORING
- ROTARY BORING
- 3" CONE PENETROMETER
- ROTARY BORING (MET)
- ROD BORING (200')
- ROTARY BORING (200')
- 3" CONE PENETROMETER
- SAMPLE BORING (200')
- TEST PIT


**LEGEND OF EARTH MATERIALS**

Symbol	Material Description
(Symbol)	CLAYEY SILT
(Symbol)	CLAY
(Symbol)	SANDY SILT
(Symbol)	SAND
(Symbol)	GRAVELLY SAND
(Symbol)	GRAVEL
(Symbol)	COARSE SAND
(Symbol)	MEDIUM SAND
(Symbol)	FINE SAND
(Symbol)	SILT
(Symbol)	CLAY
(Symbol)	SHALLOO ROCK
(Symbol)	CONCRETE
(Symbol)	ASPHALT
(Symbol)	ROCK

**CONSISTENCY CLASSIFICATION FOR SOILS**

Moisture Content (%)	Liquid Limit (%)	Consistency
0 - 25	0 - 25	Very Stiff
25 - 30	25 - 30	Stiff
30 - 40	40 - 40	Medium Stiff
40 - 50	50 - 50	Sticky Plastic
50 - 60	60 - 60	Plastic
60 - 70	70 - 70	Very Plastic
70 - 80	80 - 80	Very Sticky
80 - 90	90 - 90	Very Sticky
90 - 100	100 - 100	Very Sticky

**NOTES:** Classification of earth material is shown on this sheet is based upon 1/2 lb. specimens and is to be continued to imply mechanical analysis.

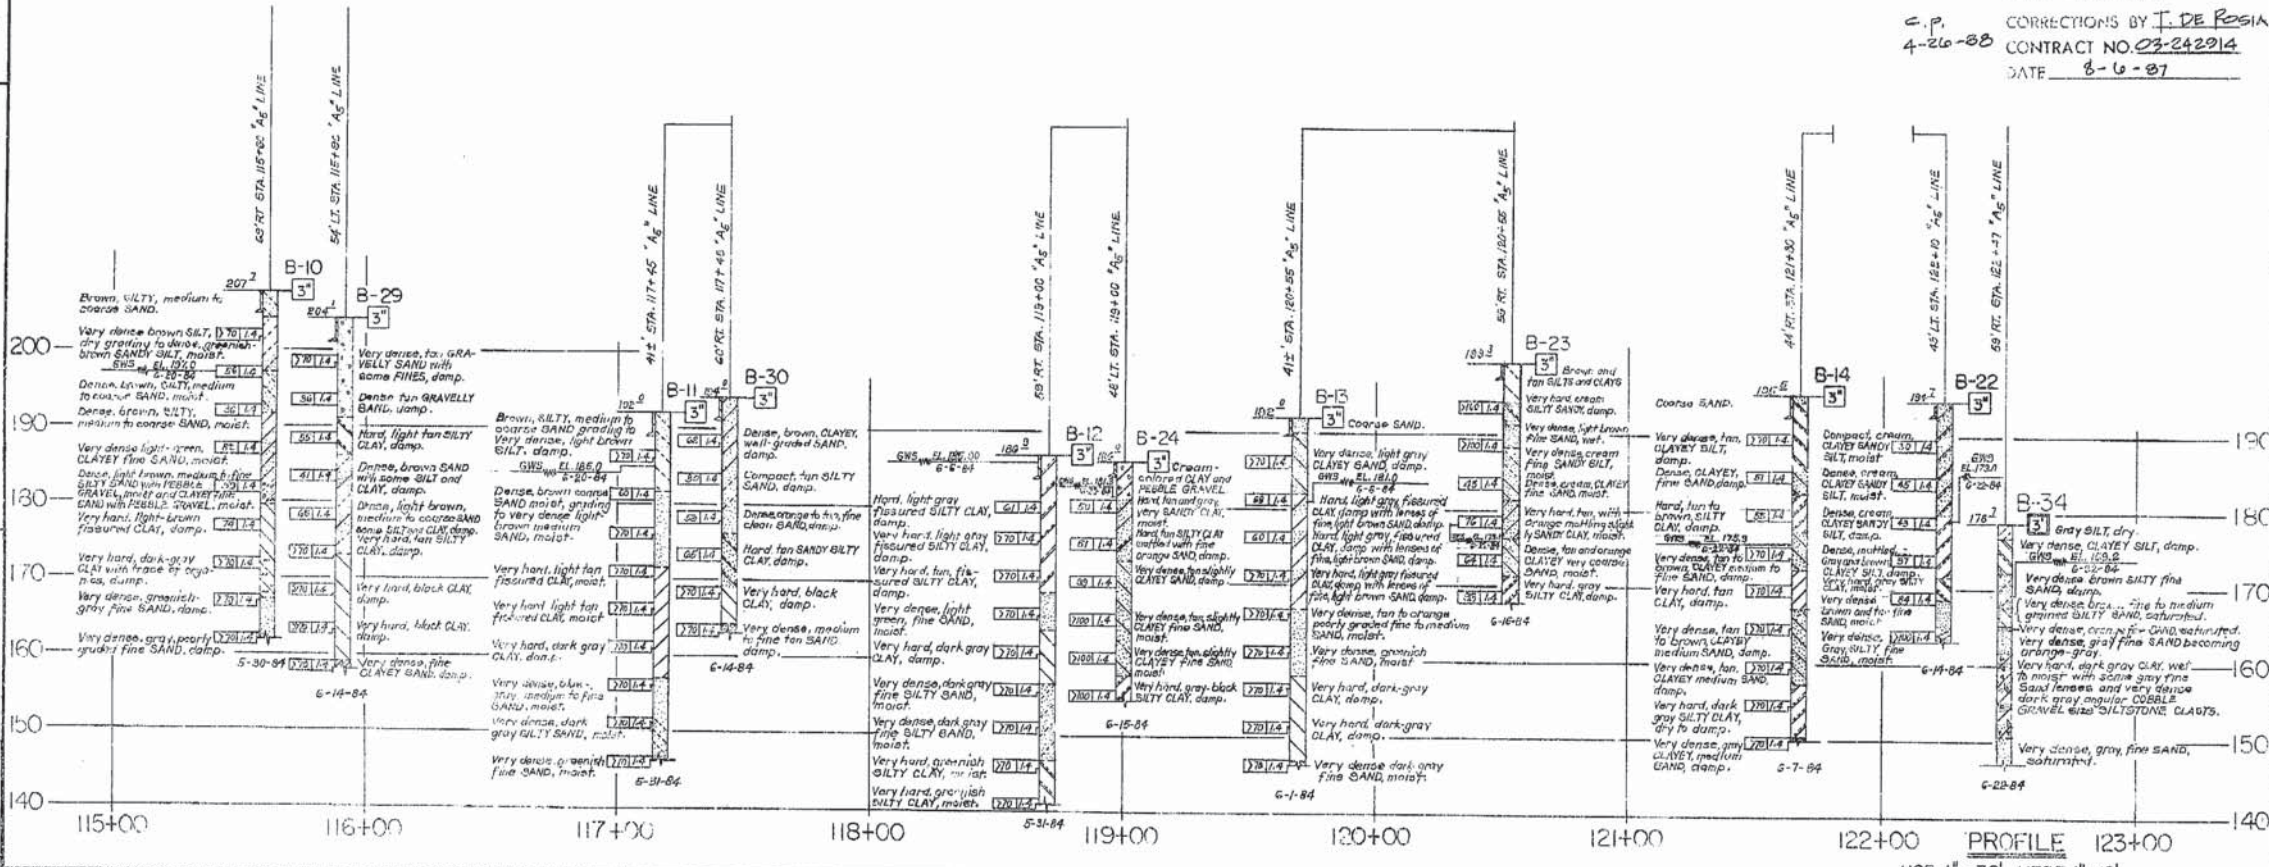

GEOTECHNICAL BRANCH - TRANSPORTATION LABORATORY  
 EAST ROSEVILLE VIADUCT  
 LOG OF TEST BORINGS 2 OF 3  
 HOR. 1" = 30' VERT. 1" = 10'

DESIGNED BY LEON L. LOPEZ	CHARGE UNIT 11699	EXP. AUTHORITY 11699	SEC. DESIGN 11699	BRIDGE NO. 19-152 R/L	POST MILE R.5.1
CHECKED BY Ronald L. Baker	DATE 11/8/84	DATE 11/8/84	DATE 11/8/84	EAST ROSEVILLE VIADUCT	
State of CALIFORNIA DEPARTMENT OF TRANSPORTATION STRUCTURES - DESIGN 11 M.E. Shaw 10-17-84 14636 ORIGINAL SCALE: 1/2 INCHES FOR REDUCED PLANS CU 05210 WO 242911 Disposal guide bearing earlier revision date				LOG OF TEST BORINGS 2 OF 3 SHEET 52 OF 53	

174

**AS BUILT**  
 Contract No. C2-242914

I HEREBY CERTIFY THAT THIS IS A TRUE AND ACCURATE COPY OF THE ABOVE DOCUMENT TAKEN UNDER MY DIRECTION AND CONTROL ON THIS DATE IN SACRAMENTO, CALIFORNIA PURSUANT TO AUTHORIZATION BY THE ENGINEER OF TRANSPORTATION.







DIST	COUNTY	ROUTE	KILOMETER POST TOTAL PROJECT	SHEET No	TOTAL SHEETS
03	Sac, Plq	80	28.1/29.0, 0.0/4.7	493	528

**Khaled Chowdhury** 6-27-07  
REGISTERED CIVIL ENGINEER

11-26-07  
PLANS APPROVAL DATE

The State of California or its officers or agents shall not be responsible for the accuracy or completeness of electronic copies of this plan sheet.

KLEINFELDER INC.  
3077 FITE CIR.  
SACRAMENTO, CA 95826

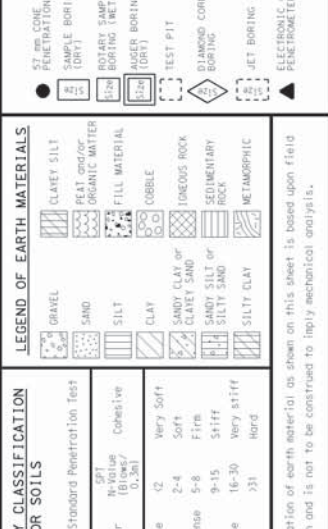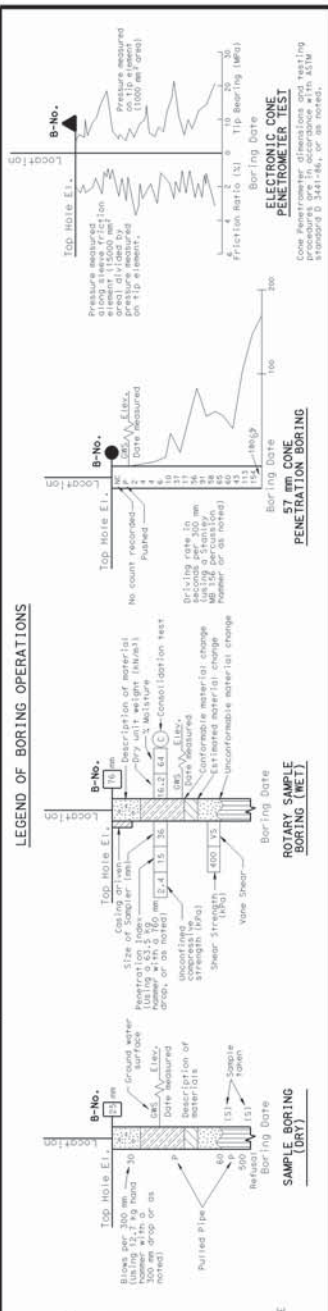

**CONSISTENCY CLASSIFICATION FOR SOILS**

According to the Standard Penetration Test

SPT	Relative Density (D <sub>r</sub> )	Consistency
0-4	Very Loose	Very Soft
5-10	Loose	Soft
11-20	Medium Dense	Firm
21-30	Dense	Stiff
31-50	Very Dense	Very Stiff
50		Hard

NOTE: Classification of earth material as shown on this sheet is based upon field inspection and is not to be construed to imply mechanical analysis.

Descriptors		Diagnostic features				Texture and solutioning		General characteristics (strength, excavation, etc.) <sup>5</sup>
Alphanumeric descriptor	Descriptive term	Chemical weathering-Discoloration and/or oxidation	Mechanical weathering-Grain boundary conditions (disaggregation) primarily for granitics and some coarse-grained sediments	Texture	Solutioning	Texture	Solutioning	
W1	Fresh	No discoloration, not oxidized.	No discoloration or oxidation.	No separation, intact (tight).	No change.	No solutioning.	Hammer rings when crystalline rocks are struck. Almost always rock excavation except for naturally weak or weakly cemented rocks such as siltstones or shales.	
W2	Slightly weathered to fresh <sup>o</sup>							
W3	Slightly weathered	Discoloration or oxidation is limited to surface of, or short distance from, fractures; some feldspar crystals are dull.	Minor to complete discoloration or oxidation of most surfaces.	No visible separation, intact (tight).	Preserved.	Minor leaching of some soluble minerals may be noted.	Hammer rings when crystalline rocks are struck. Body of rock not weakened. With few exceptions, such as siltstones or shales, classified as rock excavation.	
W4	Moderately to slightly weathered <sup>o</sup>							
W5	Moderately weathered	Discoloration or oxidation extends from fractures, usually throughout; Fe-Mg minerals are "rusty," feldspar crystals are "cloudy."	All fracture surfaces are discolored or oxidized.	Partial separation of boundaries visible.	Generally preserved.	Soluble minerals may be mostly leached.	Hammer does not ring when rock is struck. Body of rock is slightly weakened. Depending on fracturing, usually is rock excavation except in naturally weak rocks such as siltstones or shales.	
W6	Intensely to moderately weathered <sup>o</sup>							
W7	Intensely weathered	Discoloration or oxidation throughout; all feldspars and Fe-Mg minerals are altered to clay to some extent; or chemical alteration produces in-situ disaggregation, see grain boundary conditions.	All fracture surfaces are discolored or oxidized, surfaces friable.	Partial separation, rock is friable; in semi-arid conditions granitics are disaggregated.	Texture altered by chemical disintegration (hydration, argillation).	Leaching of soluble minerals may be complete.	Dull sound when struck with hammer, usually can be broken with moderate to heavy manual pressure or by light hammer blow without reference to planes of weakness such as incipient or hairline fractures, or veinlets. Rock is significantly weakened. Usually common excavation.	
W8	Very intensely weathered							
W9	Decomposed	Discolored or oxidized throughout, but resistant minerals such as quartz may be unaltered; all feldspars and Fe-Mg minerals are completely altered to clay.		Complete separation of grain boundaries (disaggregated).	Resembles a soil, partial or complete remnant rock structure may be preserved; leaching of soluble minerals usually complete.		Can be granulated by hand, always common excavation. Resistant minerals such as quartz may be present as "stringers" or "dikes."	

Note: This chart and its horizontal categories are more readily applied to rocks with feldspars and mafic minerals. Weathering in various sedimentary rocks, particularly limestones and poorly indurated sediments, will not always fit the categories established. This chart and weathering categories may have to be modified for particular site conditions or alteration such as hydrothermal effects; however, the basic framework and similar descriptors are to be used.


<sup>o</sup> Combination descriptors are permissible where equal distribution of both weathering characteristics are present over significant intervals or where characteristics present are "in between" the diagnostic feature. However, dual descriptors should not be used where significant, identifiable zones can be delineated. When given as a range, only two adjacent terms may be combined. "Decomposed to slightly weathered," or "moderately weathered to fresh" are not acceptable.

<sup>1</sup> Does not include directional weathering along shears or faults and their associated features. For example, a shear zone that carried weathering to great depths into a fresh rock mass would not require the rock mass to be classified as weathered.

<sup>5</sup> These are generalizations and should not be used as diagnostic features for weathering or excavation classification. These characteristics vary to a large extent based on naturally weak materials or cementation and type of excavation.

FRACTURE DENSITY	
<p><b>FRACTURE DENSITY</b>- Based on the spacing of all natural fractures in an exposure or core recovery lengths in boreholes; excludes mechanical breaks, shears, and shear zones; however, shear-distributed zones (fracturing outside the shear) are included. Descriptors for fracture density apply to all rock exposures such as tunnel walls, adit trenches, outcrops, or foundation cut slopes and inverts, as well as boreholes. Descriptive criteria presented below are based on borehole cores where lengths are measured along the core axis, for other exposures the criteria is distance measured between fractures (size of blocks).</p> <p><b>UNFRACTURED (FD0):</b> No fractures.</p> <p><b>VERY SLIGHTLY FRACTURED (FD1):</b> Core recovered mostly in lengths greater than 1 m.</p> <p><b>SLIGHTLY TO VERY SLIGHTLY FRACTURED (FD2)*</b></p> <p><b>SLIGHTLY FRACTURED (FD3):</b> Core recovered mostly in lengths from 300 to 1000 mm, with few scattered lengths less than 300 mm or greater than 1000 mm.</p> <p><b>MODERATELY TO SLIGHTLY FRACTURED (FD4)*</b></p> <p><b>MODERATELY FRACTURED (FD5):</b> Core recovered mostly in 100 to 300 mm lengths with most lengths about 200 mm.</p> <p><b>INTENSELY TO MODERATELY FRACTURED (FD6)*</b></p> <p><b>INTENSELY FRACTURED (FD7):</b> Lengths average from 30 to 100 mm with scattered fragmented intervals. Core recovered mostly in lengths less than 100 mm.</p> <p><b>VERY INTENSELY TO INTENSELY FRACTURED (FD8)*</b></p> <p><b>VERY INTENSELY FRACTURED (FD9):</b> Core recovered mostly as chips and fragments with a few scattered short core lengths.</p> <p>* Combinations of fracture densities (e.g. very intensely to intensely fractured, or moderately to slightly fractured) are used where equal distribution of both fracture density characteristics are present over a significant interval or exposure, or where characteristics are "in between" the descriptor definitions.</p>	

ROCK HARDNESS/STRENGTH DESCRIPTORS		
Alphanumeric Descriptor	Descriptor	Criteria
H1	Extremely hard	Core, fragment, or exposure cannot be scratched with knife or sharp pick; can only be chipped with repeated heavy hammer blows.
H2	Very hard	Cannot be scratched with knife or sharp pick. Core or fragment breaks with repeated heavy hammer blows.
H3	Hard	Can be scratched with knife or sharp pick with difficulty (heavy pressure). Heavy hammer blow required to break specimen.
H4	Moderately hard	Can be scratched with knife or sharp pick with moderate pressure. Core or fragment breaks with moderate hammer blow.
H5	Moderately soft	Can be grooved 2 mm deep by knife or sharp pick with moderate or heavy pressure. Core or fragment breaks with light hammer blow or heavy manual pressure.
H6	Soft	Can be grooved or gouged easily by knife or sharp pick with light pressure, can be scratched with fingernail. Breaks with light to moderate manual pressure.
H7	Very soft	Can be readily indented, grooved or gouged with fingernail, or carved with a knife. Breaks with light manual pressure.
Any bedrock unit softer than H7, very soft, is to be described using ASTM D-2488 consistency descriptors.		
Note: Although "sharp pick" is included in these definitions, descriptions of ability to be scratched, grooved or gouged by a knife is the preferred criteria.		
Modified from United States Bureau of Reclamation, Engineering Geology Field manual.		

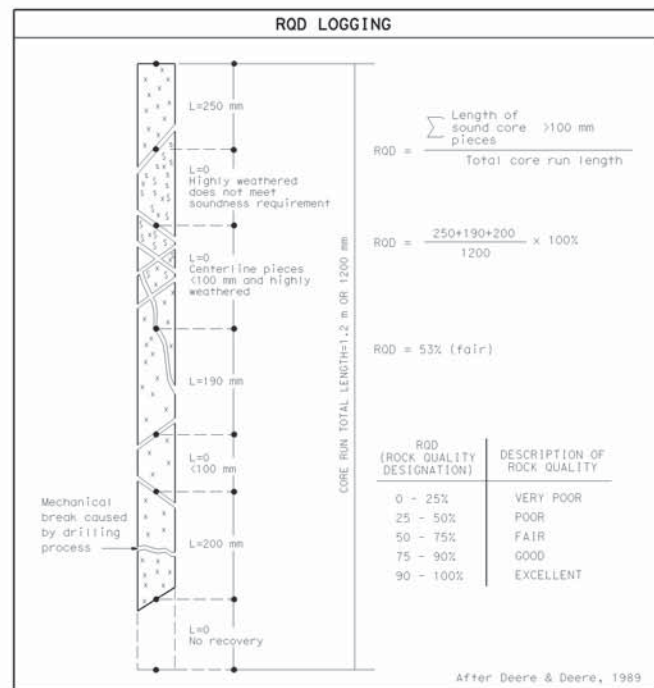

BEDDING, FOLIATION, OR FLOW TEXTURE DESCRIPTORS	
Descriptors	Thickness / Spacing
Massive	Greater than 3 m
Very thickly (bedded, foliated, or banded)	1 to 3 m
Thickly	300 mm to 1 m
Moderately	100 to 300 mm
Thinly	30 to 100 mm
Very thinly	10 to 30 mm
Laminated (intensely foliated or banded)	Less than 10 mm

Modified from United States Bureau of Reclamation, Engineering Geology Field manual.

- IN-SITU, LAB & FIELD TEST DESIGNATIONS**
- (AL) ATTERBERG LIMITS
  - (CA) CHEMICAL ANALYSIS
  - (CN) CONSOLIDATION
  - (CU) CONSOLIDATED UNDRAINED TRIAXIAL
  - (DS) DIRECT SHEAR
  - (MD) MAX. DRY DENSITY
  - (PP) POCKET PENETROMETER
  - (SA) SIEVE ANALYSIS
  - (TV) TORVANE
  - (UC) UNCONFINED COMPRESSION
  - (UU) UNCONSOLIDATED UNDRAINED TRIAXIAL
  - (VS) VANE SHEAR

D Brittan DESIGN OVERSIGHT June 29, 2007 SIGN OFF DATE	DRAWN BY A. Sanchez	CHECKED BY M. Briseno	GZhang/BVonDessoneck FIELD INVESTIGATION BY: DATE: August 2006	PREPARED FOR THE STATE OF CALIFORNIA DEPARTMENT OF TRANSPORTATION	K Chowdhury PROJECT ENGINEER	BRIDGE NO. 19E005 KILOMETER POST 4.14	<b>RETAINING WALL 39E-41E</b> <b>ROCK LEGENDS AND LABORATORY AND FIELD TEST SYMBOLS</b>
CIVIL LOG OF TEST BORINGS SHEET (METRIC) (REV. 2/1/00)							DISREGARD PRINTS BEARING EARLIER REVISION DATES
ORIGINAL SCALE IN MILLIMETERS FOR REDUCED PLANS							REVISION DATES (PRELIMINARY STAGE ONLY)
CU 03262 EA 367821							SHEET 23 OF 29

USERNAME = jrr11111 DATE PLOTTED = 28-NOV-2007 TIME PLOTTED = 14:48




DIST	COUNTY	ROUTE	KILOMETER POST TOTAL PROJECT	SHEET No	TOTAL SHEETS
03	Sac, Pla	80	28.1/29.0, 0.0/4.7	494	528

Khaled H. Chowdhury 6-27-07  
 REGISTERED CIVIL ENGINEER  
 No. C67823  
 Exp. 6-30-09  
 CIVIL  
 STATE OF CALIFORNIA

11-26-07  
 PLANS APPROVAL DATE

The State of California or its officers or agents shall not be responsible for the accuracy or completeness of electronic copies of this plan sheet.

KLEINFELDER INC.  
 3077 FITE CIR.  
 SACRAMENTO, CA 95826

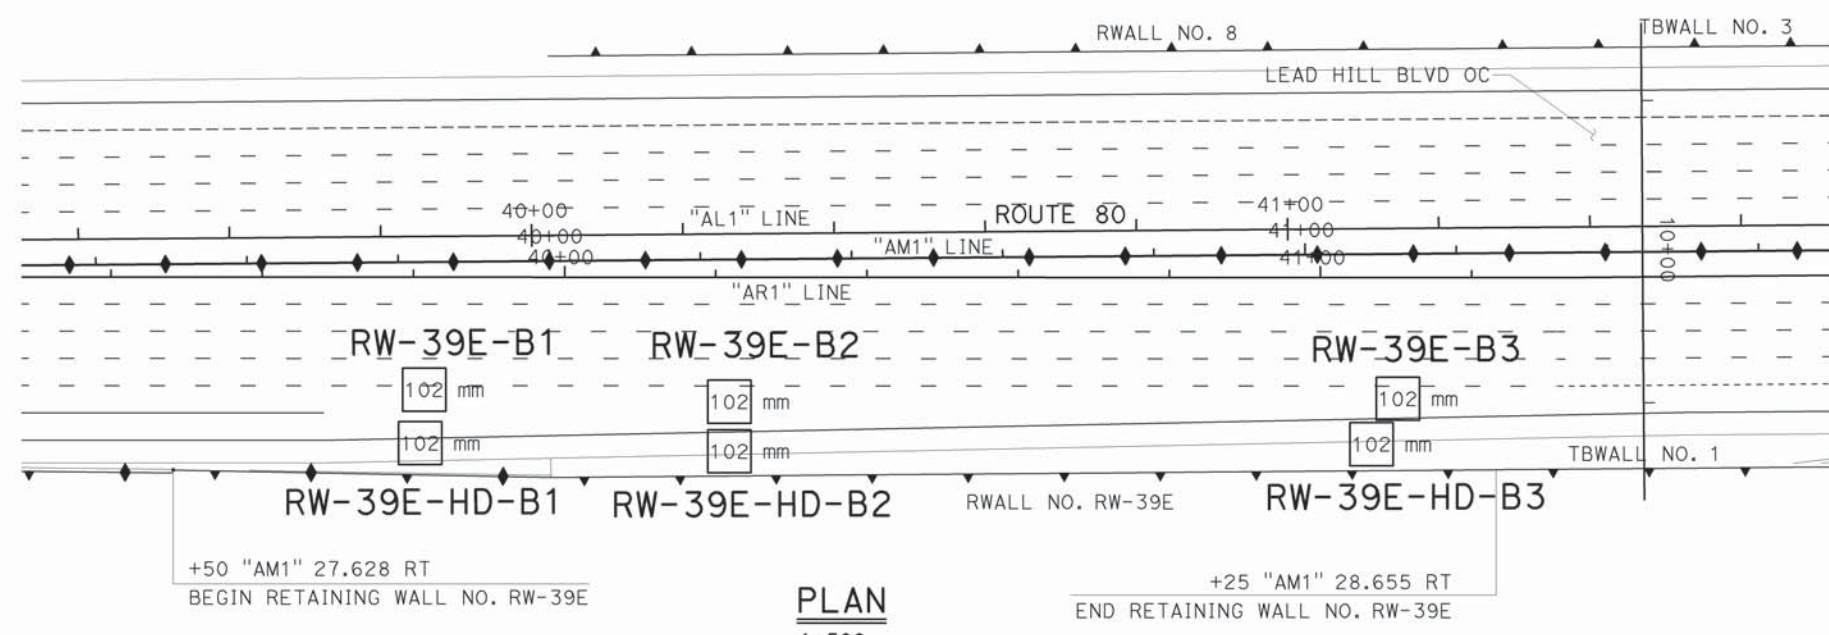


+50 "AM1" 27.628 RT  
 BEGIN RETAINING WALL NO. RW-39E

+25 "AM1" 28.655 RT  
 END RETAINING WALL NO. RW-39E

**PLAN**  
 1:500

LEGEND OF BORING OPERATIONS

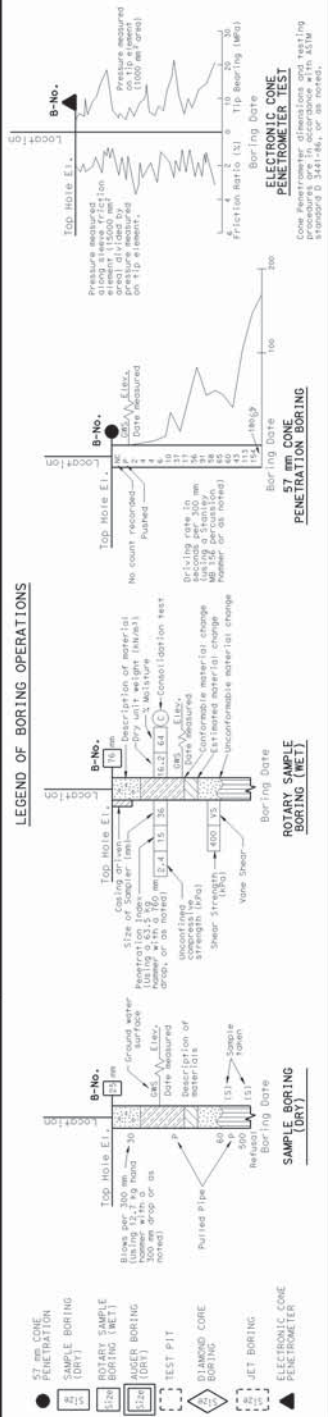

**LEGEND OF EARTH MATERIALS**

GRAVEL	CLAYEY SILT
SAND	PEAT and/or ORGANIC MATTER
SILT	FILL MATERIAL
CLAY	COBBLE
SANDY CLAY or CLAYEY SAND	INDURATED ROCK
SANDY SILT or SILTY SAND	SEDIMENTARY ROCK
SILTY CLAY	METAMORPHIC

**CONSISTENCY CLASSIFICATION FOR SOILS**

SPT N-value (blows/30cm)	Consistency
0-4	Very Loose
5-10	Loose
11-20	Medium Dense
21-30	Dense
31-50	Very Dense
51-100	Hard

NOTE: Classification of earth material as shown on this sheet is based upon field inspection and is not to be construed to imply mechanical analysis.

**BENCHMARKS**

STATION	OFFSET	N	E	ELEV	DESCRIPTION
15+79.190	4.62 Rt	618564.792	2062442.621	44.552	

**SURVEY CONTROL**

1. Coordinates bearing and distances are based on the California coordinate system of Nad 1983 HPGN, zone 6. (EPOCH 1991.35). Elevations are based on NGVD 29.



**Notes:**

- 51 mm samples were taken using a California split-barrel sampler with an inside diameter (I.D.) of 51 mm and an outside diameter (O.D.) of 64 mm.
- A safety semi-automatic hammer (63.5 kg) with a 760 mm drop was used to advance the sampler.
- Blowcounts noted for boring are field blowcounts and have not been corrected.
- 35 mm samples were taken using a SPT split-barrel sampler with an inside diameter (I.D.) of 35 mm and an outside diameter (O.D.) of 51 mm.
- 63.5 mm core samples were taken using an HQ core sampler with a 63.5 mm inside diameter (I.D.) and 94 mm outside diameter (O.D.) core barrel.
- Blowcounts 50/125 means 50 blows per 125 mm penetration.
- Horizontal Borings were started approximately 1.5m above adjacent shoulder grade and inclined downward at a 10 degree angle. Horizontal borings intersect shoulder grade at a depth of approximately 8.8 meters.

D. Brittsan  
 DESIGN OVERSIGHT  
 June 29, 2007  
 SIGN OFF DATE

DRAWN BY  
 A. Sanchez

CHECKED BY  
 B. Anderson, C.E.G.

Kleinfelder, Inc.  
 FIELD INVESTIGATION BY:  
 DATE: December 2006

PREPARED FOR THE  
 STATE OF CALIFORNIA  
 DEPARTMENT OF TRANSPORTATION

K Chowdhury  
 PROJECT ENGINEER

BRIDGE NO.  
 19E0005

KILOMETER POST  
 4.14

**RETAINING WALL 39E-41E**  
**LOG OF TEST BORINGS 1 OF 6**





DIST	COUNTY	ROUTE	KILOMETER POST TOTAL PROJECT	SHEET No	TOTAL SHEETS
03	Sac, Plq	80	28.1/29.0, 0.0/4.7	495	528


Khaled H. Chowdhury 6-27-07  
 REGISTERED CIVIL ENGINEER  
 No. C67823  
 Exp. 6-30-09  
 CIVIL  
 STATE OF CALIFORNIA

11-26-07  
 PLANS APPROVAL DATE

The State of California or its officers or agents shall not be responsible for the accuracy or completeness of electronic copies of this plan sheet.

KLEINFELDER INC.  
 3077 FITE CIR.  
 SACRAMENTO, CA 95826

FOR PLAN VIEW AND ADDITIONAL NOTES, SEE "LOG OF TEST BORINGS" SHEET 1 OF 4

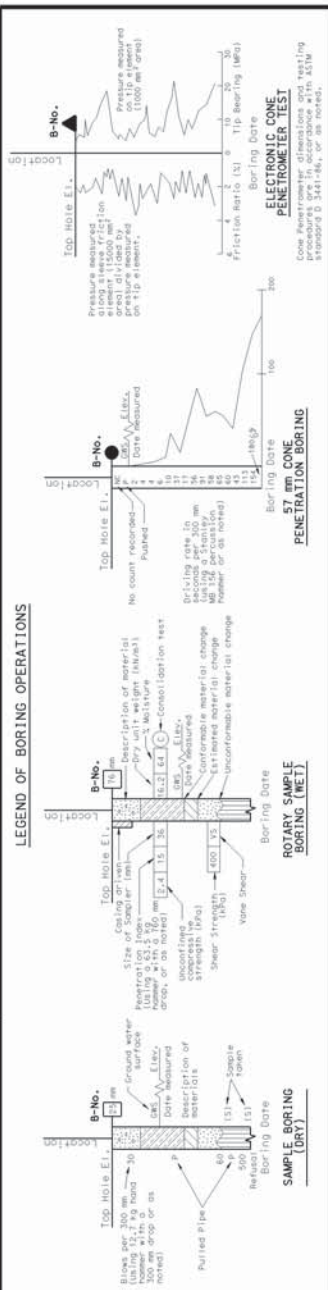


**CONSISTENCY CLASSIFICATION FOR SOILS**

According to the Standard Penetration Test

SPT N-value (blows/30cm)	Consistency
0-4	Very Loose
5-10	Loose
11-20	Medium Dense
21-30	Dense
31-50	Very Dense
50	Hard

NOTE: Classification of earth material as shown on this sheet is based upon field inspection and is not to be construed to imply mechanical analysis.

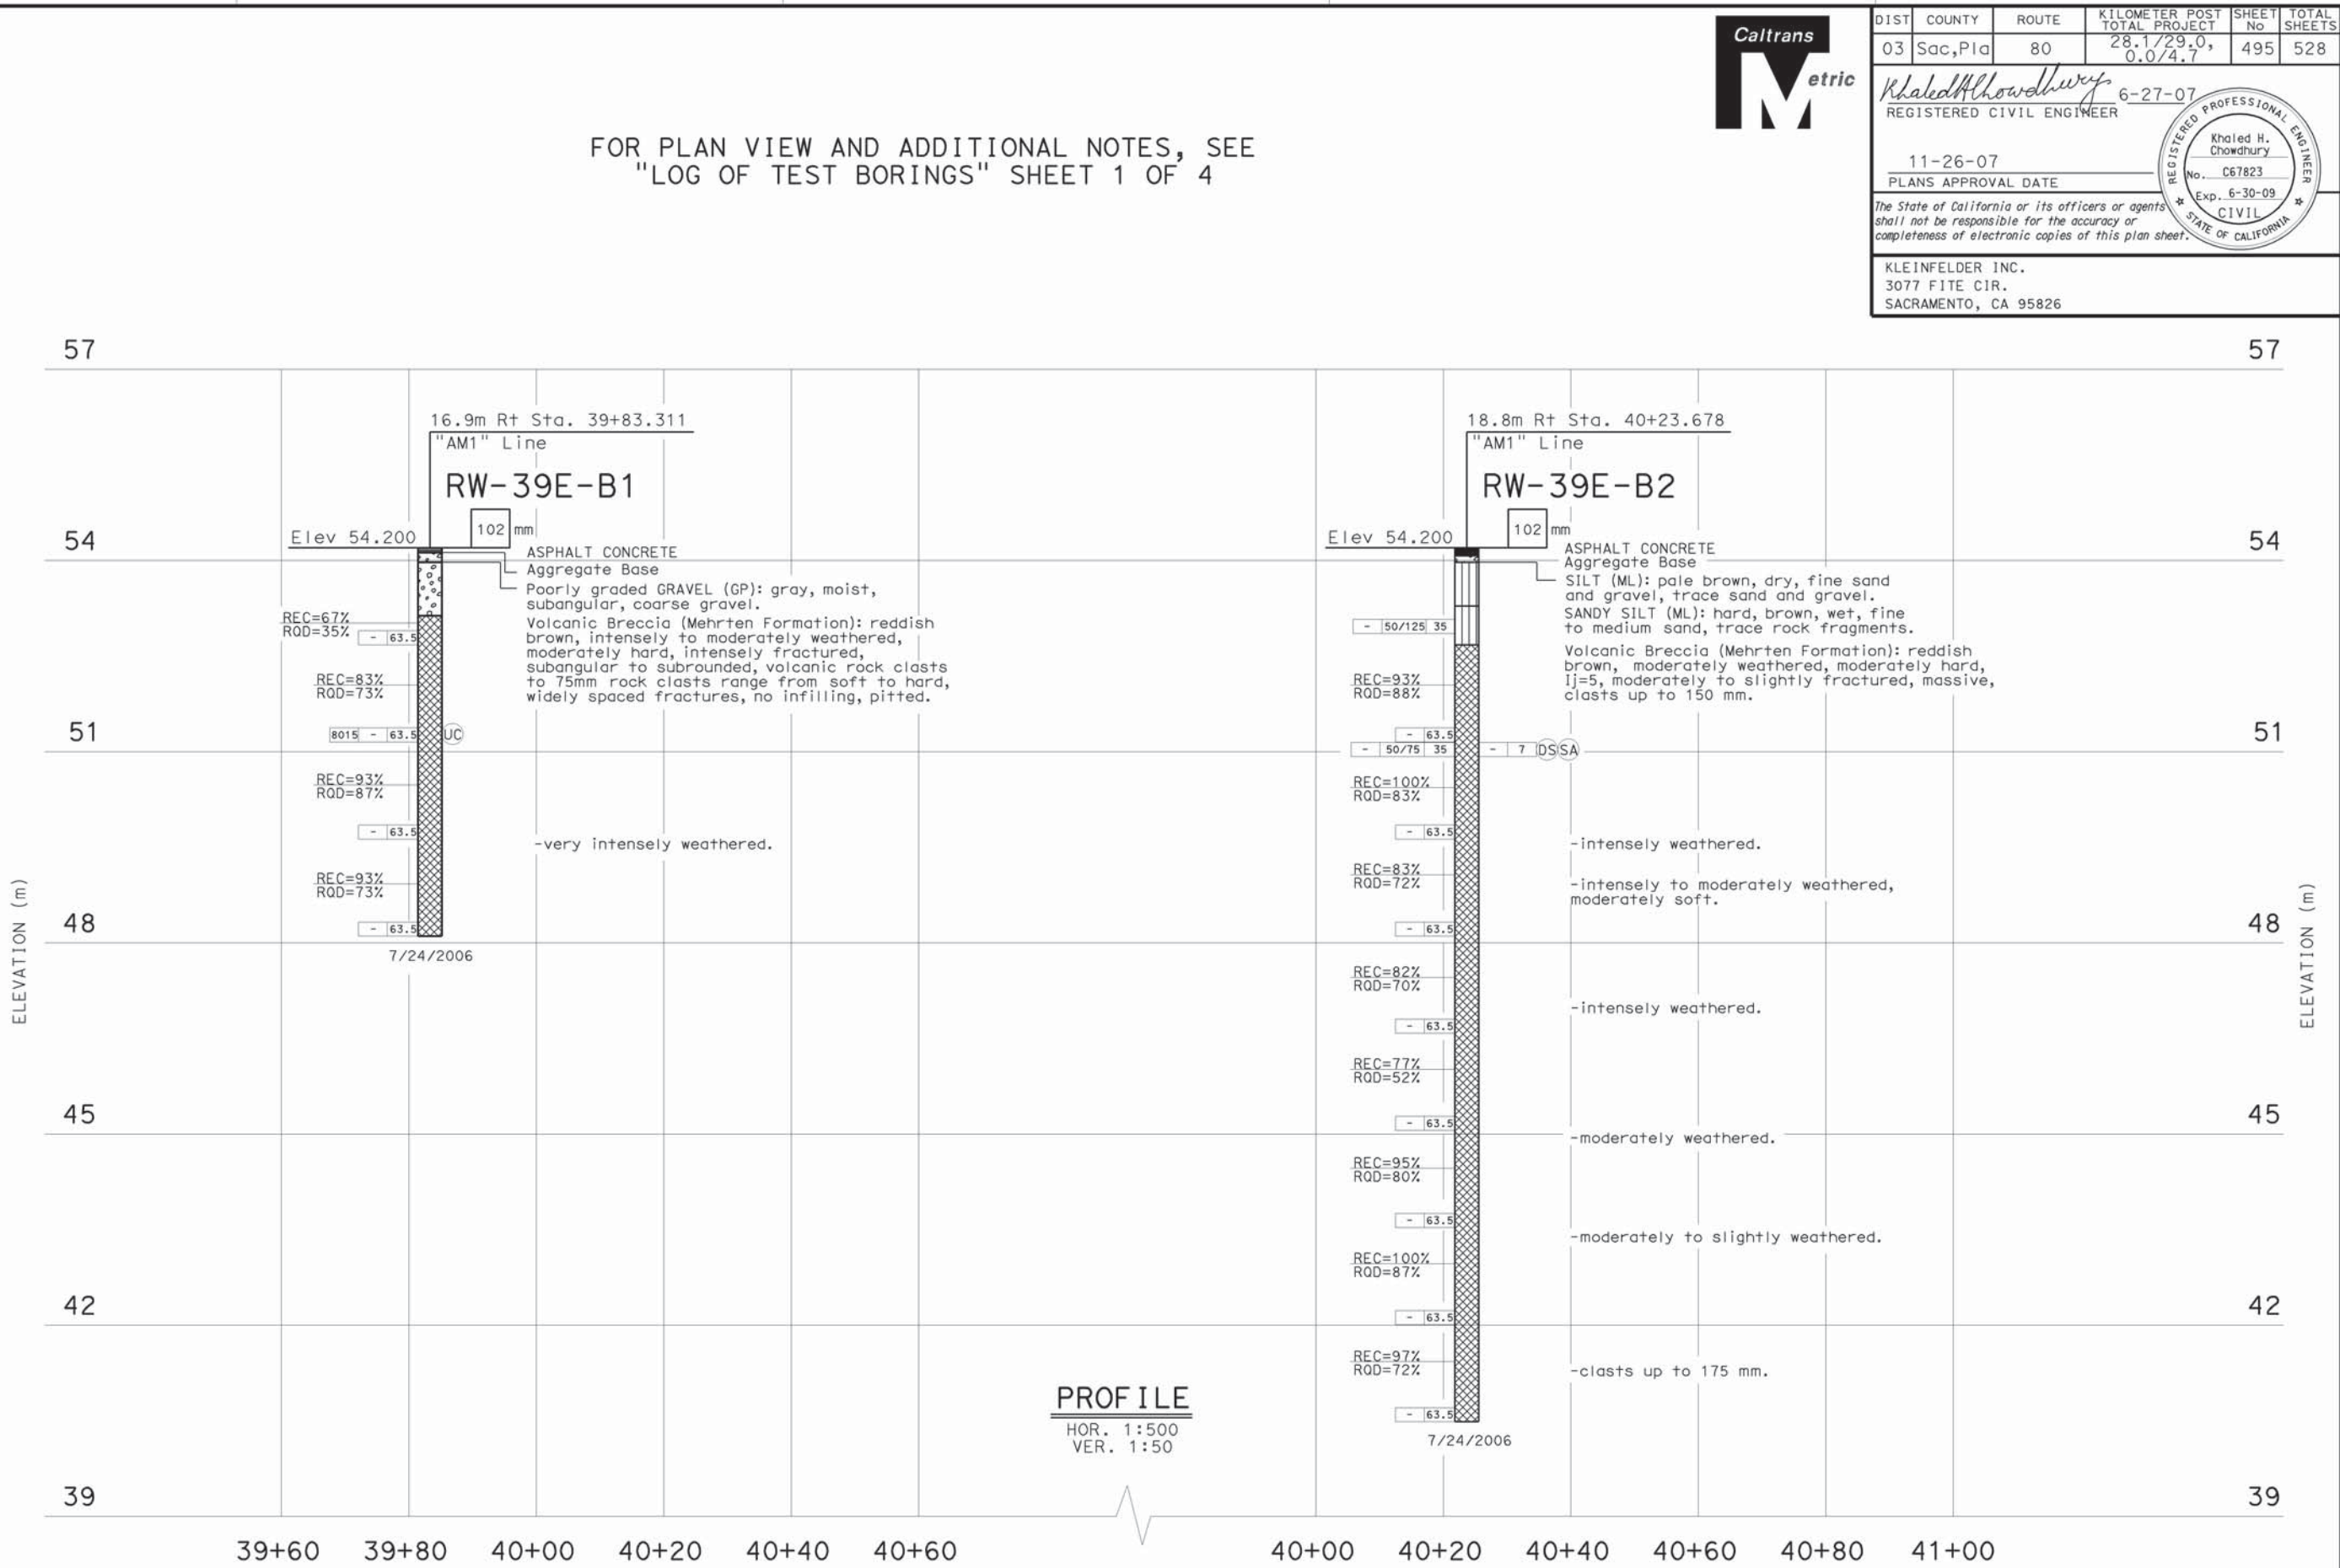

**PROFILE**  
 HOR. 1:500  
 VER. 1:50

D. Britton DESIGN OVERSIGHT June 29, 2007 SIGN OFF DATE	DRAWN BY A. Sanchez	Checked BY B. Anderson, C.E.G.	Kleinfelder, Inc. FIELD INVESTIGATION BY: DATE: December 2006	PREPARED FOR THE STATE OF CALIFORNIA DEPARTMENT OF TRANSPORTATION	K. Chowdhury PROJECT ENGINEER	BRIDGE NO. 19E0005 KILOMETER POST 4.14	<b>RETAINING WALL 39E-41E</b> <b>LOG OF TEST BORINGS 2 OF 6</b>
--	------------------------	-----------------------------------	---	---	----------------------------------	---	--








DIST	COUNTY	ROUTE	KILOMETER POST TOTAL PROJECT	SHEET No	TOTAL SHEETS
03	Sac, Pla	80	28.1/29.0, 0.0/4.7	496	528
Khaled Chowdhury 6-27-07 REGISTERED CIVIL ENGINEER No. C67823 Exp. 6-30-09 CIVIL STATE OF CALIFORNIA					
11-26-07 PLANS APPROVAL DATE					
The State of California or its officers or agents shall not be responsible for the accuracy or completeness of electronic copies of this plan sheet.					
KLEINFELDER INC. 3077 FITE CIR. SACRAMENTO, CA 95826					


FOR PLAN VIEW AND ADDITIONAL NOTES, SEE "LOG OF TEST BORINGS" SHEET 1 OF 4

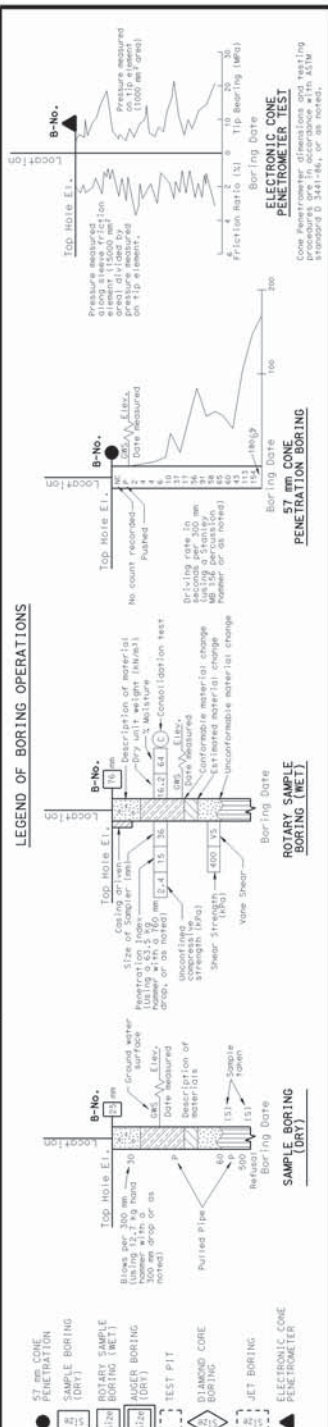

CONSISTENCY CLASSIFICATION FOR SOILS	
According to the Standard Penetration Test	
SPT N-value (blows/30cm)	Soil Consistency
0-4	Very Loose
5-10	Loose
11-20	Medium Dense
21-30	Dense
31-50	Very Dense
50	Hard

LEGEND OF EARTH MATERIALS	
GRAVEL	CLAYEY SILT
SAND	PEAT and/or ORGANIC MATTER
SILT	FILL MATERIAL
CLAY	COBBLE
SANDY CLAY or CLAYEY SAND	INDURATED ROCK
SANDY SILT or SILTY SAND	SEDIMENTARY ROCK
SILTY CLAY	METAMORPHIC

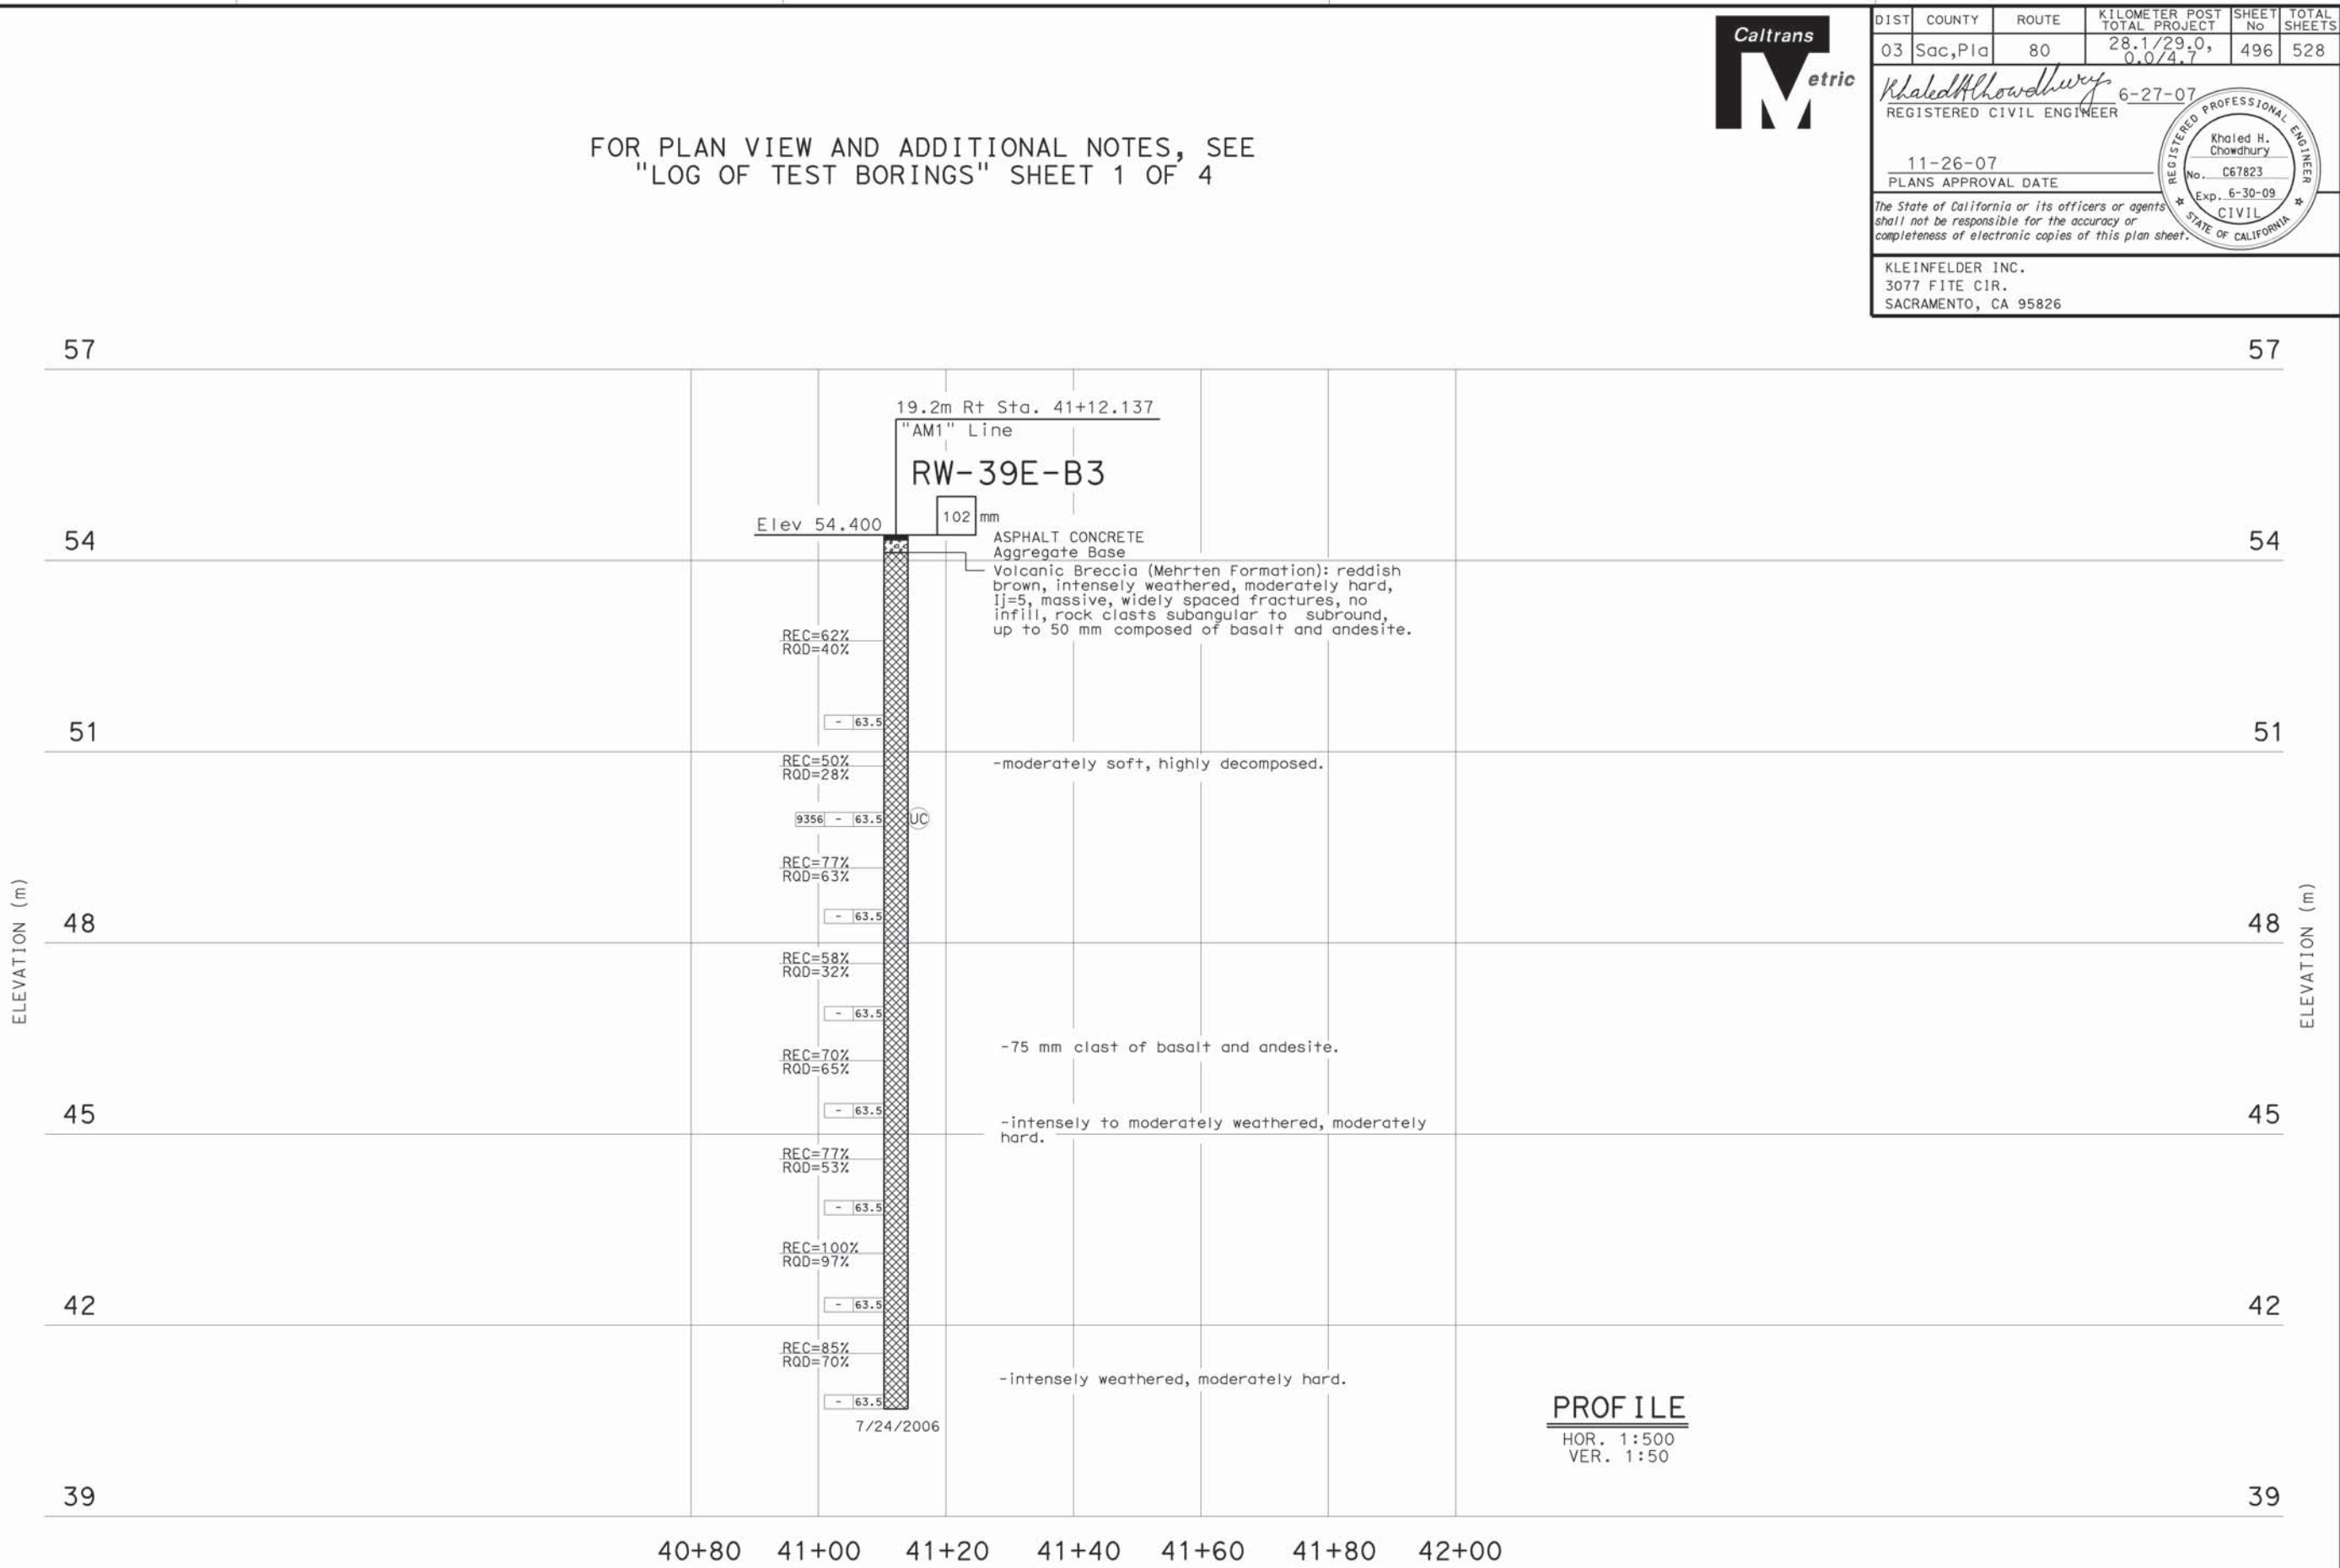

PROFILE  
 HOR. 1:500  
 VER. 1:50

D. Brittsan DESIGN OVERSIGHT June 29, 2007 SIGN OFF DATE	DRAWN BY A. Sanchez	Checked by B. Anderson, C.E.G.	Kleinfelder, Inc. FIELD INVESTIGATION BY: DATE: December 2006	PREPARED FOR THE STATE OF CALIFORNIA DEPARTMENT OF TRANSPORTATION	K Chowdhury PROJECT ENGINEER	BRIDGE NO. 19E0005 KILOMETER POST 4.14	RETAINING WALL 39E-41E LOG OF TEST BORINGS 3 OF 6
---	------------------------	-----------------------------------	---	---	---------------------------------	---	--



DIST	COUNTY	ROUTE	KILOMETER TOTAL PROJECT	POST PROJECT	SHEET No	TOTAL SHEETS
03	Sac, Pla	80	28.1/29.0	0.0/4.7	497	528


Khaled H. Chowdhury  
 6-27-07  
 REGISTERED CIVIL ENGINEER  
 No. C67823  
 Exp. 6-30-09  
 CIVIL  
 STATE OF CALIFORNIA

11-26-07  
 PLANS APPROVAL DATE

The State of California or its officers or agents shall not be responsible for the accuracy or completeness of electronic copies of this plan sheet.

KLEINFELDER INC.  
 3077 FITE CIR.  
 SACRAMENTO, CA 95826

FOR PLAN VIEW AND ADDITIONAL NOTES, SEE "LOG OF TEST BORINGS" SHEET 1 OF 4

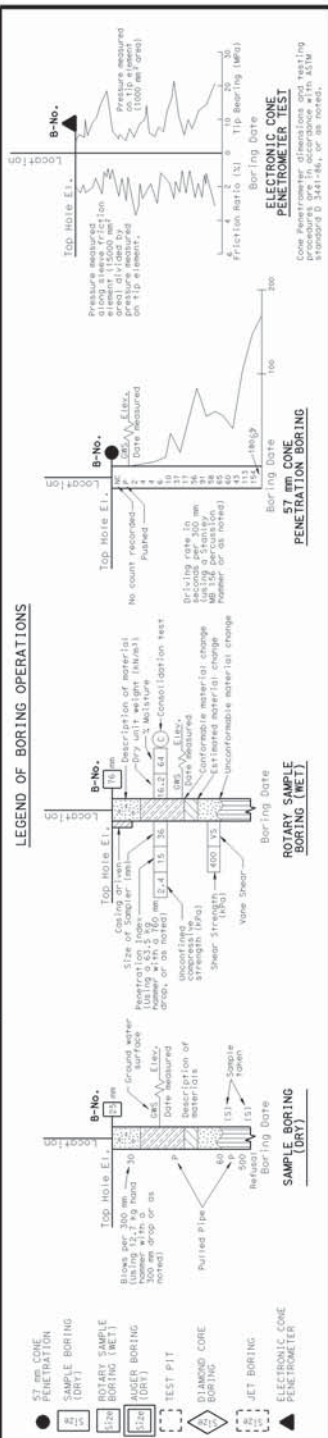


**LEGEND OF EARTH MATERIALS**

CLAYEY SILT	PEAT and/or ORGANIC MATTER	FILL MATERIAL	COBBLE	LOOSE ROCK
SAND	SILT	CLAY	SANDY CLAY or CLAYEY SAND	SEDIMENTARY ROCK
GRAVEL	SAND	SILT	CLAY	SANDY SILT or SILTY SAND
SANDY CLAY or CLAYEY SAND	SILT	CLAY	SANDY SILT or SILTY SAND	SILT CLAY

**CONSISTENCY CLASSIFICATION FOR SOILS**

SP	NP	US	US	US	US	US	US	US	US
0-4	5-10	11-30	31-50	50	0-4	5-10	11-30	31-50	50
Very Loose	Loose	Medium Dense	Dense	Very Dense	Very Soft	Soft	Firm	Stiff	Hard

NOTE: Classification of earth material as shown on this sheet is based upon field inspection and is not to be construed to imply mechanical analysis.

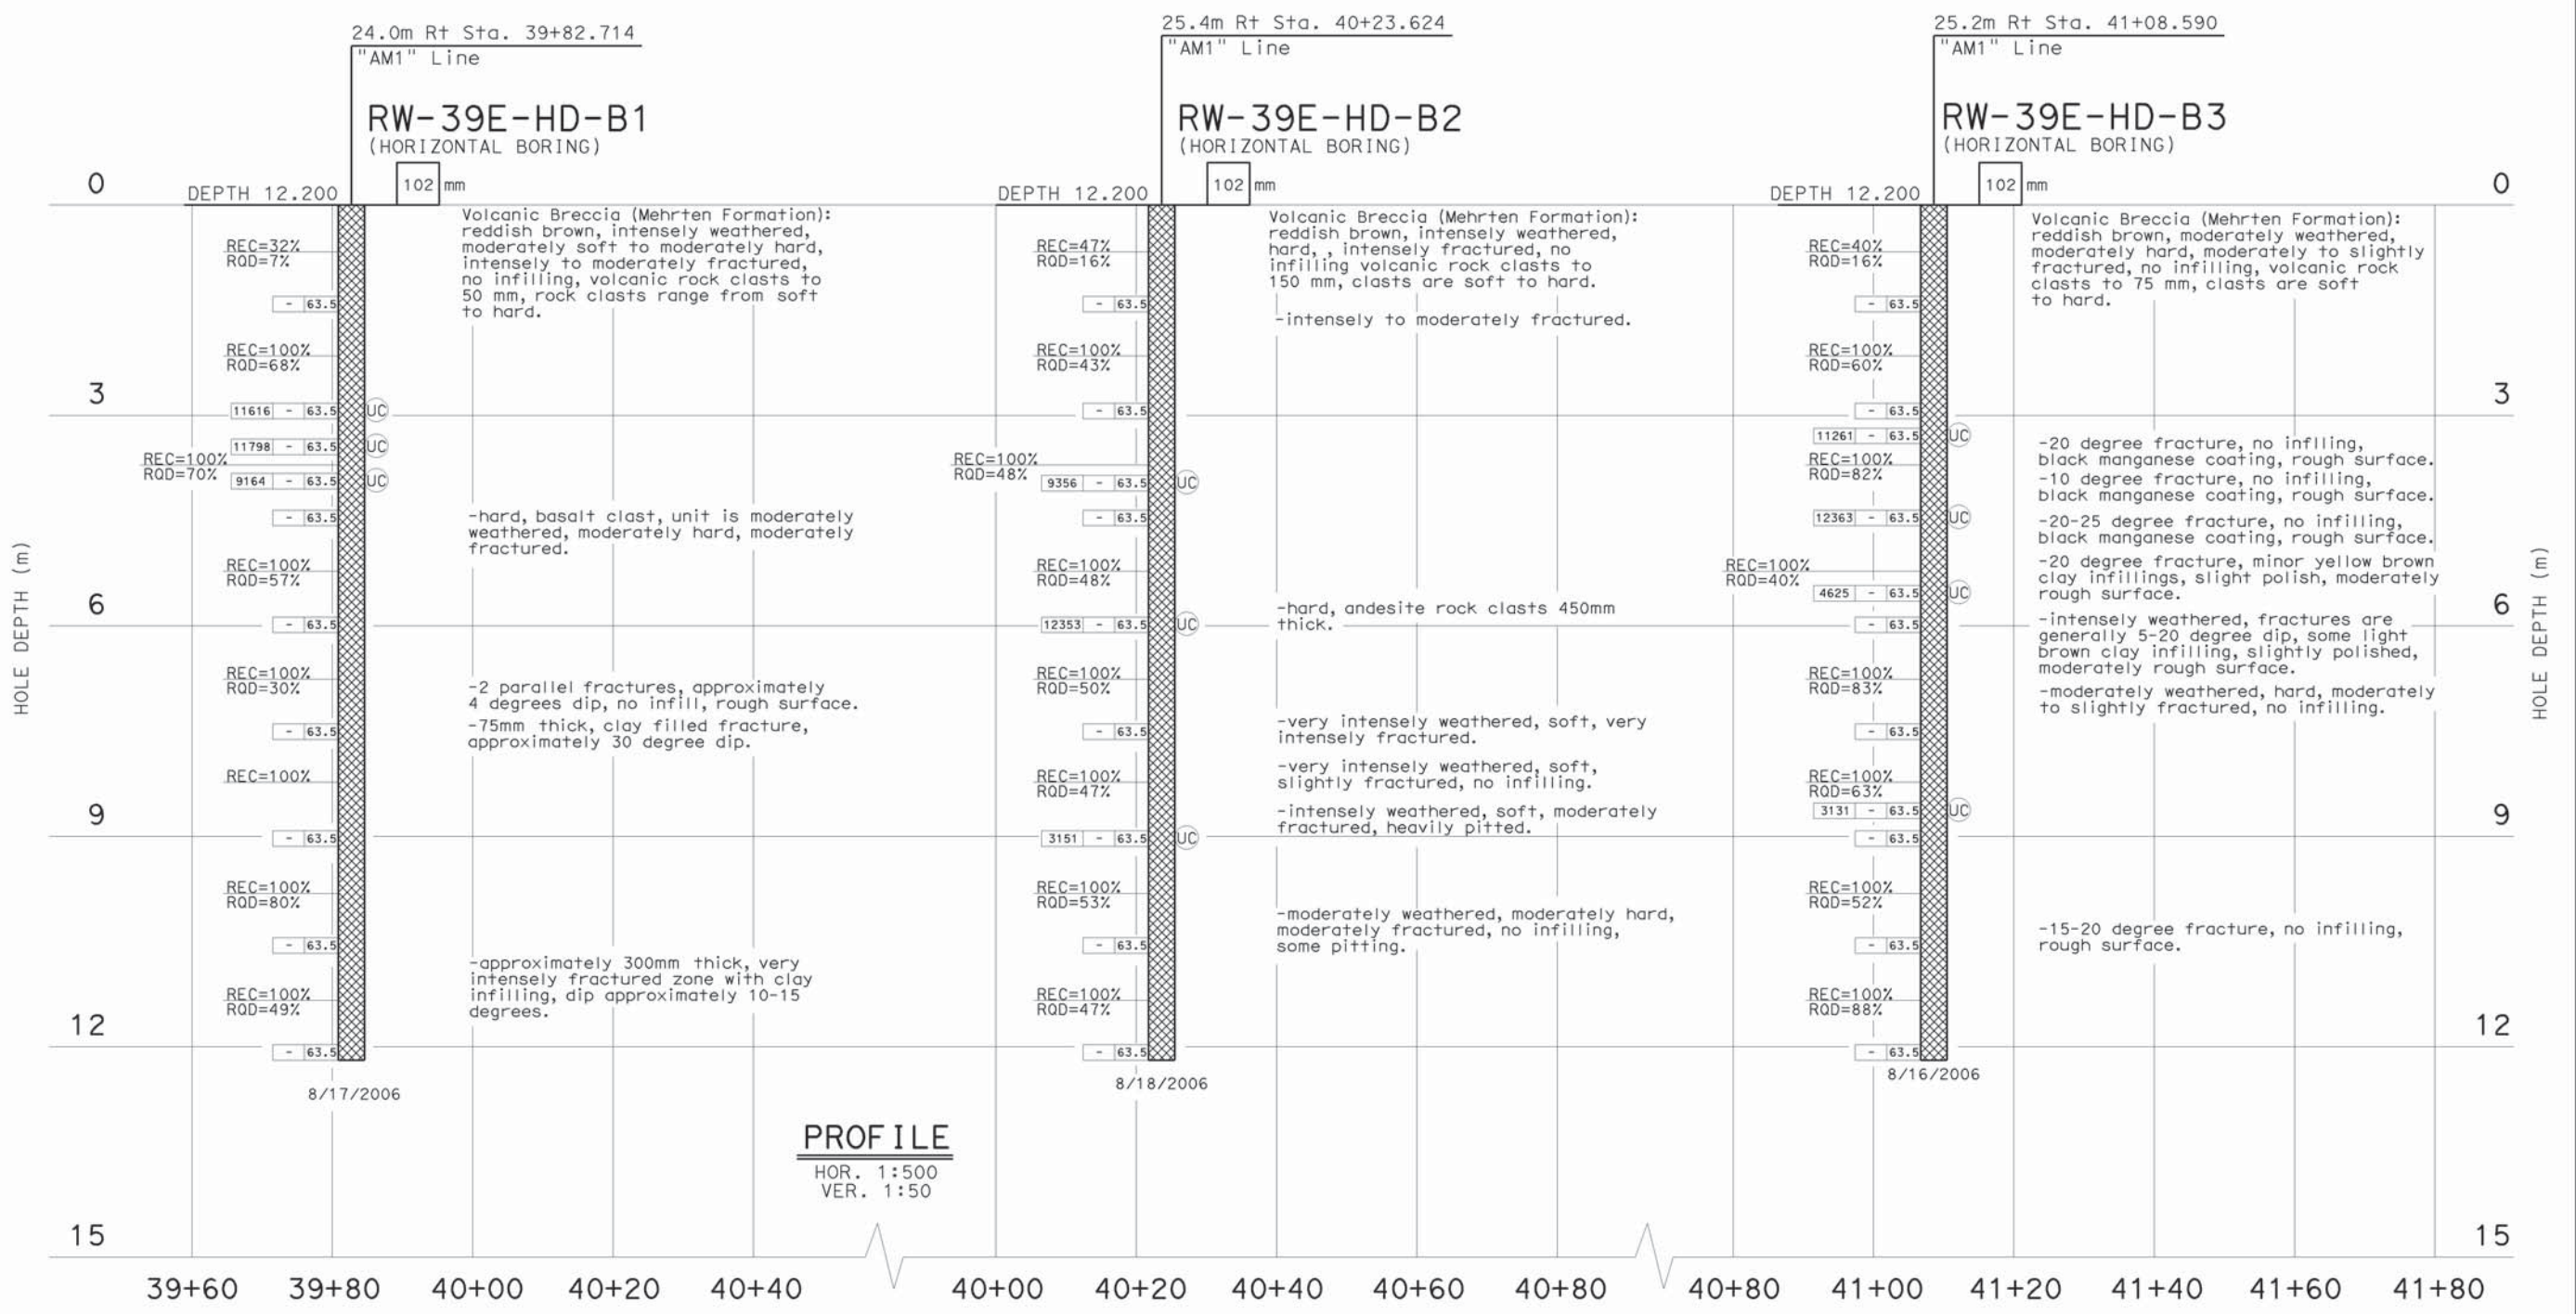

D. Brittsan DESIGN OVERSIGHT June 29, 2007 SIGN OFF DATE	DRAWN BY A. Sanchez	Checked By B. Anderson, C.E.G.	Kleinfelder, Inc. FIELD INVESTIGATION BY: DATE: December 2006	PREPARED FOR THE STATE OF CALIFORNIA DEPARTMENT OF TRANSPORTATION	K Chowdhury PROJECT ENGINEER	BRIDGE NO. 19E005 KILOMETER POST 4.14	<b>RETAINING WALL 39E-41E</b> <b>LOG OF TEST BORINGS 4 OF 6</b>
---	------------------------	-----------------------------------	---	---	---------------------------------	--	--

**LEGEND OF BORING OPERATIONS**

**LEGEND OF EARTH MATERIALS**


**CONSISTENCY CLASSIFICATION FOR SOILS**

**LEGEND OF BORING OPERATIONS**


**LEGEND OF EARTH MATERIALS**

**CONSISTENCY CLASSIFICATION FOR SOILS**

NOTE: Classification of earth material as shown on this sheet is based upon field inspection and is not to be construed to imply mechanical analysis.

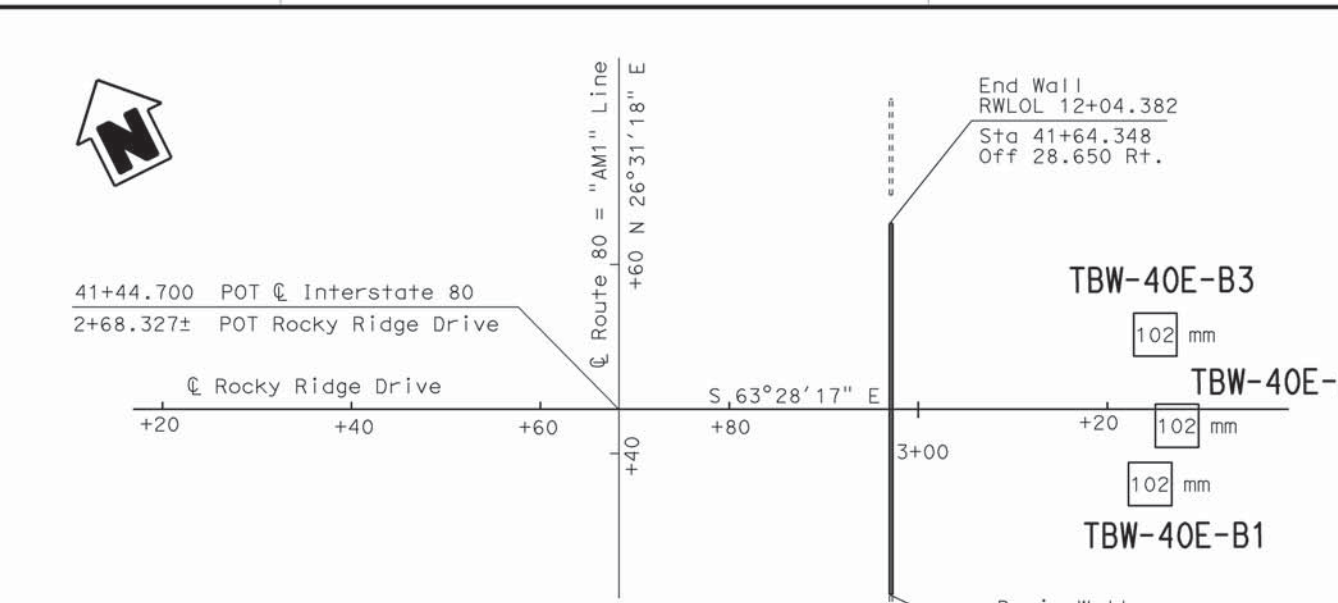

**PLAN**  
1:400

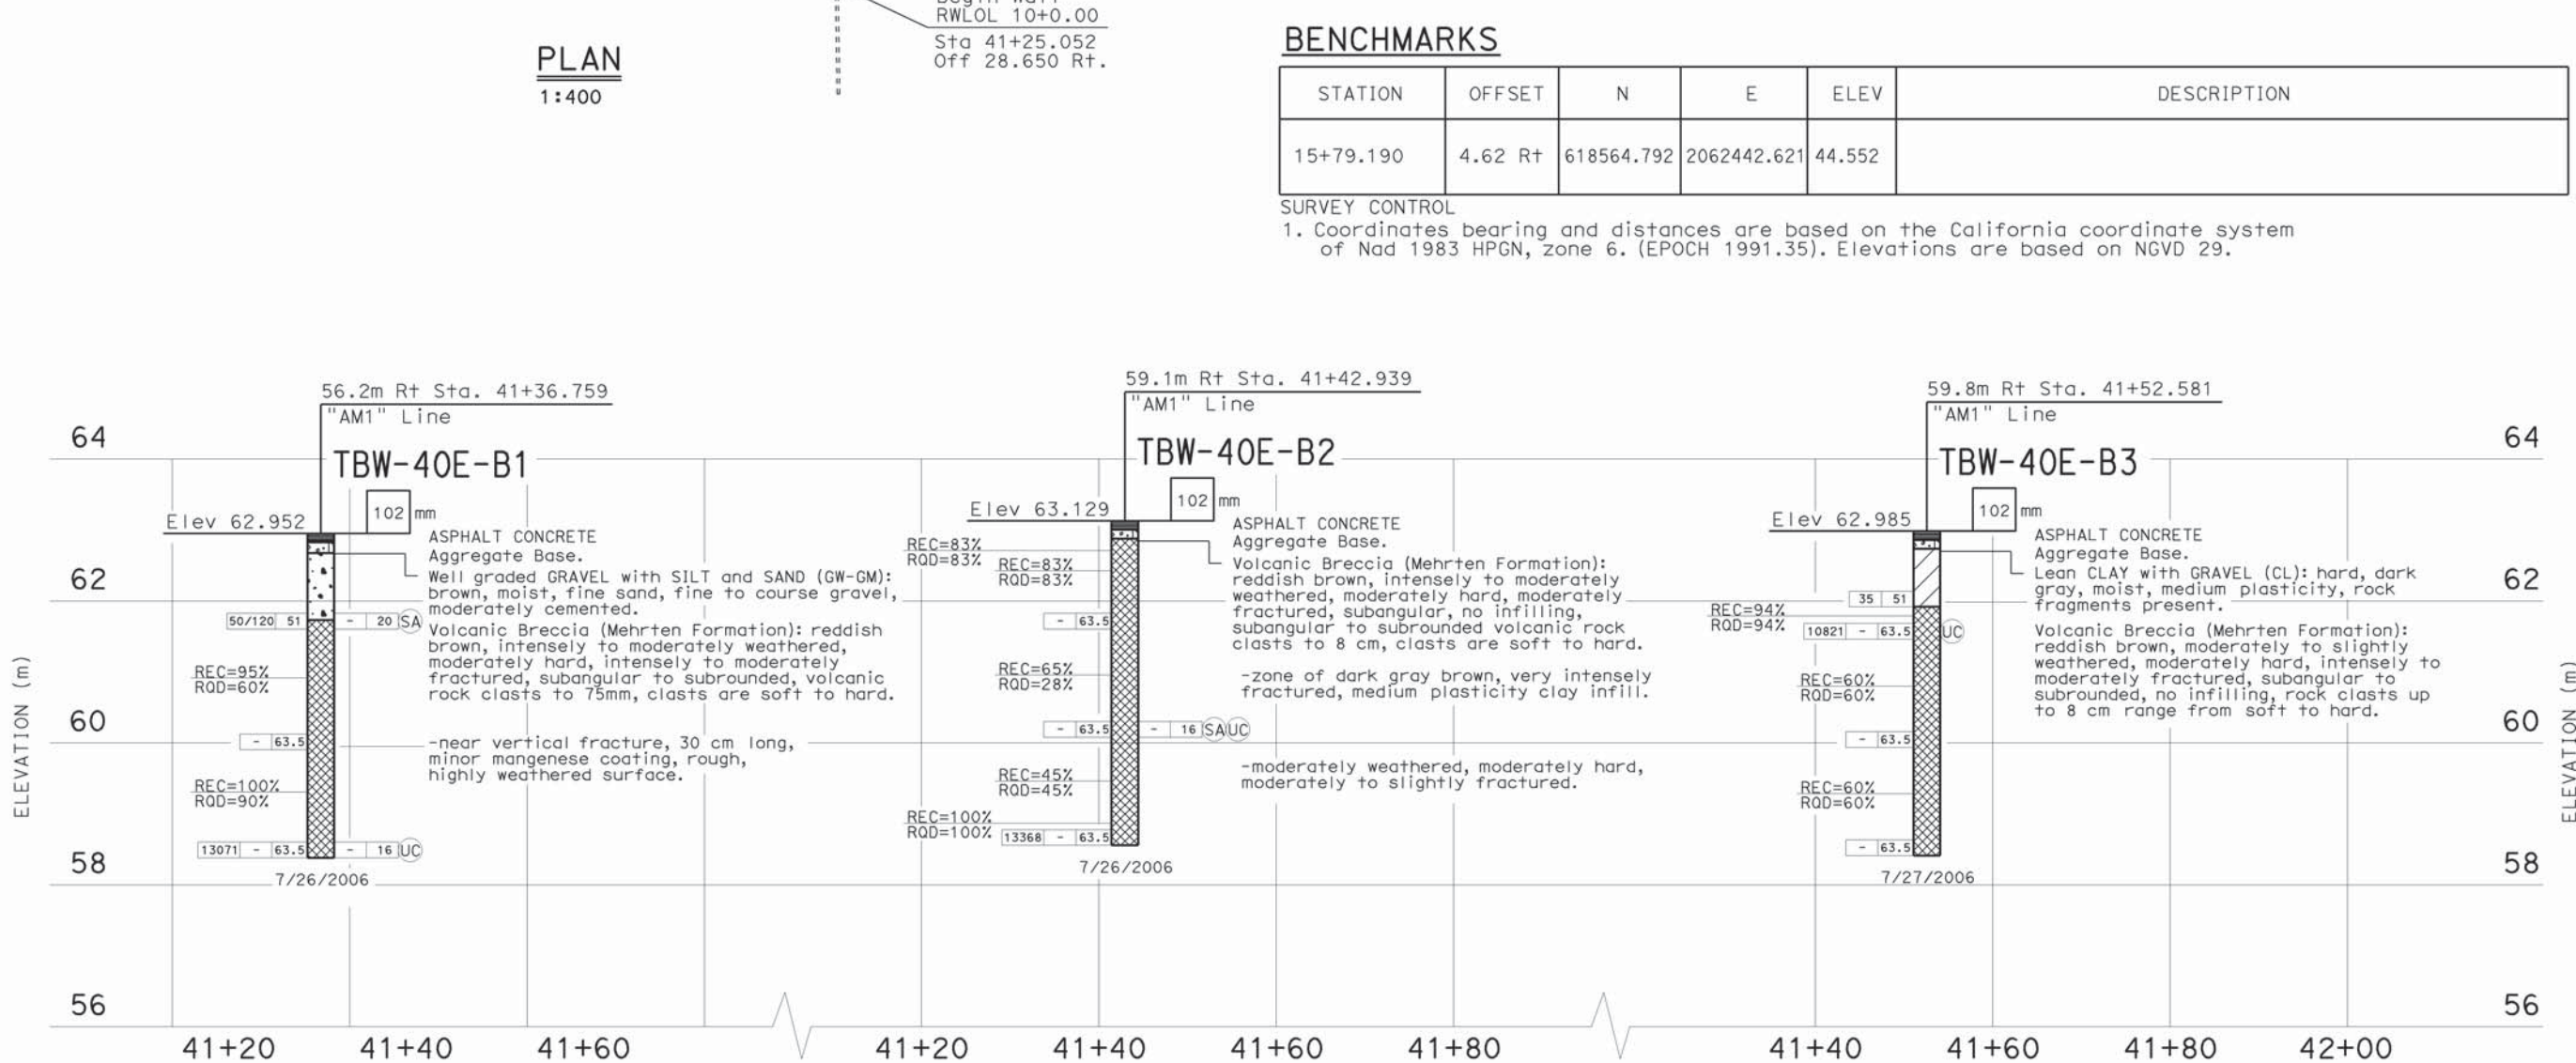

**PROFILE**  
HOR. 1:400  
VER. 1:50

**Notes:**

- 51 mm samples were taken using a California split-barrel sampler with an inside diameter (I.D.) of 51 mm and an outside diameter (O.D.) of 64 mm.
- A safety semi-automatic hammer (63.5 kg) with a 760 mm drop was used to advance the sampler.
- Blowcounts noted for boring are field blowcounts and have not been corrected.
- 35 mm samples were taken using a SPT split-barrel sampler with an inside diameter (I.D.) of 35 mm and an outside diameter (O.D.) of 51 mm.
- 63.5 mm core samples were taken using an HQ core sampler with a 63.5 mm inside diameter (I.D.) and 94 mm outside diameter (O.D.) core barrel.
- Blowcounts 50/125 means 50 blows per 125 mm penetration.

**BENCHMARKS**

STATION	OFFSET	N	E	ELEV	DESCRIPTION
15+79.190	4.62 Rt	618564.792	2062442.621	44.552	

**SURVEY CONTROL**

- Coordinates bearing and distances are based on the California coordinate system of Nad 1983 HPGN, zone 6. (EPOCH 1991.35). Elevations are based on NGVD 29.



DIST	COUNTY	ROUTE	KILOMETER POST TOTAL PROJECT	SHEET No	TOTAL SHEETS
03	Sac, Plq	80	28.1/29.0, 0.0/4.7	498	528

**REGISTERED CIVIL ENGINEER**  
Khaled H. Chowdhury  
No. C67823  
Exp. 6-30-09  
CIVIL  
STATE OF CALIFORNIA

6-27-07  
11-26-07  
PLANS APPROVAL DATE

The State of California or its officers or agents shall not be responsible for the accuracy or completeness of electronic copies of this plan sheet.

KLEINFELDER INC.  
3077 FITE CIR.  
SACRAMENTO, CA 95826

D. Brittsan DESIGN OVERSIGHT June 29, 2007 SIGN OFF DATE	DRAWN BY A. Sanchez	Checked BY B. Anderson, C.E.G.	Kleinfelder, Inc. FIELD INVESTIGATION BY: DATE: December 2006	PREPARED FOR THE STATE OF CALIFORNIA DEPARTMENT OF TRANSPORTATION	K. Chowdhury PROJECT ENGINEER	BRIDGE NO. 19E0005 KILOMETER POST 4.14	<b>RETAINING WALL 39E-41E</b> <b>LOG OF TEST BORINGS 5 OF 6</b>
---	------------------------	-----------------------------------	---	---	----------------------------------	---	--



DIST	COUNTY	ROUTE	KILOMETER TOTAL PROJECT	POST PROJECT	SHEET No	TOTAL SHEETS
03	Sac, Pla	80	28.1/29.0	0.0/4.7	499	528

Khaled H. Chowdhury 6-27-07  
 REGISTERED CIVIL ENGINEER  
 11-26-07  
 PLANS APPROVAL DATE  
 The State of California or its officers or agents shall not be responsible for the accuracy or completeness of electronic copies of this plan sheet.  
 KLEINFELDER INC.  
 3077 FITE CIR.  
 SACRAMENTO, CA 95826

**LEGEND OF BORING OPERATIONS**

**ELECTRONIC CONE PENETROMETER TEST**  
 Cone Penetrometer dimensions and testing standards: ASTM D 1586, or as noted.


**57 mm CONE PENETRATION BORING**  
 No. count recorded  
 Friction ratio (kN/m<sup>2</sup>)  
 Tip resistance (kN/m<sup>2</sup>)  
 Friction ratio (lb/in<sup>2</sup>)  
 Tip resistance (lb/in<sup>2</sup>)

**ROTARY SAMPLE BORING (WET)**  
 Description of material  
 Size of sample  
 Location of sample  
 No. of samples  
 No. of blow counts  
 No. of blow counts per 150 mm  
 No. of blow counts per 300 mm  
 No. of blow counts per 450 mm  
 No. of blow counts per 600 mm  
 No. of blow counts per 750 mm  
 No. of blow counts per 900 mm  
 No. of blow counts per 1050 mm  
 No. of blow counts per 1200 mm  
 No. of blow counts per 1350 mm  
 No. of blow counts per 1500 mm  
 No. of blow counts per 1650 mm  
 No. of blow counts per 1800 mm  
 No. of blow counts per 1950 mm  
 No. of blow counts per 2100 mm  
 No. of blow counts per 2250 mm  
 No. of blow counts per 2400 mm  
 No. of blow counts per 2550 mm  
 No. of blow counts per 2700 mm  
 No. of blow counts per 2850 mm  
 No. of blow counts per 3000 mm

**LEGEND OF EARTH MATERIALS**

**CONSISTENCY CLASSIFICATION FOR SOILS**  
 According to the Standard Penetration Test  
 SPT N-value  
 Cohesive  
 Non-cohesive  
 Very Loose  
 Loose  
 Medium Dense  
 Dense  
 Very Dense  
 Very Soft  
 Soft  
 Firm  
 Stiff  
 Very Stiff  
 Hard

**NOTE:** Classification of earth material as shown on this sheet is based upon field inspection and is not to be construed to imply mechanical analysis.

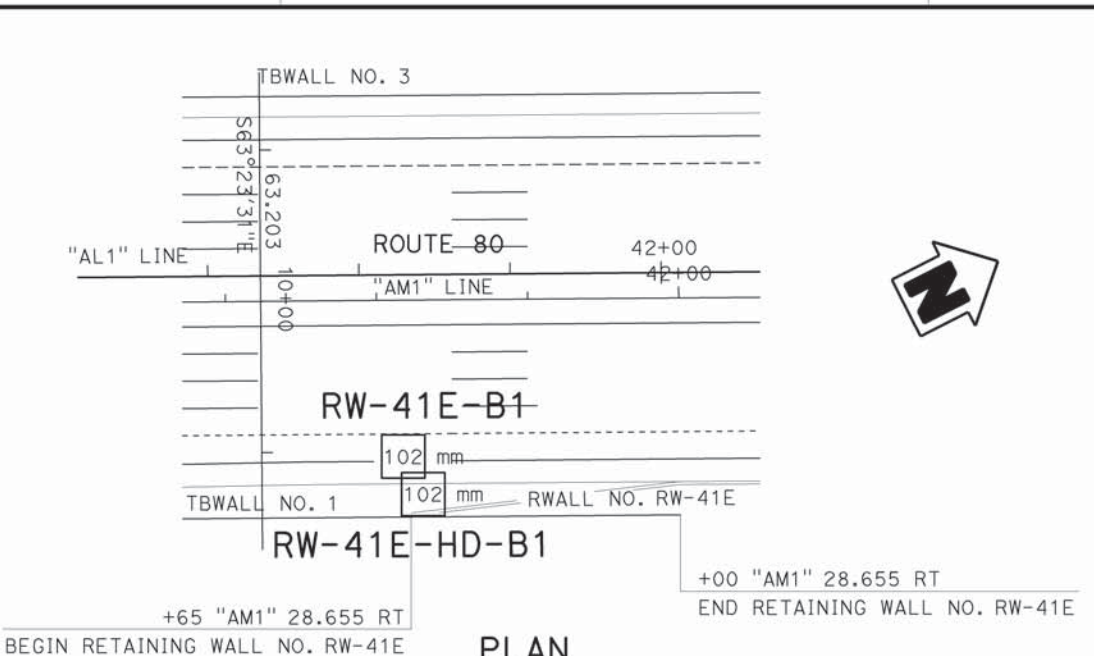

**PLAN**  
1:500

**BENCHMARKS**

STATION	OFFSET	N	E	ELEV	DESCRIPTION
15+79.190	4.62 Rt	618564.792	2062442.621	44.552	



**SURVEY CONTROL**

1. Coordinates bearing and distances are based on the California coordinate system of Nad 1983 HPGN, zone 6. (EPOCH 1991.35). Elevations are based on NGVD 29.

+65 "AM1" 28.655 RT  
 BEGIN RETAINING WALL NO. RW-41E

+00 "AM1" 28.655 RT  
 END RETAINING WALL NO. RW-41E

- Notes:**
- 51 mm samples were taken using a California split-barrel sampler with an inside diameter (I.D.) of 51 mm and an outside diameter (O.D.) of 64 mm.
  - A safety semi-automatic hammer (63.5 kg) with a 760 mm drop was used to advance the sampler.
  - Blowcounts noted for boring are field blowcounts and have not been corrected.
  - 35 mm samples were taken using a SPT split-barrel sampler with an inside diameter (I.D.) of 35 mm and an outside diameter (O.D.) of 51 mm.
  - 63.5 mm core samples were taken using an HQ core sampler with a 63.5 mm inside diameter (I.D.) and 94 mm outside diameter (O.D.) core barrel.
  - Blowcounts 50/125 means 50 blows per 125 mm penetration.
  - Horizontal Borings were started approximately 1.5m above adjacent shoulder grade and inclined downward at a 10 degree angle. Horizontal borings intersect shoulder grade at a depth of approximately 8.8 meters.

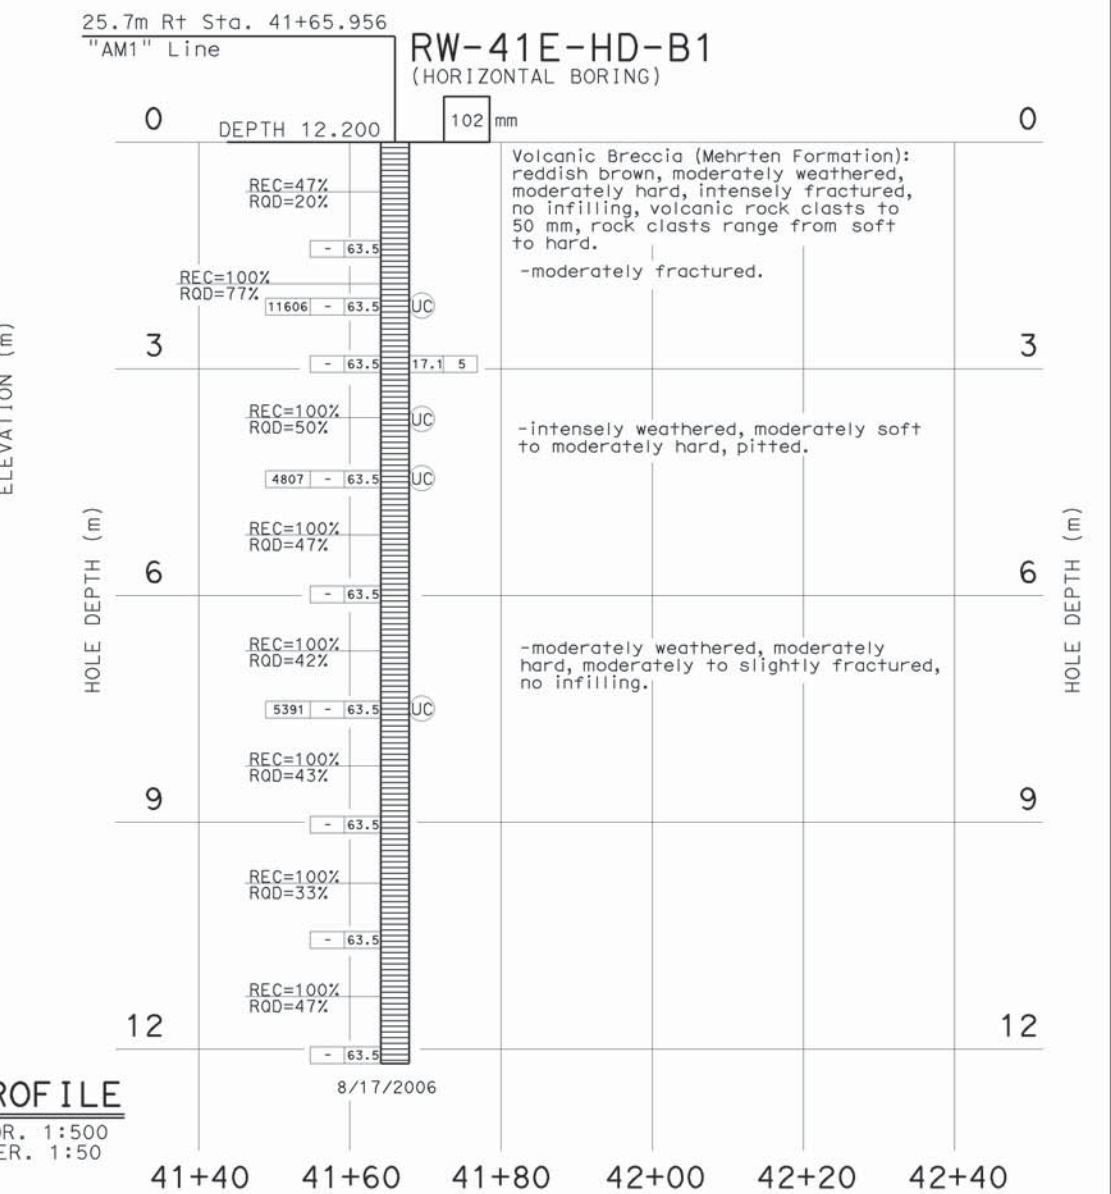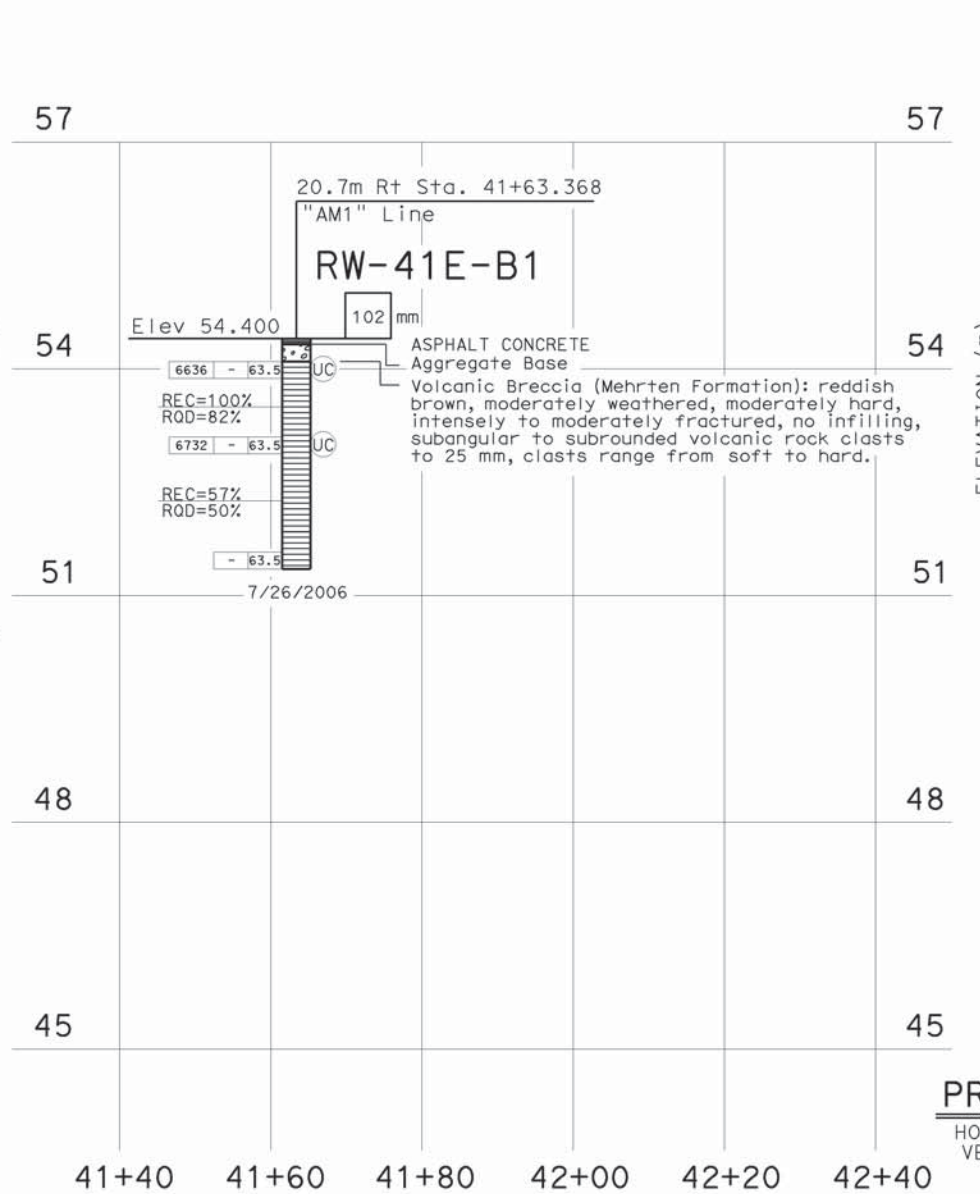

**PROFILE**  
 HOR. 1:500  
 VER. 1:50

DESIGN OVERSIGHT D. Britton June 29, 2007 SIGN OFF DATE	DRAWN BY A. Sanchez	CHECKED BY B. Anderson, C.E.G.	Kleinfelder, Inc. FIELD INVESTIGATION BY: DATE: December 2006	BRIDGE NO. 19E0005	KILOMETER POST 4.14	PROJECT ENGINEER K. Chowdhury	<b>RETAINING WALL 39E-41E</b> <b>LOG OF TEST BORING 6 OF 6</b>
--	------------------------	-----------------------------------	---	-----------------------	------------------------	----------------------------------	---





DIST	COUNTY	ROUTE	KILOMETER POST TOTAL PROJECT	SHEET No	TOTAL SHEETS
03	Sac, Pla	80	28.1/29.0 0.0/4.7	521	528

**Khaled H. Chowdhury** 6-27-07  
REGISTERED CIVIL ENGINEER

11-26-07  
PLANS APPROVAL DATE

*The State of California or its officers or agents shall not be responsible for the accuracy or completeness of electronic copies of this plan sheet.*

KLEINFELDER INC.  
3077 FITE CIR.  
SACRAMENTO, CA 95826

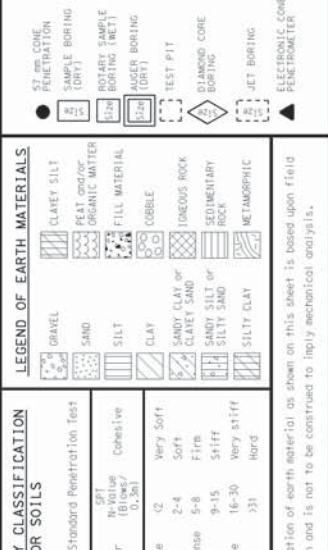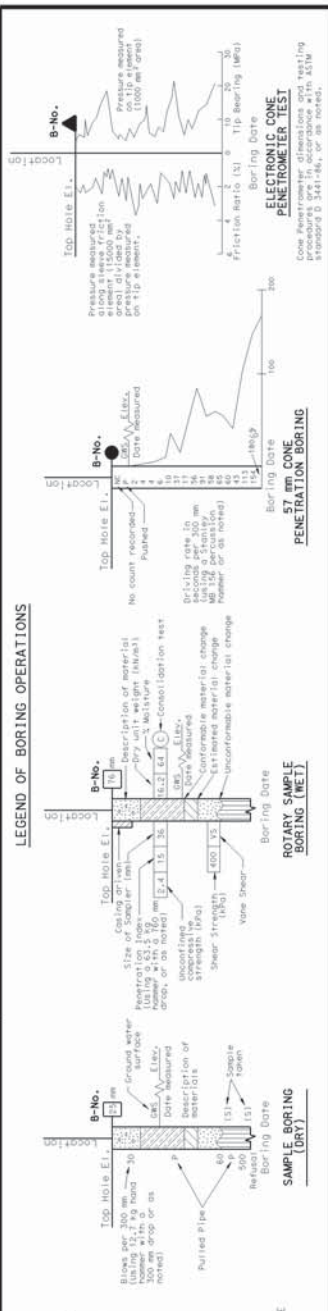

**CONSISTENCY CLASSIFICATION FOR SOILS**

According to the Standard Penetration Test

SPT	Relative Density (D <sub>r</sub> )	Consistency
0-4	Very Loose	Very Soft
5-10	Loose	Soft
11-20	Medium Dense	Firm
21-30	Dense	Stiff
31-50	Very Dense	Very Stiff
50		Hard

NOTE: Classification of earth material as shown on this sheet is based upon field inspection and is not to be construed to imply mechanical analysis.

Descriptors		Diagnostic features				Texture and solutioning		General characteristics (strength, excavation, etc.) <sup>§</sup>
Alphanumeric descriptor	Descriptive term	Chemical weathering-Discoloration and/or oxidation	Mechanical weathering-Grain boundary conditions (disaggregation) primarily for granitics and some coarse-grained sediments	Texture	Solutioning	Texture	Solutioning	
W1	Fresh	No discoloration, not oxidized.	No discoloration or oxidation.	No separation, intact (tight).	No change.	No solutioning.	Hammer rings when crystalline rocks are struck. Almost always rock excavation except for naturally weak or weakly cemented rocks such as siltstones or shales.	
W2	Slightly weathered to fresh <sup>o</sup>							
W3	Slightly weathered	Discoloration or oxidation is limited to surface of, or short distance from, fractures; some feldspar crystals are dull.	Minor to complete discoloration or oxidation of most surfaces.	No visible separation, intact (tight).	Preserved.	Minor leaching of some soluble minerals may be noted.	Hammer rings when crystalline rocks are struck. Body of rock not weakened. With few exceptions, such as siltstones or shales, classified as rock excavation.	
W4	Moderately to slightly weathered <sup>o</sup>							
W5	Moderately weathered	Discoloration or oxidation extends from fractures; Fe-Mg minerals are "rusty," feldspar crystals are "cloudy."	All fracture surfaces are discolored or oxidized.	Partial separation of boundaries visible.	Generally preserved.	Soluble minerals may be mostly leached.	Hammer does not ring when rock is struck. Body of rock is slightly weakened. Depending on fracturing, usually is rock excavation except in naturally weak rocks such as siltstones or shales.	
W6	Intensely to moderately weathered <sup>o</sup>							
W7	Intensely weathered	Discoloration or oxidation throughout; all feldspars and Fe-Mg minerals are altered to clay to some extent; or chemical alteration produces in-situ disaggregation, see grain boundary conditions.	All fracture surfaces are discolored or oxidized, surfaces friable.	Partial separation, rock is friable; in semi-arid conditions granitics are disaggregated.	Texture altered by chemical disintegration (hydration, argillation).	Leaching of soluble minerals may be complete.	Dull sound when struck with hammer, usually can be broken with moderate to heavy manual pressure or by light hammer blow without reference to planes of weakness such as incipient or hairline fractures, or veinlets. Rock is significantly weakened. Usually common excavation.	
W8	Very intensely weathered							
W9	Decomposed	Discolored or oxidized throughout, but resistant minerals such as quartz may be unaltered; all feldspars and Fe-Mg minerals are completely altered to clay.		Complete separation of grain boundaries (disaggregated).	Resembles a soil, partial or complete remnant rock structure may be preserved; leaching of soluble minerals usually complete.		Can be granulated by hand, always common excavation. Resistant minerals such as quartz may be present as "stringers" or "dikes."	

Note: This chart and its horizontal categories are more readily applied to rocks with feldspars and mafic minerals. Weathering in various sedimentary rocks, particularly limestones and poorly indurated sediments, will not always fit the categories established. This chart and weathering categories may have to be modified for particular site conditions or alteration such as hydrothermal effects; however, the basic framework and similar descriptors are to be used.


<sup>o</sup> Combination descriptors are permissible where equal distribution of both weathering characteristics are present over significant intervals or where characteristics present are "in between" the diagnostic features. However, dual descriptors should not be used where significant, identifiable zones can be delineated. When given as a range, only two adjacent terms may be combined. "Decomposed to slightly weathered," or "moderately weathered to fresh" are not acceptable.

<sup>1</sup> Does not include diffractonal weathering along shears or faults and their associated features. For example, a shear zone that carried weathering to great depths into a fresh rock mass would not require the rock mass to be classified as weathered.

<sup>§</sup> These are generalizations and should not be used as diagnostic features for weathering or excavation classification. These characteristics vary to a large extent based on naturally weak materials or cementation and type of excavation.

FRACTURE DENSITY	
FRACTURE DENSITY- Based on the spacing of all natural fractures in an exposure or core recovery lengths in boreholes; excludes mechanical breaks, shears, and shear zones; however, shear-distributed zones (fracturing outside the shear) are included. Descriptors for fracture density apply to all rock exposures such as tunnel walls, adobe trenches, outcrops, or foundation cut slopes and inverts, as well as boreholes. Descriptive criteria presented below are based on borehole cores where lengths are measured along the core axis, for other exposures the criteria is distance measured between fractures (size of blocks).	
UNFRACTURED (FD0): No fractures.	
VERY SLIGHTLY FRACTURED (FD1): Core recovered mostly in lengths greater than 1 m.	
SLIGHTLY TO VERY SLIGHTLY FRACTURED (FD2)*	
SLIGHTLY FRACTURED (FD3): Core recovered mostly in lengths from 300 to 1000 mm, with few scattered lengths less than 300 mm or greater than 1000 mm.	
MODERATELY TO SLIGHTLY FRACTURED (FD4)*	
MODERATELY FRACTURED (FD5): Core recovered mostly in 100 to 300 mm lengths with most lengths about 200 mm.	
INTENSELY TO MODERATELY FRACTURED (FD6)*	
INTENSELY FRACTURED (FD7): Lengths average from 30 to 100 mm with scattered fragmented intervals. Core recovered mostly in lengths less than 100 mm.	
VERY INTENSELY TO INTENSELY FRACTURED (FD8)*	
VERY INTENSELY FRACTURED (FD9): Core recovered mostly as chips and fragments with a few scattered short core lengths.	
* Combinations of fracture densities (e.g. very intensely to intensely fractured, or moderately to slightly fractured) are used where equal distribution of both fracture density characteristics are present over a significant interval or exposure, or where characteristics are "in between" the descriptor definitions.	

ROCK HARDNESS/STRENGTH DESCRIPTORS		
Alphanumeric Descriptor	Descriptor	Criteria
H1	Extremely hard	Core, fragment, or exposure cannot be scratched with knife or sharp pick; can only be chipped with repeated heavy hammer blows.
H2	Very hard	Cannot be scratched with knife or sharp pick. Core or fragment breaks with repeated heavy hammer blows.
H3	Hard	Can be scratched with knife or sharp pick with difficulty (heavy pressure). Heavy hammer blow required to break specimen.
H4	Moderately hard	Can be scratched with knife or sharp pick with light or moderate pressure. Core or fragment breaks with moderate hammer blow.
H5	Moderately soft	Can be grooved 2 mm deep by knife or sharp pick with moderate or heavy pressure. Core or fragment breaks with light hammer blow or heavy manual pressure.
H6	Soft	Can be grooved or gouged easily by knife or sharp pick with light pressure, can be scratched with fingernail. Breaks with light to moderate manual pressure.
H7	Very soft	Can be readily indented, grooved or gouged with fingernail, or carved with a knife. Breaks with light manual pressure.
Any bedrock unit softer than H7, very soft, is to be described using ASTM D-2488 consistency descriptors.		
Note: Although "sharp pick" is included in these definitions, descriptions of ability to be scratched, grooved or gouged by a knife is the preferred criteria.		
Modified from United States Bureau of Reclamation, Engineering Geology Field manual.		

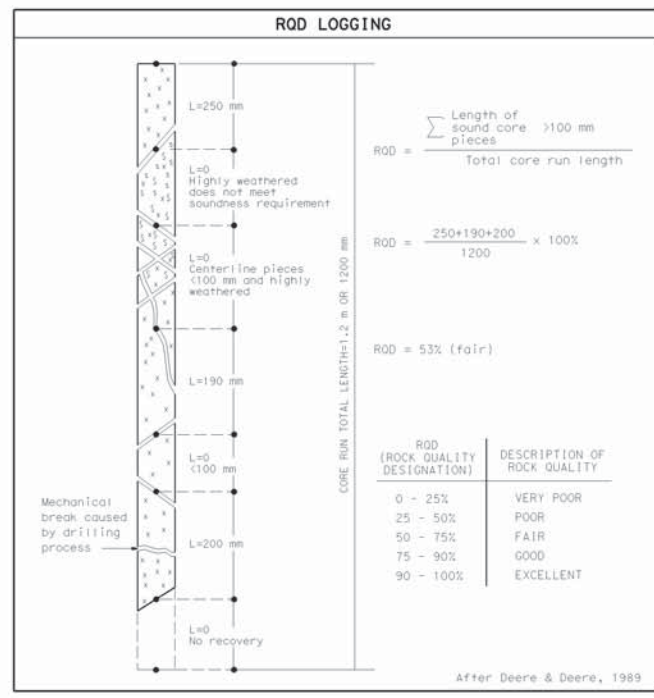

BEDDING, FOLIATION, OR FLOW TEXTURE DESCRIPTORS	
Descriptors	Thickness / Spacing
Massive	Greater than 3 m
Very thickly (bedded, foliated, or banded)	1 to 3 m
Thickly	300 mm to 1 m
Moderately	100 to 300 mm
Thinly	30 to 100 mm
Very thinly	10 to 30 mm
Laminated (intensely foliated or banded)	Less than 10 mm

Modified from United States Bureau of Reclamation, Engineering Geology Field manual.

ROD (ROCK QUALITY DESIGNATION)	DESCRIPTION OF ROCK QUALITY
0 - 25%	VERY POOR
25 - 50%	POOR
50 - 75%	FAIR
75 - 90%	GOOD
90 - 100%	EXCELLENT

**IN-SITU, LAB & FIELD TEST DESIGNATIONS**

- AL ATTERBERG LIMITS
- CA CHEMICAL ANALYSIS
- CN CONSOLIDATION
- CU CONSOLIDATED UNDRAINED TRIAXIAL
- DS DIRECT SHEAR
- MD MAX. DRY DENSITY
- PP POCKET PENETROMETER
- SA SIEVE ANALYSIS
- TV TORVANE
- UC UNCONFINED COMPRESSION
- UU UNCONSOLIDATED UNDRAINED TRIAXIAL
- VS VANE SHEAR

D Brittsan DESIGN OVERSIGHT June 29, 2007 SIGN OFF DATE	DRAWN BY A. Sanchez	CHECKED BY M. Briseno	GZhang/BVonDessoneck FIELD INVESTIGATION BY: DATE: August 2006	PREPARED FOR THE STATE OF CALIFORNIA DEPARTMENT OF TRANSPORTATION	K. Chowdhury PROJECT ENGINEER	BRIDGE NO. 19E0006 KILOMETER POST 4.14	<b>RETAINING WALL 40W-42W</b> <b>ROCK LEGENDS AND LABORATORY AND FIELD TEST SYMBOLS</b>
--	------------------------	--------------------------	--	---	----------------------------------	---	--

CIVIL LOG OF TEST BORINGS SHEET (METRIC) (REV. 2/1/00)

ORIGINAL SCALE IN MILLIMETERS FOR REDUCED PLANS: 0 10 20 30 40 50 60 70 80 90 100

CU 03262 EA 367821

DISREGARD PRINTS BEARING EARLIER REVISION DATES

REVISION DATES (PRELIMINARY STAGE ONLY)

6/27/07					
---------	--	--	--	--	--

SHEET 22 OF 29



DIST	COUNTY	ROUTE	KILOMETER POST TOTAL PROJECT	SHEET No	TOTAL SHEETS
03	Sac, Pla	80	28.1/29.0, 0.0/4.7	522	528

*Khaled Chowdhury* 6-27-07  
 REGISTERED CIVIL ENGINEER  
 No. C67823  
 Exp. 6-30-09  
 CIVIL  
 STATE OF CALIFORNIA

11-26-07  
 PLANS APPROVAL DATE


*The State of California or its officers or agents shall not be responsible for the accuracy or completeness of electronic copies of this plan sheet.*

KLEINFELDER INC.  
 3077 FITE CIR.  
 SACRAMENTO, CA 95826

Notes:

- 51 mm samples were taken using a California split-barrel sampler with an inside diameter (I.D.) of 51 mm and an outside diameter (O.D.) of 64 mm.
- A safety semi-automatic hammer (63.5 kg) with a 760 mm drop was used to advance the sampler.
- Blowcounts noted for boring are field blowcounts and have not been corrected.
- 35 mm samples were taken using a SPT split-barrel sampler with an inside diameter (I.D.) of 35 mm and an outside diameter (O.D.) of 51 mm.
- 63.5 mm core samples were taken using an HQ core sampler with a 63.5 mm inside diameter (I.D.) and 94 mm outside diameter (O.D.) core barrel.
- Blowcounts 50/125 means 50 blows per 125 mm penetration.
- Horizontal borings were started approximately 1.5 m above adjacent shoulder grade and inclined downward at a 10 degree angle. Horizontal borings intersect shoulder grade at a depth of approximately 8.8 meters.

LEGEND OF BORING OPERATIONS

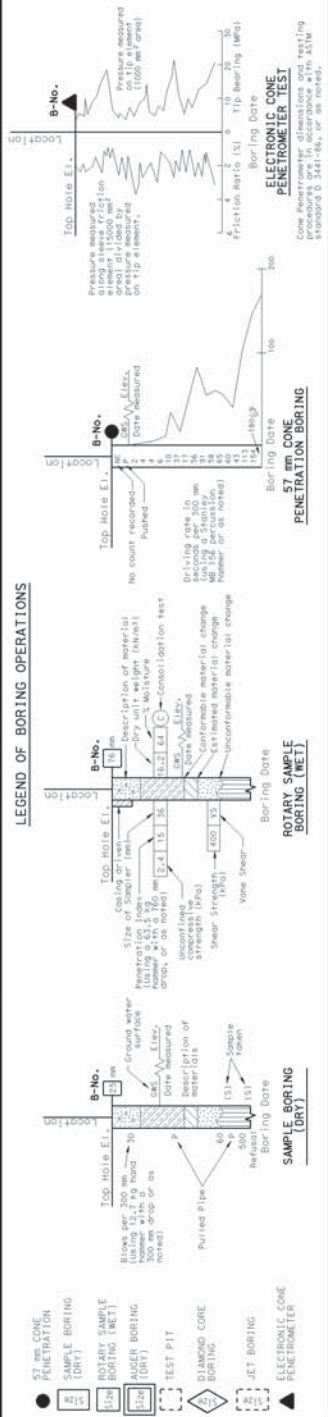

LEGEND OF EARTH MATERIALS

GRAVEL	CLAYEY SILT
SAND	PEAT and/or ORGANIC MATTER
SILT	FILL MATERIAL
CLAY	COBBLE
SANDY CLAY or CLAYEY SAND	INDURATED ROCK
SANDY SILT or SILTY SAND	SEDIMENTARY ROCK
SILTY CLAY	METAMORPHIC

CONSISTENCY CLASSIFICATION FOR SOILS

SPT	Flow Value	Consistency
0-4	Very Loose	Very Soft
5-10	Loose	Soft
11-20	Medium Dense	Firm
31-50	Dense	Stiff
50	Very Dense	Very Stiff
		Hard


NOTE: Classification of earth material as shown on this sheet is based upon field inspection and is not to be construed to imply mechanical analysis.

BENCHMARKS

STATION	OFFSET	N	E	ELEV	DESCRIPTION
15+79.190	4.62 Rt	618564.792	2062442.621	44.552	


SURVEY CONTROL

1. Coordinates bearing and distances are based on the California coordinate system of Nad 1983 HPGN, zone 6. (EPOCH 1991.35). Elevations are based on NGVD 29.

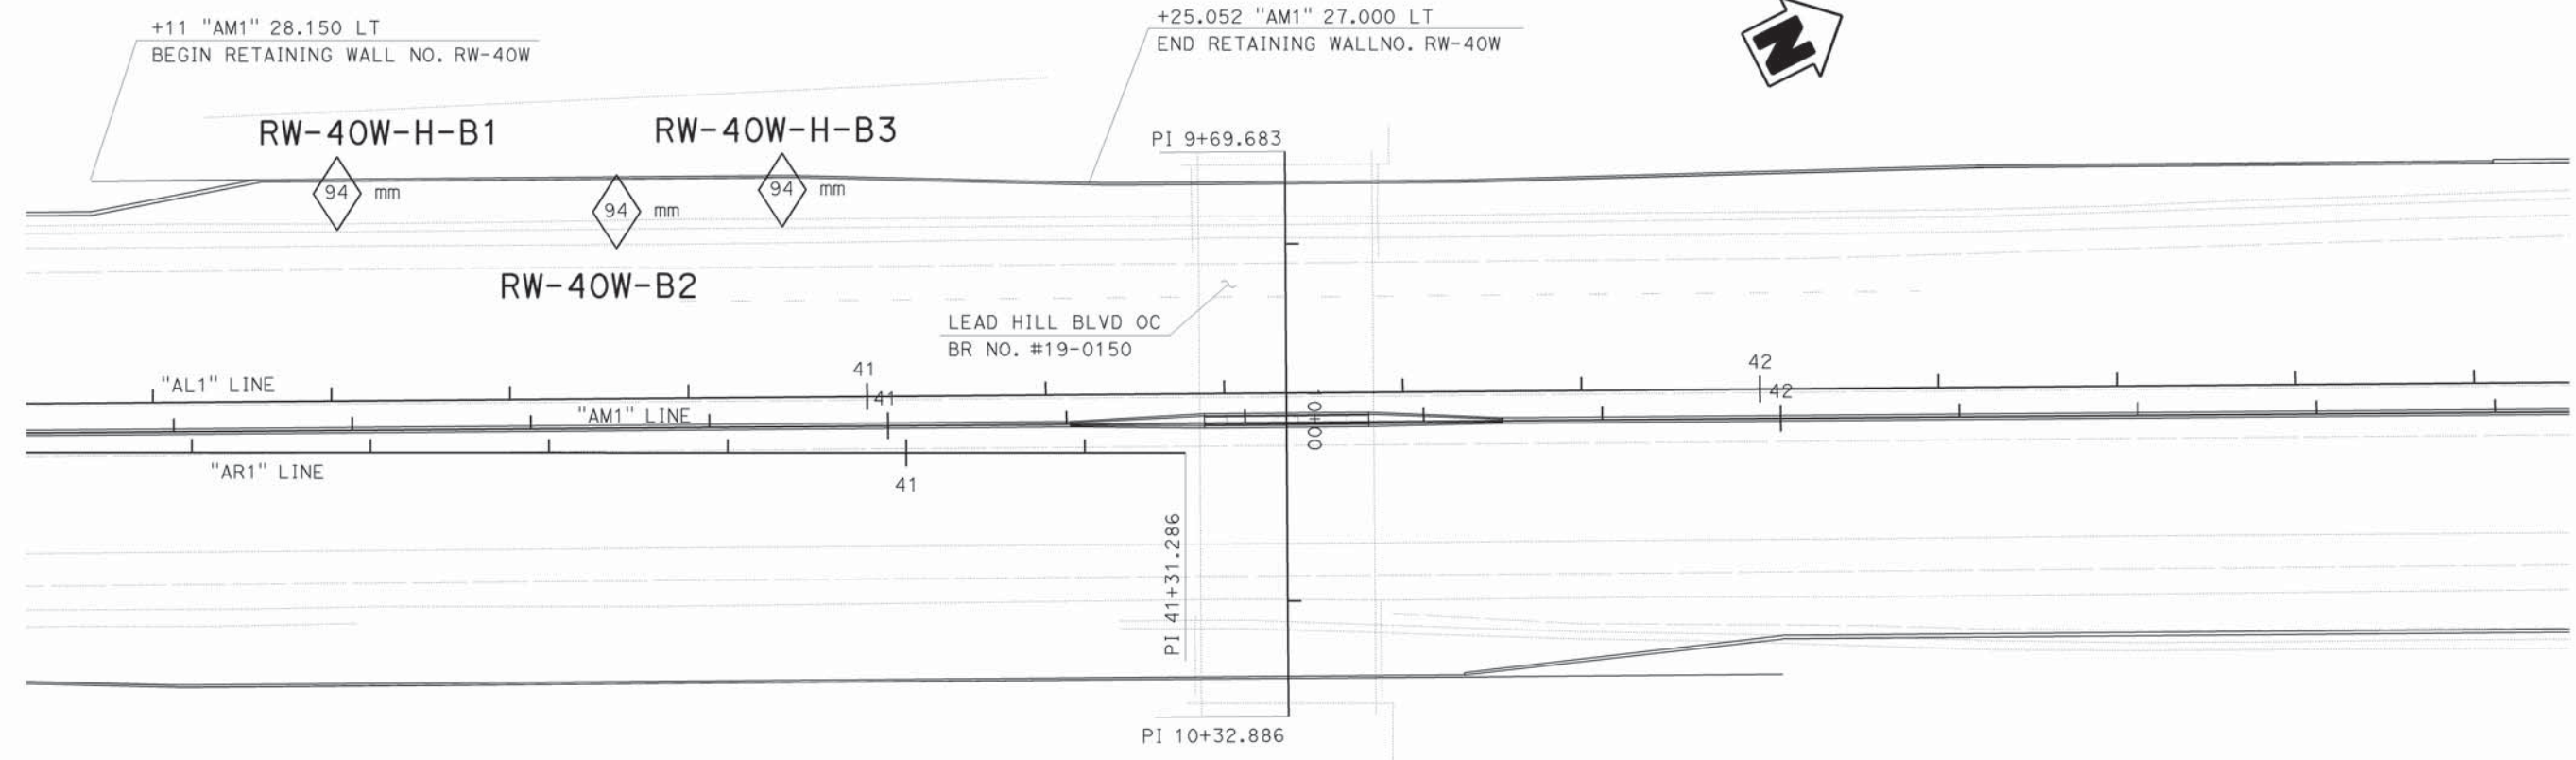

PLAN  
 1:400

D. Brittsan DESIGN OVERSIGHT June 29, 2007 SIGN OFF DATE	DRAWN BY A. Sanchez	Checked BY B. Anderson, C.E.G.	Kleinfelder, Inc. FIELD INVESTIGATION BY: DATE: December 2006	PREPARED FOR THE STATE OF CALIFORNIA DEPARTMENT OF TRANSPORTATION	K. Chowdhury PROJECT ENGINEER	BRIDGE NO. 19E0006 KILOMETER POST 4.14	RETAINING WALL 40W-42W LOG OF TEST BORINGS 1 OF 7
---	------------------------	-----------------------------------	---	---	----------------------------------	---	--

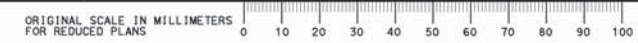

DATE PLOTTED => 26-NOV-2007 USERNAME => p7183




DIST	COUNTY	ROUTE	KILOMETER POST TOTAL PROJECT	SHEET No	TOTAL SHEETS
03	Sac, Pla	80	28.1/29.0, 0.0/4.7	523	528

*Khaled H. Chowdhury* 6-27-07  
 REGISTERED CIVIL ENGINEER  
 No. C67823  
 Exp. 6-30-09  
 CIVIL  
 STATE OF CALIFORNIA

11-26-07  
 PLANS APPROVAL DATE  
 The State of California or its officers or agents shall not be responsible for the accuracy or completeness of electronic copies of this plan sheet.  
 KLEINFELDER INC.  
 3077 FITE CIR.  
 SACRAMENTO, CA 95826

FOR PLAN VIEW AND ADDITIONAL NOTES, SEE "LOG OF TEST BORINGS" SHEET 1 OF 2

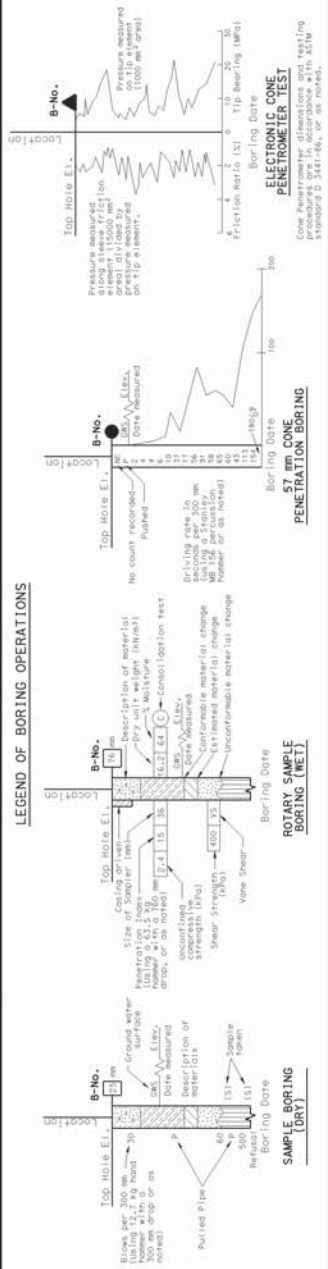


LEGEND OF BORING OPERATIONS  
 57 mm CONE PENETRATION SAMPLE BORING (DRY)  
 ROTARY SAMPLE BORING (WET)  
 AUGER BORING (DRY)  
 TEST PIT  
 DIAMOND CORE BORING  
 JET BORING  
 ELECTRONIC CONE PENETROMETER

LEGEND OF EARTH MATERIALS

GRAVEL	CLAYEY SILT
SAND	PEAT and/or ORGANIC MATTER
SILT	FILL MATERIAL
CLAY	COBBLE
SANDY CLAY or CLAYEY SAND	INDURUS ROCK
SANDY SILT or SILTY SAND	SEDIMENTARY ROCK
SILTY CLAY	METAMORPHIC

CONSISTENCY CLASSIFICATION FOR SOILS

SPT	Relative Density	Consistency
0-4	Very Loose	Very Soft
5-10	Loose	Soft
11-30	Medium Dense	Firm
31-50	Dense	Stiff
50	Very Dense	Very Stiff
		Hard

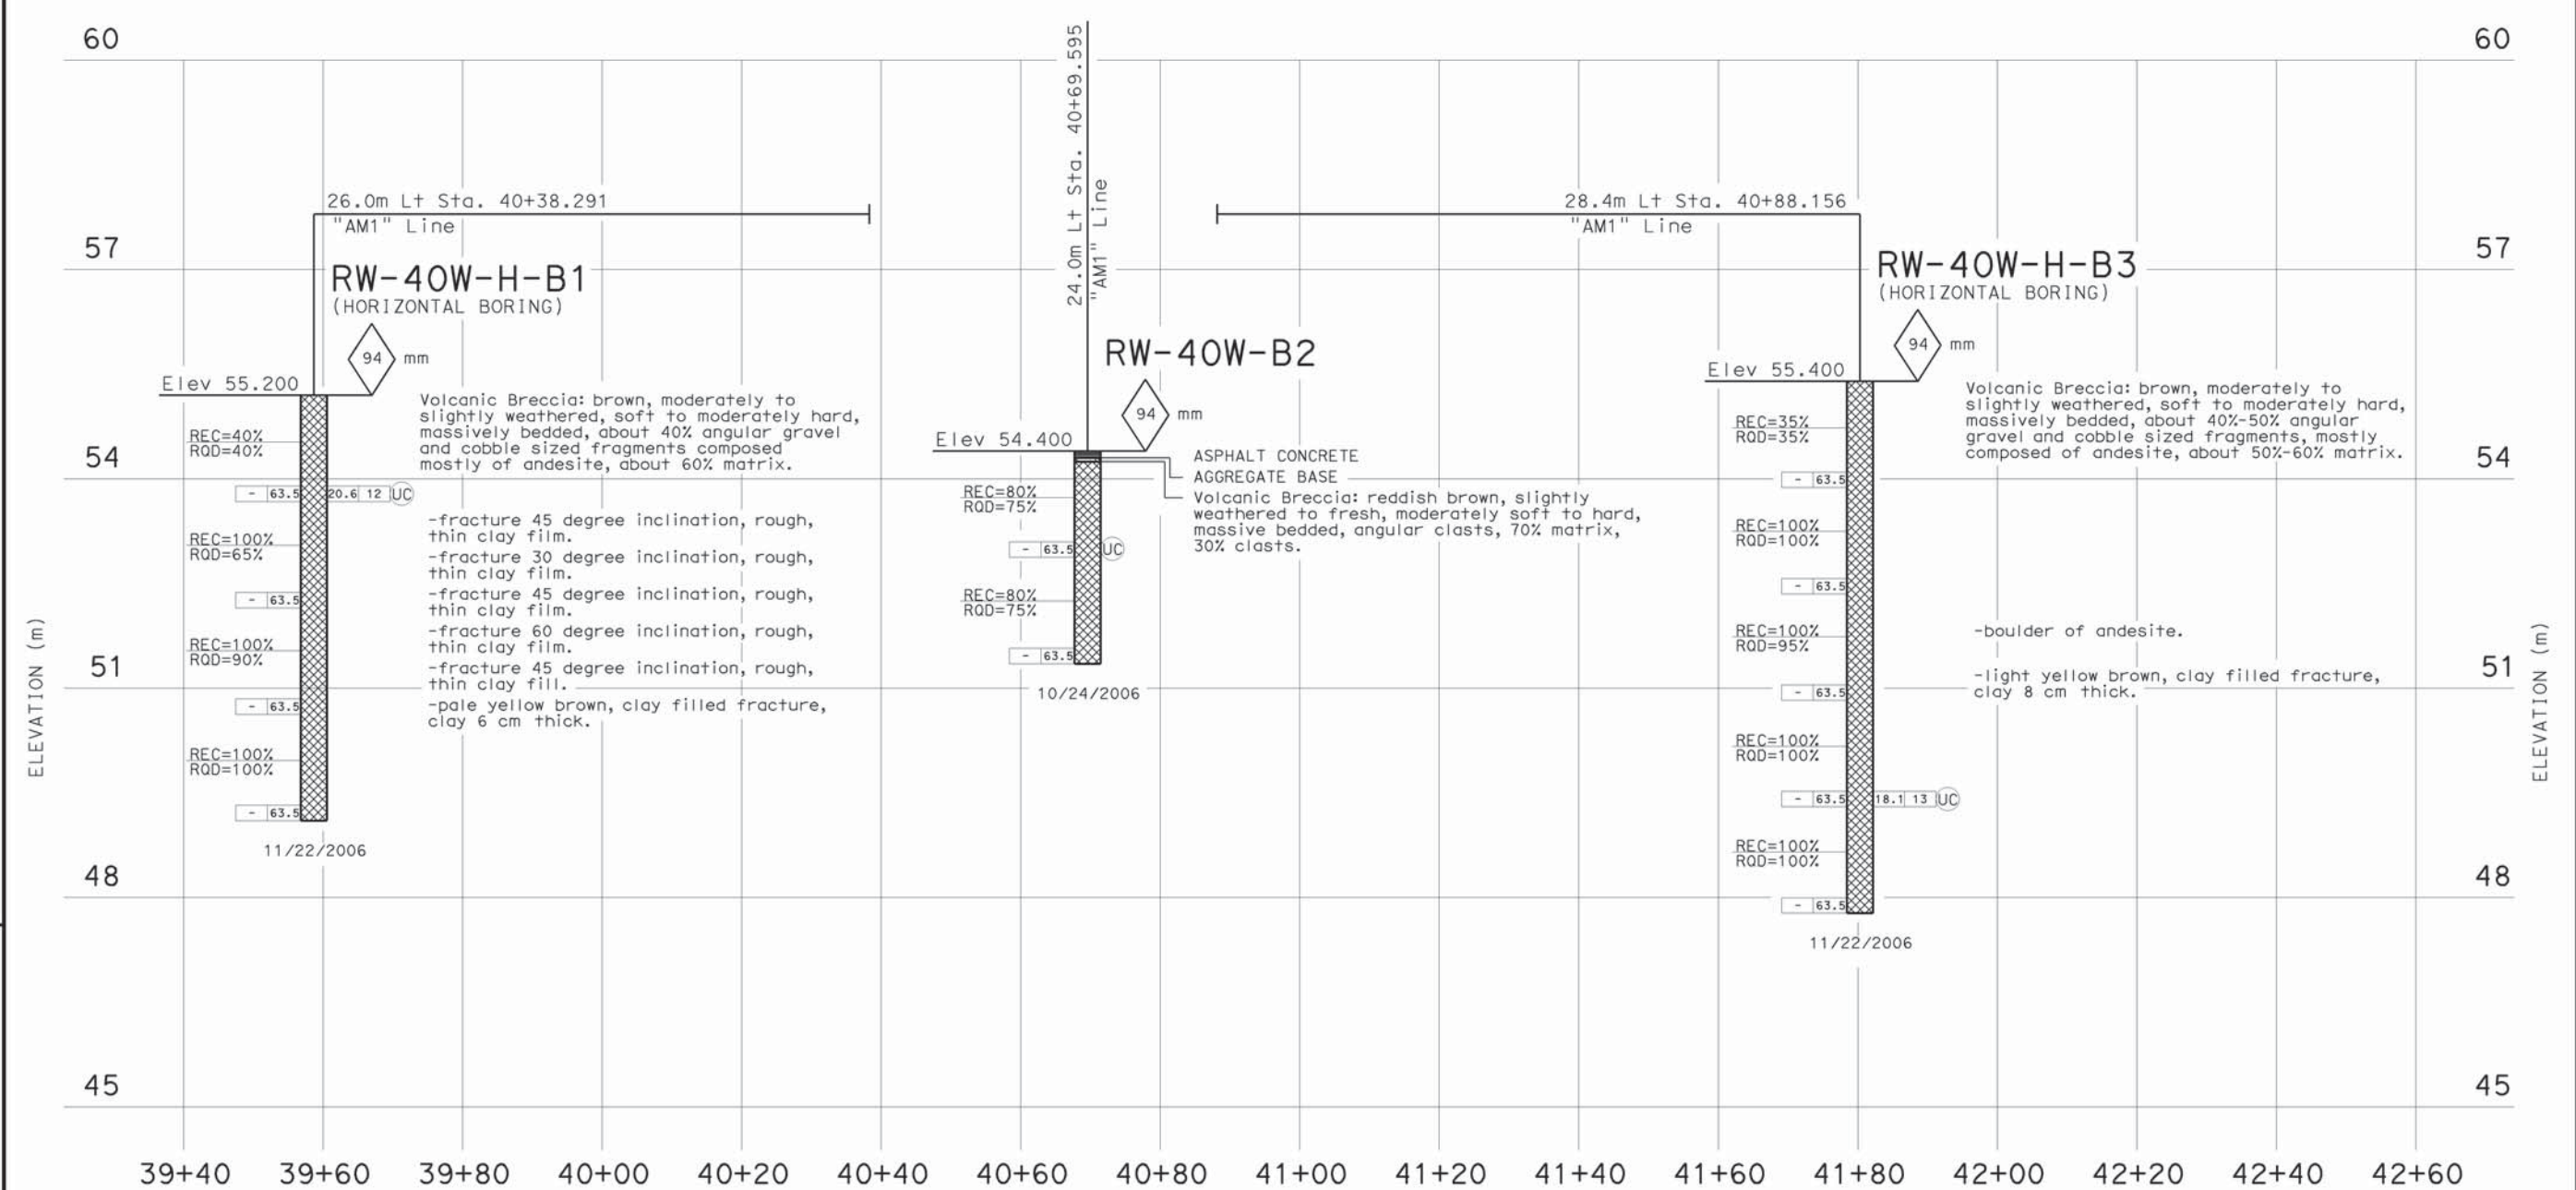

PROFILE  
 HOR. 1:500  
 VER. 1:50

D. Brittsan DESIGN OVERSIGHT June 29, 2007 SIGN OFF DATE	DRAWN BY A. Sanchez	Checked by B. Anderson, C.E.G.	Kleinfelder, Inc. FIELD INVESTIGATION BY: DATE: December 2006	PREPARED FOR THE STATE OF CALIFORNIA DEPARTMENT OF TRANSPORTATION	K. Chowdhury PROJECT ENGINEER	BRIDGE NO. 19E0006 KILOMETER POST 4.14	RETAINING WALL 40W-42W LOG OF TEST BORINGS 2 OF 7
---	------------------------	-----------------------------------	---	---	----------------------------------	---	--



DIST	COUNTY	ROUTE	KILOMETER POST TOTAL PROJECT	SHEET No	TOTAL SHEETS
03	Sac, Pla	80	28.1/29.0 0.0/4.7	524	528


Khaled Chowdhury 6-27-07  
 REGISTERED CIVIL ENGINEER  
 No. C67823  
 Exp. 6-30-09  
 CIVIL  
 STATE OF CALIFORNIA

11-26-07  
 PLANS APPROVAL DATE  
 The State of California or its officers or agents shall not be responsible for the accuracy or completeness of electronic copies of this plan sheet.  
 KLEINFELDER INC.  
 3077 FITE CIR.  
 SACRAMENTO, CA 95826

Notes:

- 51 mm samples were taken using a California split-barrel sampler with an inside diameter (I.D.) of 51 mm and an outside diameter (O.D.) of 64 mm.
- A safety semi-automatic hammer (63.5 kg) with a 760 mm drop was used to advance the sampler.
- Blowcounts noted for boring are field blowcounts and have not been corrected.
- 35 mm samples were taken using a SPT split-barrel sampler with an inside diameter (I.D.) of 35 mm and an outside diameter (O.D.) of 51 mm.
- 63.5 mm core samples were taken using an HQ core sampler with a 63.5 mm inside diameter (I.D.) and 94 mm outside diameter (O.D.) core barrel.
- Blowcounts 50/125 means 50 blows per 125 mm penetration.
- Horizontal borings were started approximately 1.5 m above adjacent shoulder grade and inclined downward at a 10 degree angle. Horizontal borings intersect shoulder grade at a depth of approximately 8.8 meters.

LEGEND OF BORING OPERATIONS

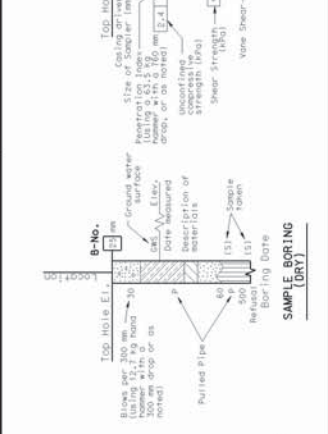

CONSISTENCY CLASSIFICATION FOR SOILS

SPT	Relative Density	Consistency
0-4	Very Loose	Very Soft
5-10	Loose	Soft
11-30	Medium Dense	Firm
31-50	Dense	Stiff
50	Very Dense	Very Stiff
		Hard


NOTE: Classification of earth material as shown on this sheet is based upon field inspection and is not to be construed to imply mechanical analysis.

BENCHMARKS

STATION	OFFSET	N	E	ELEV	DESCRIPTION
15+79.190	4.62 Rt	618564.792	2062442.621	44.552	

SURVEY CONTROL

1. Coordinates bearing and distances are based on the California coordinate system of Nad 1983 HPGN, zone 6. (EPOCH 1991.35). Elevations are based on NGVD 29.

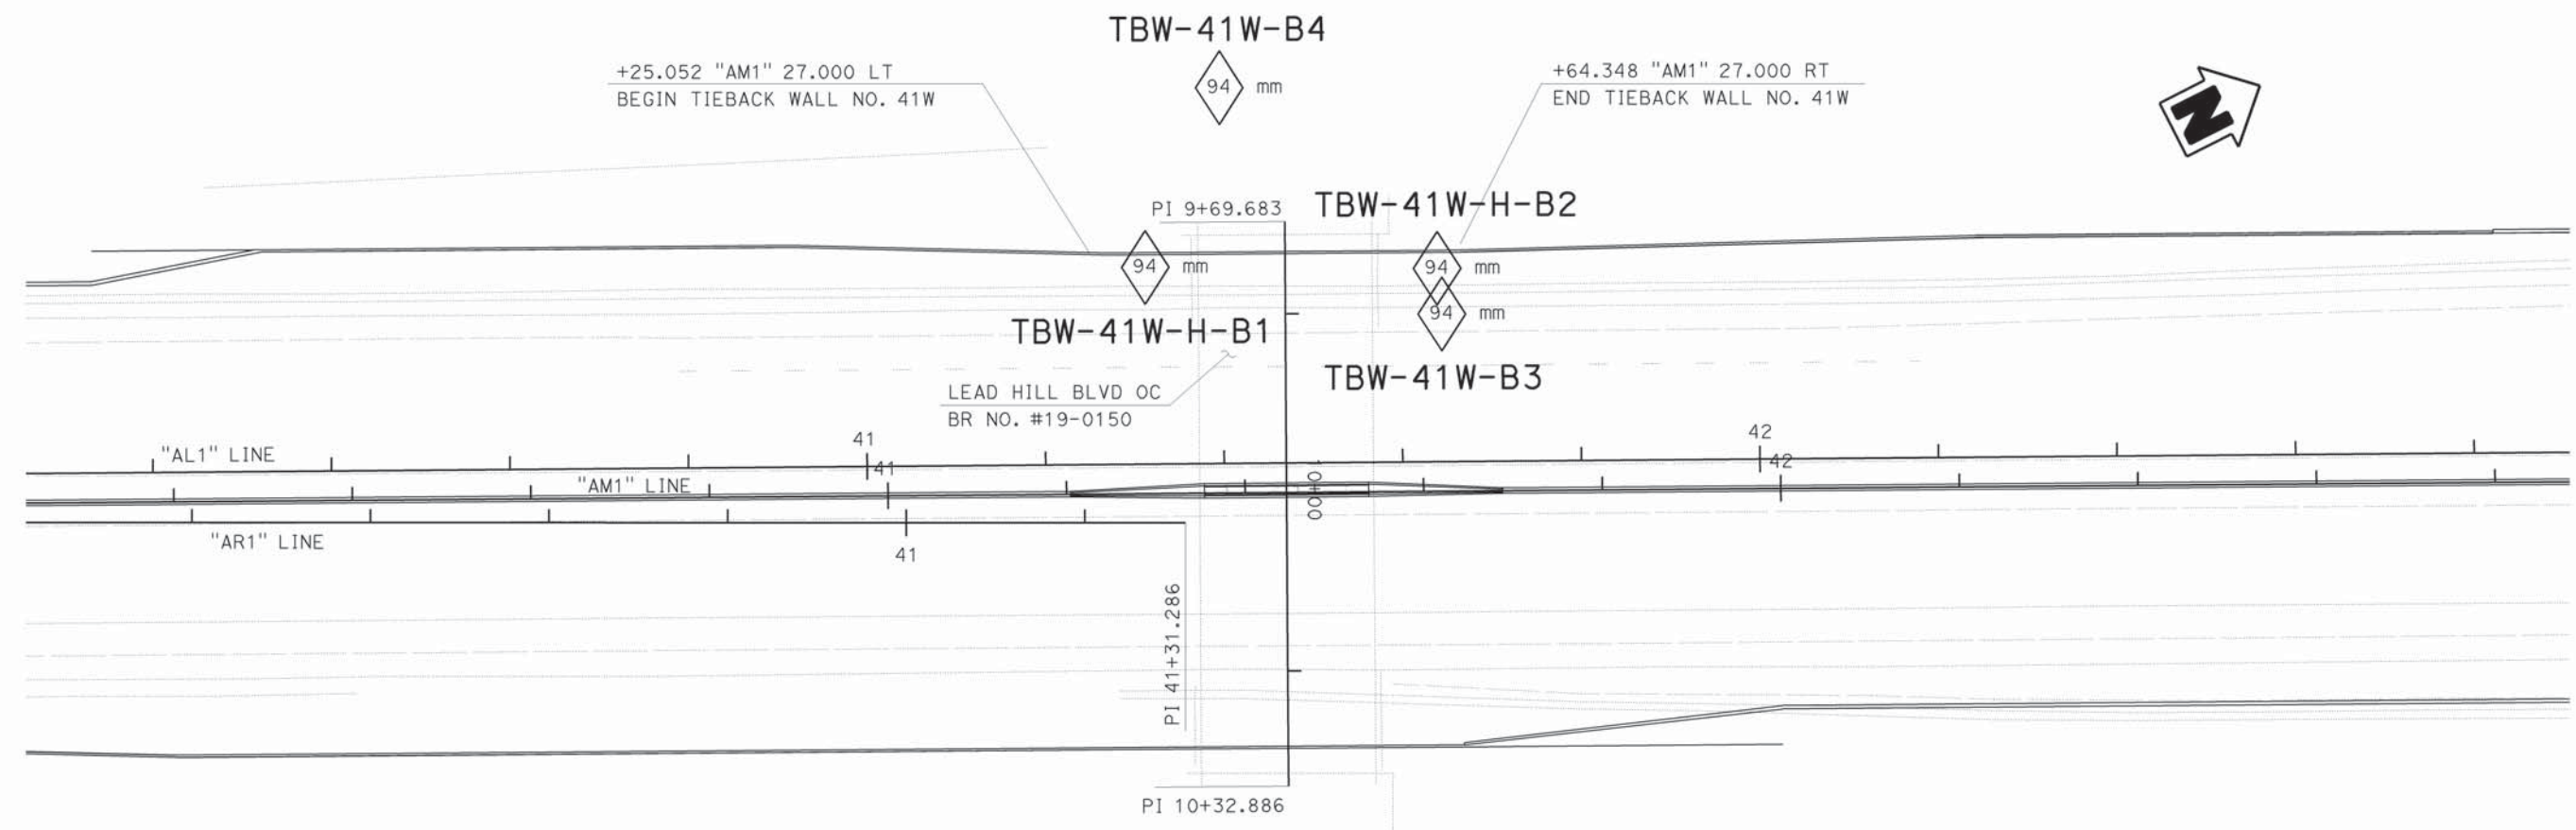

PLAN  
1:400

D. Brittsan  
 DESIGN OVERSIGHT  
 June 29, 2007  
 SIGN OFF DATE

DRAWN BY  
 A. Sanchez  
 CHECKED BY  
 B. Anderson, C.E.G.


Kleinfelder, Inc.  
 FIELD INVESTIGATION BY:  
 DATE: December 2006

PREPARED FOR THE  
 STATE OF CALIFORNIA  
 DEPARTMENT OF TRANSPORTATION

K. Chowdhury  
 PROJECT ENGINEER

BRIDGE NO.  
 19E0006  
 KILOMETER POST  
 4.14

RETAINING WALL 40W-42W  
 LOG OF TEST BORINGS 3 OF 7

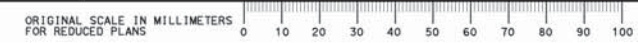






DIST	COUNTY	ROUTE	KILOMETER POST TOTAL PROJECT	SHEET No	TOTAL SHEETS
03	Sac, Pla	80	28.17/29.0, 0.0/4.7	525	528
			6-27-07		
			REGISTERED CIVIL ENGINEER		
			11-26-07		
			PLANS APPROVAL DATE		
The State of California or its officers or agents shall not be responsible for the accuracy or completeness of electronic copies of this plan sheet.					
KLEINFELDER INC.			3077 FITE CIR. SACRAMENTO, CA 95826		




FOR PLAN VIEW AND ADDITIONAL NOTES, SEE "LOG OF TEST BORINGS" SHEET 1 OF 3

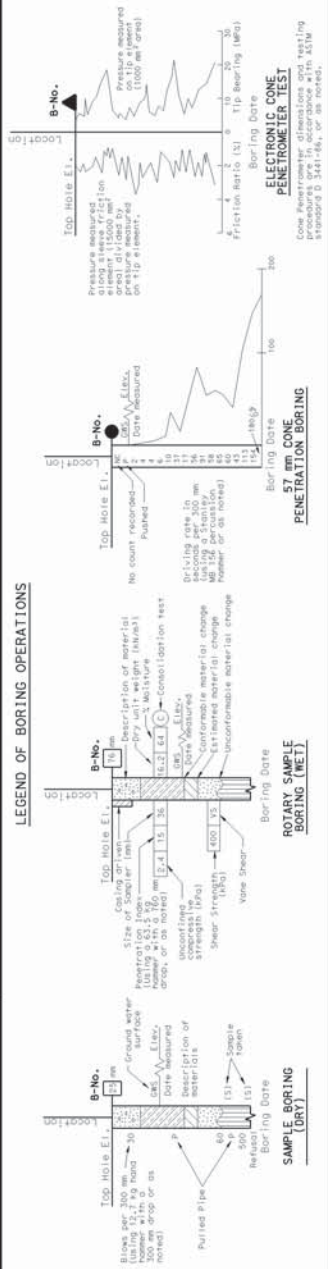

**CONSISTENCY CLASSIFICATION FOR SOILS**

According to the Standard Penetration Test


SPT	Relative Density	Consistency
0-4	Very Loose	Very Soft
5-10	Loose	Soft
11-20	Medium Dense	Firm
31-50	Dense	Stiff
50	Very Dense	Very Stiff
73		Hard

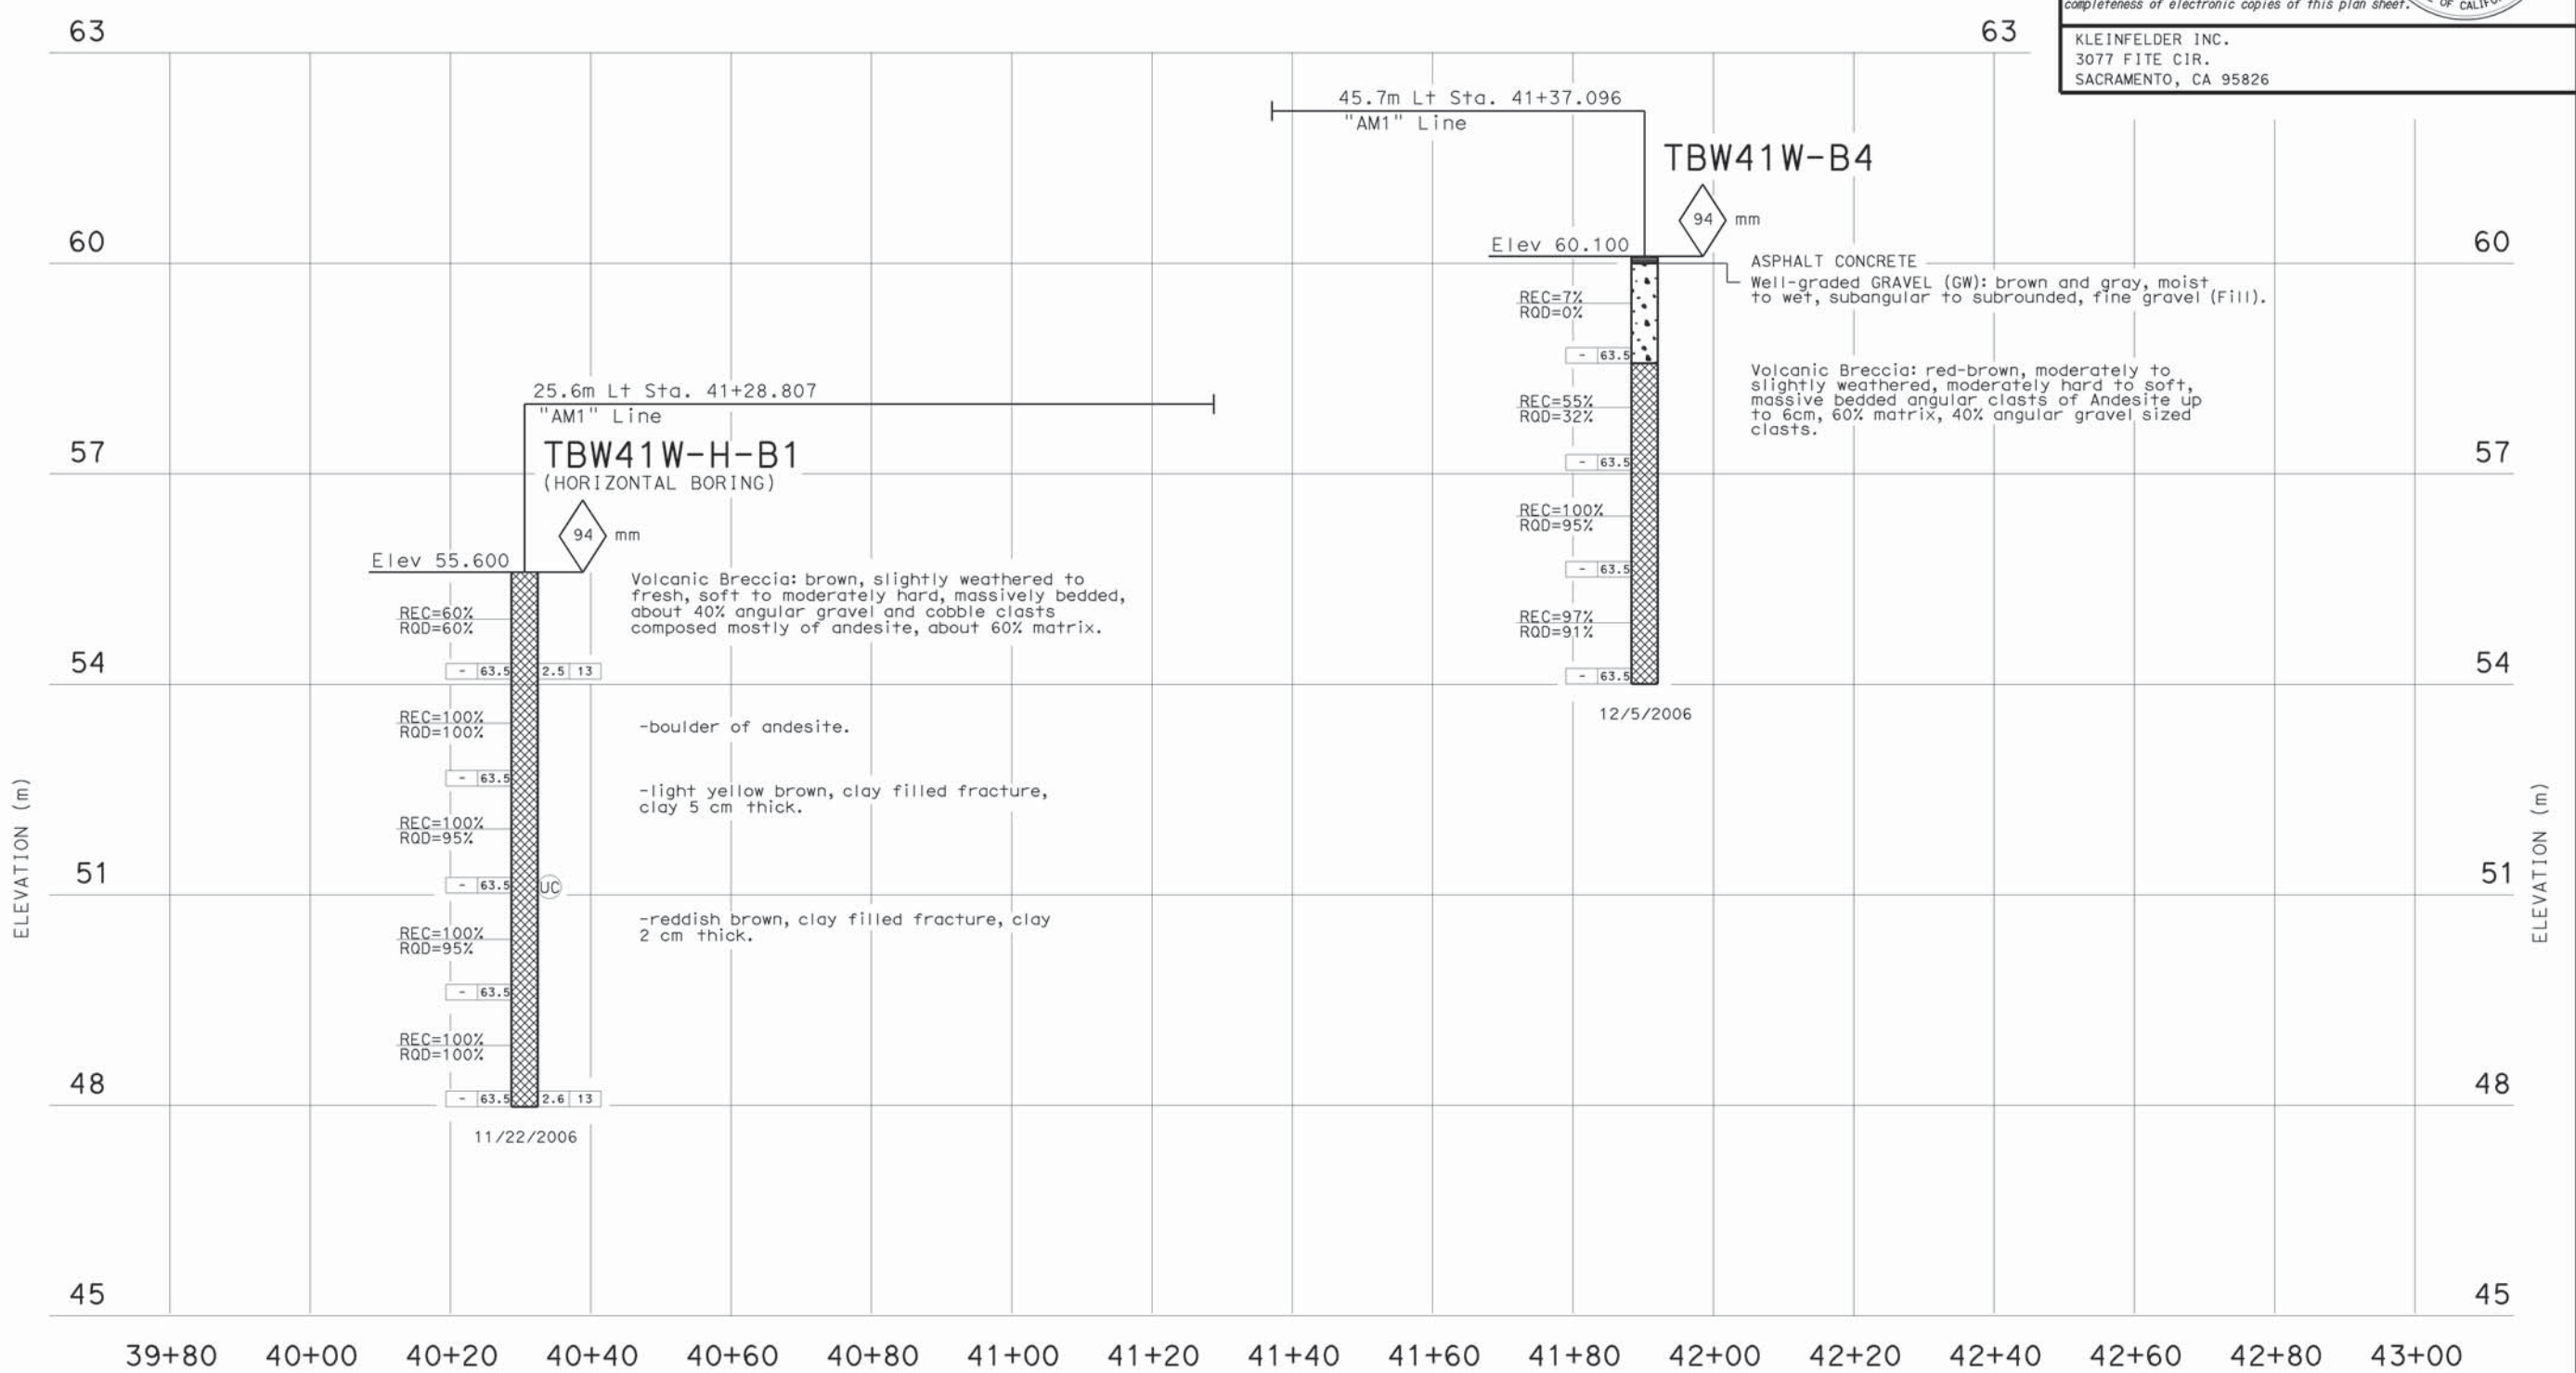

39+80 40+00 40+20 40+40 40+60 40+80 41+00 41+20 41+40 41+60 41+80 42+00 42+20 42+40 42+60 42+80 43+00

**PROFILE**  
 HOR. 1:500  
 VER. 1:50

D. Brittsan DESIGN OVERSIGHT June 29, 2007 SIGN OFF DATE	DRAWN BY A. Sanchez	Checked By B. Anderson, C.E.G.	Kleinfelder, Inc. FIELD INVESTIGATION BY: DATE: December 2006	PREPARED FOR THE STATE OF CALIFORNIA DEPARTMENT OF TRANSPORTATION	K. Chowdhury PROJECT ENGINEER	BRIDGE NO. 19E0006 KILOMETER POST 4.14	<b>RETAINING WALL 40W-42W</b> <b>LOG OF TEST BORINGS 4 OF 7</b>
---	------------------------	-----------------------------------	---	---	----------------------------------	---	--

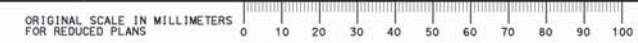




DIST	COUNTY	ROUTE	KILOMETER POST TOTAL PROJECT	SHEET No	TOTAL SHEETS
03	Sac, Plc	80	28.1/29.0, 0.0/4.7	526	528

**Khaled H. Chowdhury** 6-27-07  
 REGISTERED CIVIL ENGINEER  
 No. C67823  
 Exp. 6-30-09  
 CIVIL  
 STATE OF CALIFORNIA

11-26-07  
 PLANS APPROVAL DATE  
 The State of California or its officers or agents shall not be responsible for the accuracy or completeness of electronic copies of this plan sheet.  
 KLEINFELDER INC.  
 3077 FITE CIR.  
 SACRAMENTO, CA 95826

FOR PLAN VIEW AND ADDITIONAL NOTES, SEE "LOG OF TEST BORINGS" SHEET 1 OF 3

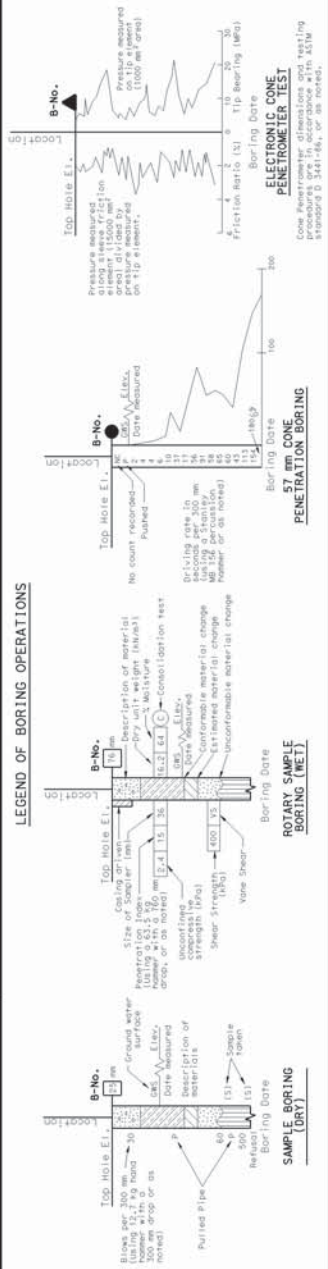


**CONSISTENCY CLASSIFICATION FOR SOILS**

According to the Standard Penetration Test

SPT	Relative Density (D <sub>r</sub> )	Consistency
0-4	Very Loose	Very Soft
5-10	Loose	Soft
11-20	Medium Dense	Firm
31-50	Dense	Stiff
50	Very Dense	Very Stiff
		Hard

NOTE: Classification of earth material as shown on this sheet is based upon field inspection and is not to be construed to imply mechanical analysis.

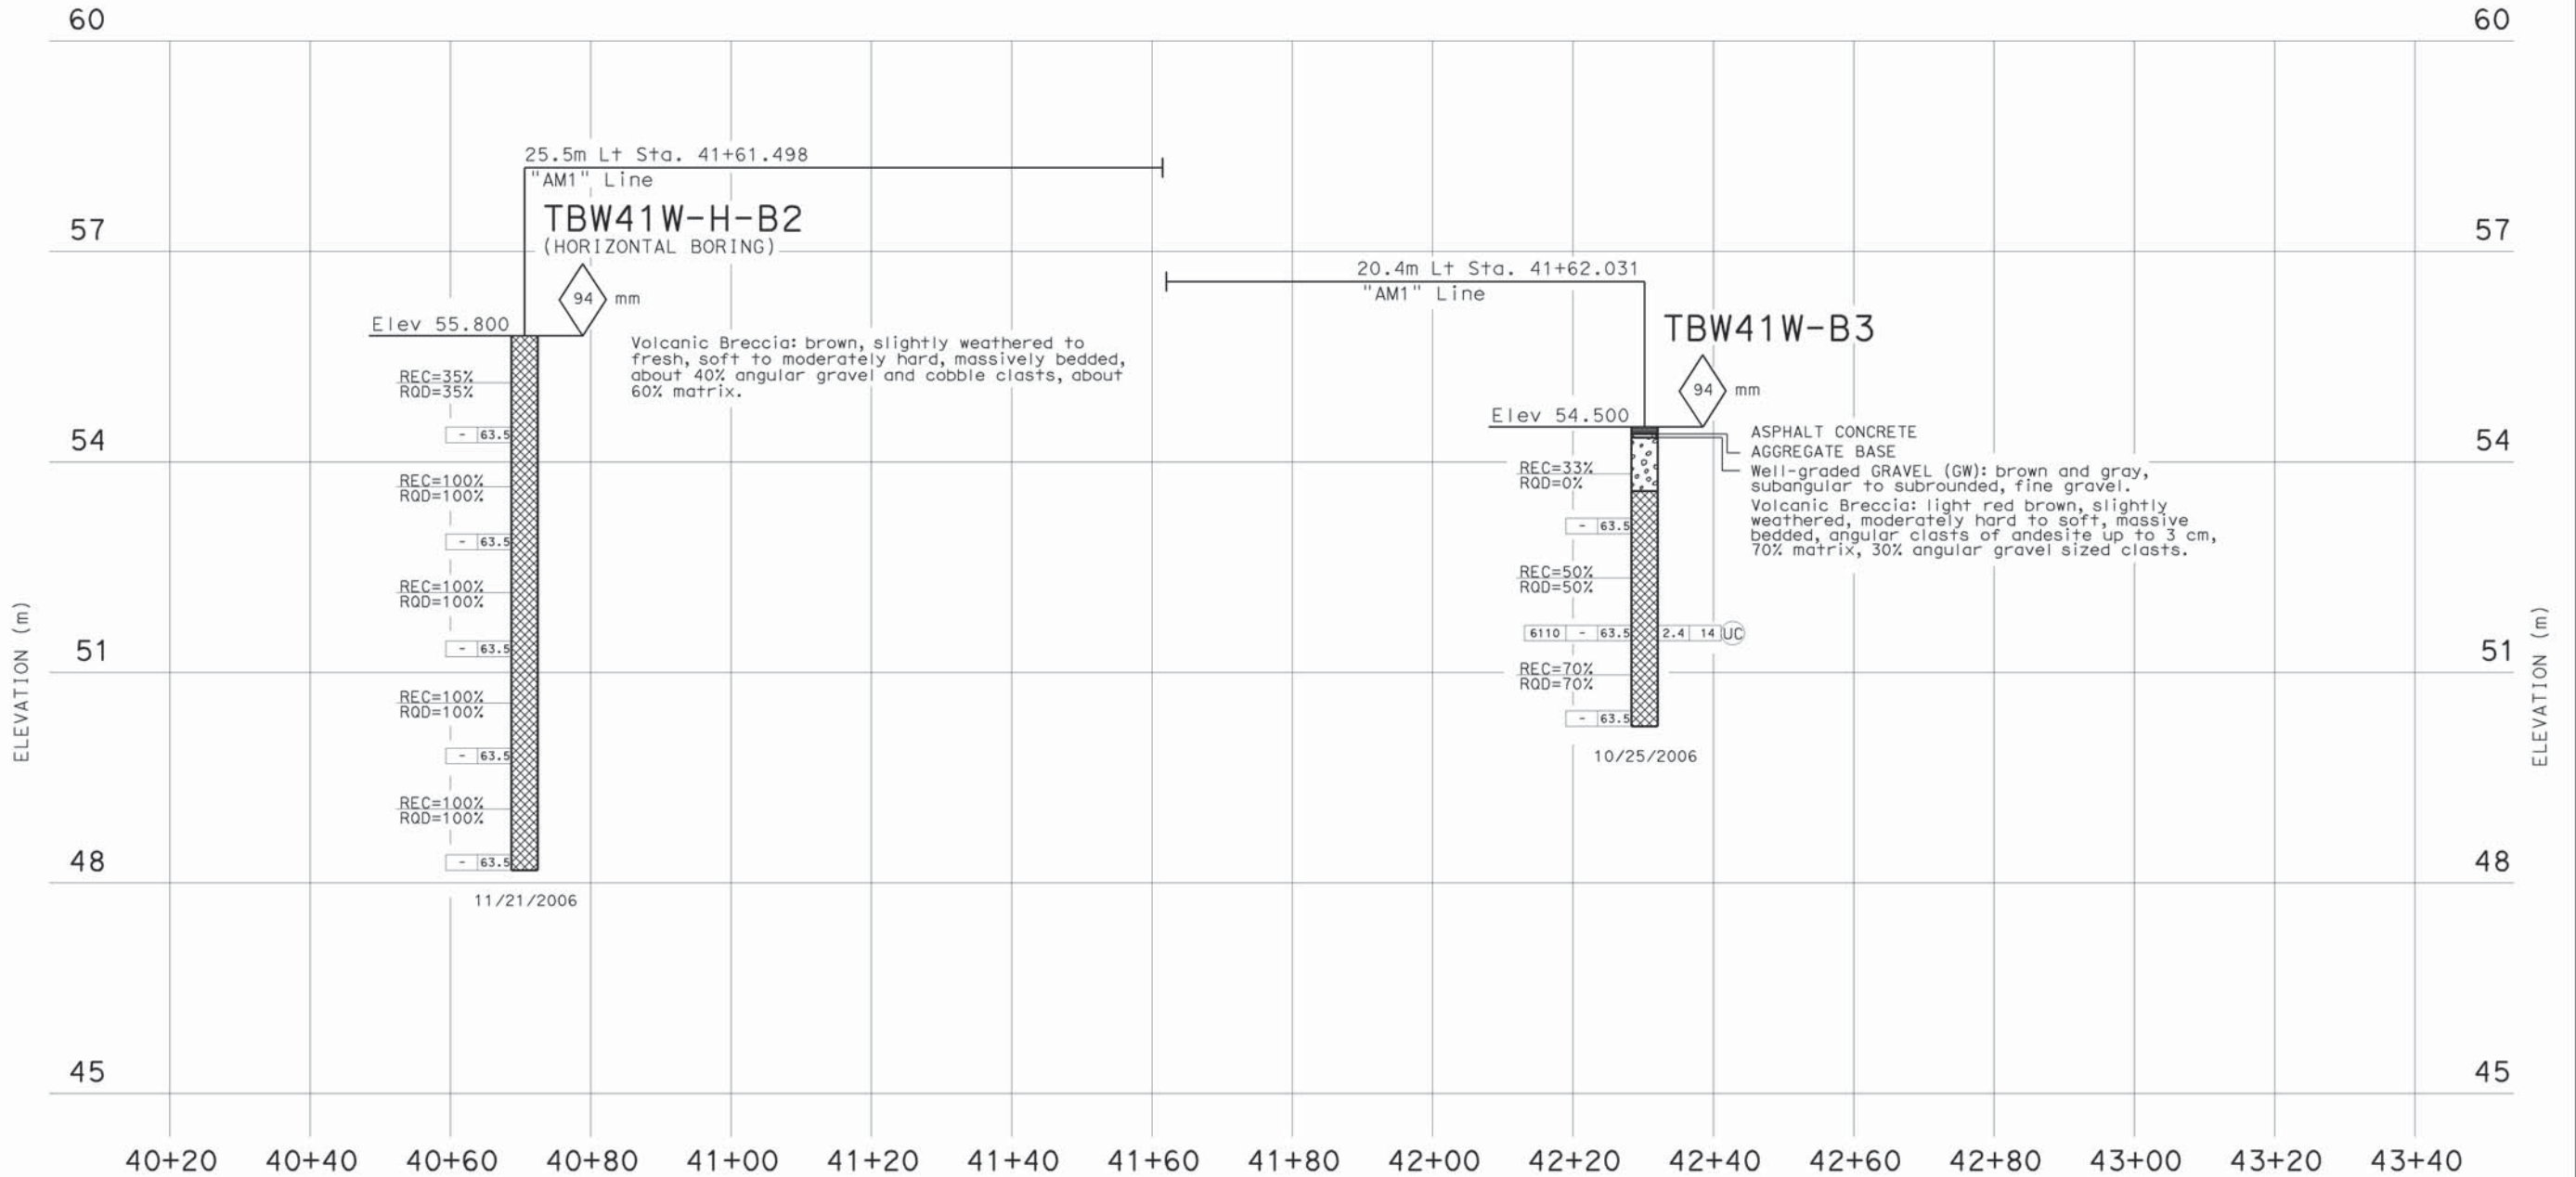

**PROFILE**  
 HOR. 1:500  
 VER. 1:50

D. Brittsan DESIGN OVERSIGHT June 29, 2007 SIGN OFF DATE	DRAWN BY A. Sanchez	Checked By B. Anderson, C.E.G.	Kleinfelder, Inc. FIELD INVESTIGATION BY: DATE: December 2006	PREPARED FOR THE <b>STATE OF CALIFORNIA</b> DEPARTMENT OF TRANSPORTATION	K. Chowdhury PROJECT ENGINEER	BRIDGE NO. 19E0006 KILOMETER POST 4.14	<b>RETAINING WALL 40W-42W</b> <b>LOG OF TEST BORINGS 5 OF 7</b>
---	------------------------	-----------------------------------	---	--	----------------------------------	---	--



DIST	COUNTY	ROUTE	KILOMETER POST TOTAL PROJECT	SHEET No	TOTAL SHEETS
03	Sac, Pla	80	28.1/29.0, 0.0/4.7	527	528


**Khaled Chowdhury** 6-27-07  
 REGISTERED CIVIL ENGINEER  
 No. C67823  
 Exp. 6-30-09  
 CIVIL  
 STATE OF CALIFORNIA

11-26-07  
 PLANS APPROVAL DATE  
 The State of California or its officers or agents shall not be responsible for the accuracy or completeness of electronic copies of this plan sheet.  
 KLEINFELDER INC.  
 3077 FITE CIR.  
 SACRAMENTO, CA 95826

**Notes:**

- 51 mm samples were taken using a California split-barrel sampler with an inside diameter (I.D.) of 51 mm and an outside diameter (O.D.) of 64 mm.
- A safety semi-automatic hammer (63.5 kg) with a 760 mm drop was used to advance the sampler.
- Blowcounts noted for boring are field blowcounts and have not been corrected.
- 35 mm samples were taken using a SPT split-barrel sampler with an inside diameter (I.D.) of 35 mm and an outside diameter (O.D.) of 51 mm.
- 63.5 mm core samples were taken using an HQ core sampler with a 63.5 mm inside diameter (I.D.) and 94 mm outside diameter (O.D.) core barrel.
- Blowcounts 50/125 means 50 blows per 125 mm penetration.
- Horizontal borings were started approximately 1.5 m above adjacent shoulder grade and inclined downward at a 10 degree angle. Horizontal borings intersect shoulder grade at a depth of approximately 8.8 meters.

**LEGEND OF BORING OPERATIONS**

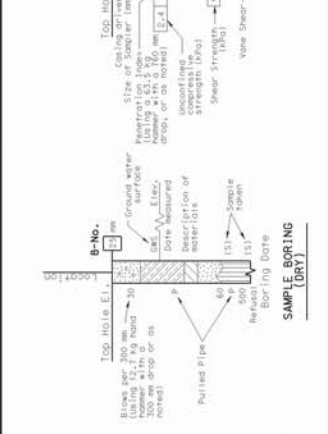

- 57 mm Cone Penetration Boring
- Rotary Sample Boring (Wet)
- Rotary Sample Boring (Dry)
- Sample Boring (Dry)
- Jet Boring

- LEGEND OF EARTH MATERIALS**
- GRAVEL
  - SAND
  - SILT
  - CLAY
  - SANDY CLAY or CLAYEY SAND
  - SANDY SILT or SILTY SAND
  - SILT CLAY
  - CLAYEY SILT
  - PEAT and/or ORGANIC MATTER
  - FILL MATERIAL
  - COBBLE
  - IGNEOUS ROCK
  - SEDIMENTARY ROCK
  - METAMORPHIC

**CONSISTENCY CLASSIFICATION FOR SOILS**

According to the Standard Penetration Test

SPT N-value (blows/30cm)	Consistency
0-4	Very Loose
5-10	Loose
11-20	Medium Dense
21-30	Dense
31-50	Very Dense
50	Hard


NOTE: Classification of earth material as shown on this sheet is based upon field inspection and is not to be construed to imply mechanical analysis.

**BENCHMARKS**

STATION	OFFSET	N	E	ELEV	DESCRIPTION
15+79.190	4.62 Rt	618564.792	2062442.621	44.552	

**SURVEY CONTROL**

1. Coordinates bearing and distances are based on the California coordinate system of Nad 1983 HPGN, zone 6. (EPOCH 1991.35). Elevations are based on NGVD 29.

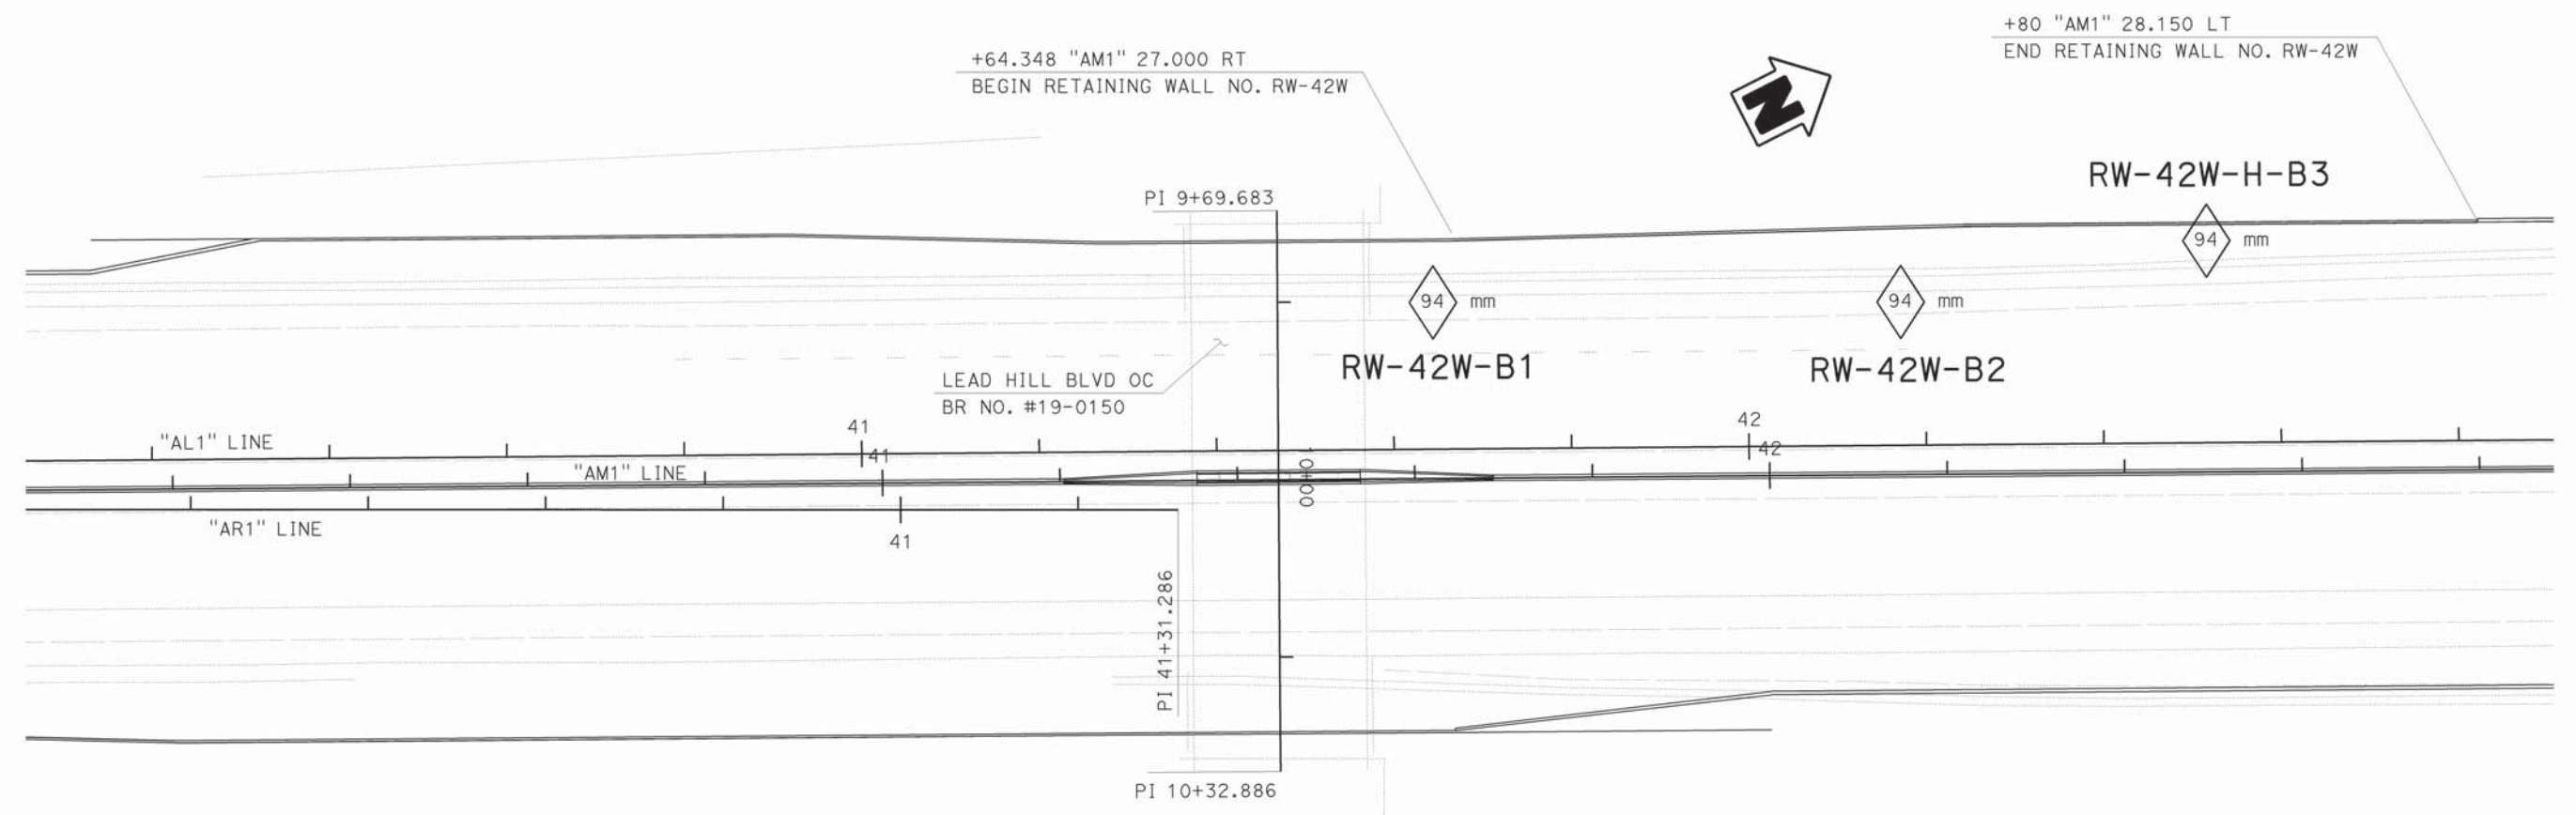

**PLAN**  
1:400

D Brittsan DESIGN OVERSIGHT June 29, 2007 SIGN OFF DATE	DRAWN BY A. Sanchez	Checked by B. Anderson, C.E.G.	Kleinfelder, Inc. FIELD INVESTIGATION BY: DATE: December 2006	PREPARED FOR THE <b>STATE OF CALIFORNIA</b> DEPARTMENT OF TRANSPORTATION	K. Chowdhury PROJECT ENGINEER	BRIDGE NO. 19E0006 KILOMETER POST 4.14	<b>RETAINING WALL 40W-42W</b> <b>LOG OF TEST BORINGS 6 OF 7</b>
--	------------------------	-----------------------------------	---	--	----------------------------------	---	--



CU 03262  
EA 367821

DISREGARD PRINTS BEARING EARLIER REVISION DATES	REVISION DATES (PRELIMINARY STAGE ONLY)	SHEET 28	OF 29
---	---	-------------	----------



DATE PLOTTED => 28-NOV-2007 TIME PLOTTED => 16:39 USERNAME => p7183 FILE => 19e0006-z-log-07.dgn



DIST	COUNTY	ROUTE	KILOMETER PROJECT TOTAL	POST PROJECT	SHEET No	TOTAL SHEETS
03	Sac, Pla	80	28.1/29.0	0.0/4.7	528	528

Khaled H. Chowdhury 6-27-07  
 REGISTERED CIVIL ENGINEER  
 11-26-07  
 PLANS APPROVAL DATE  
 The State of California or its officers or agents shall not be responsible for the accuracy or completeness of electronic copies of this plan sheet.  
 KLEINFELDER INC.  
 3077 FITE CIR.  
 SACRAMENTO, CA 95826

FOR PLAN VIEW AND ADDITIONAL NOTES, SEE "LOG OF TEST BORINGS" SHEET 1 OF 2

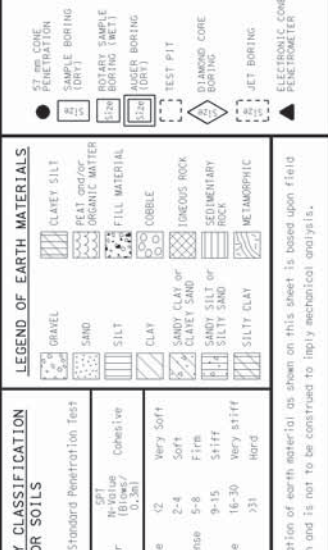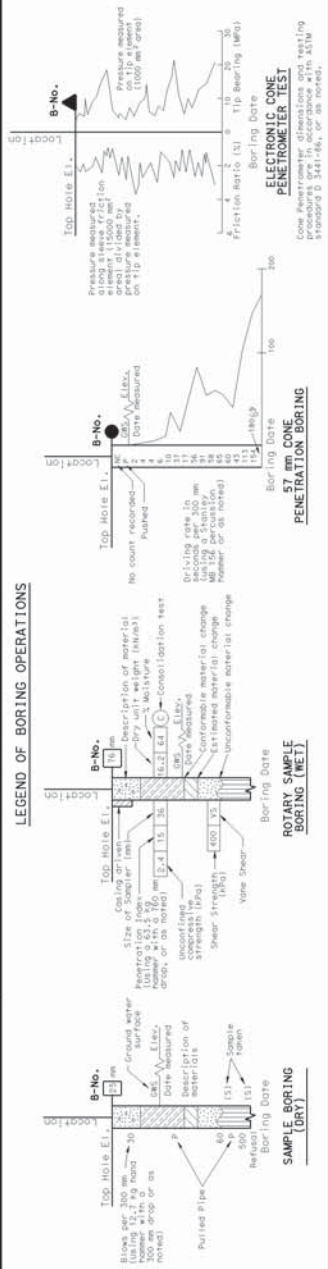


**CONSISTENCY CLASSIFICATION FOR SOILS**

According to the Standard Penetration Test

SPT	Relative Density	Consistency
0-4	Very Loose	Very Soft
5-10	Loose	Soft
11-20	Medium Dense	Firm
31-50	Dense	Stiff
50	Very Dense	Very Stiff
		Hard

NOTE: Classification of earth material as shown on this sheet is based upon field inspection and is not to be construed to imply mechanical analysis.

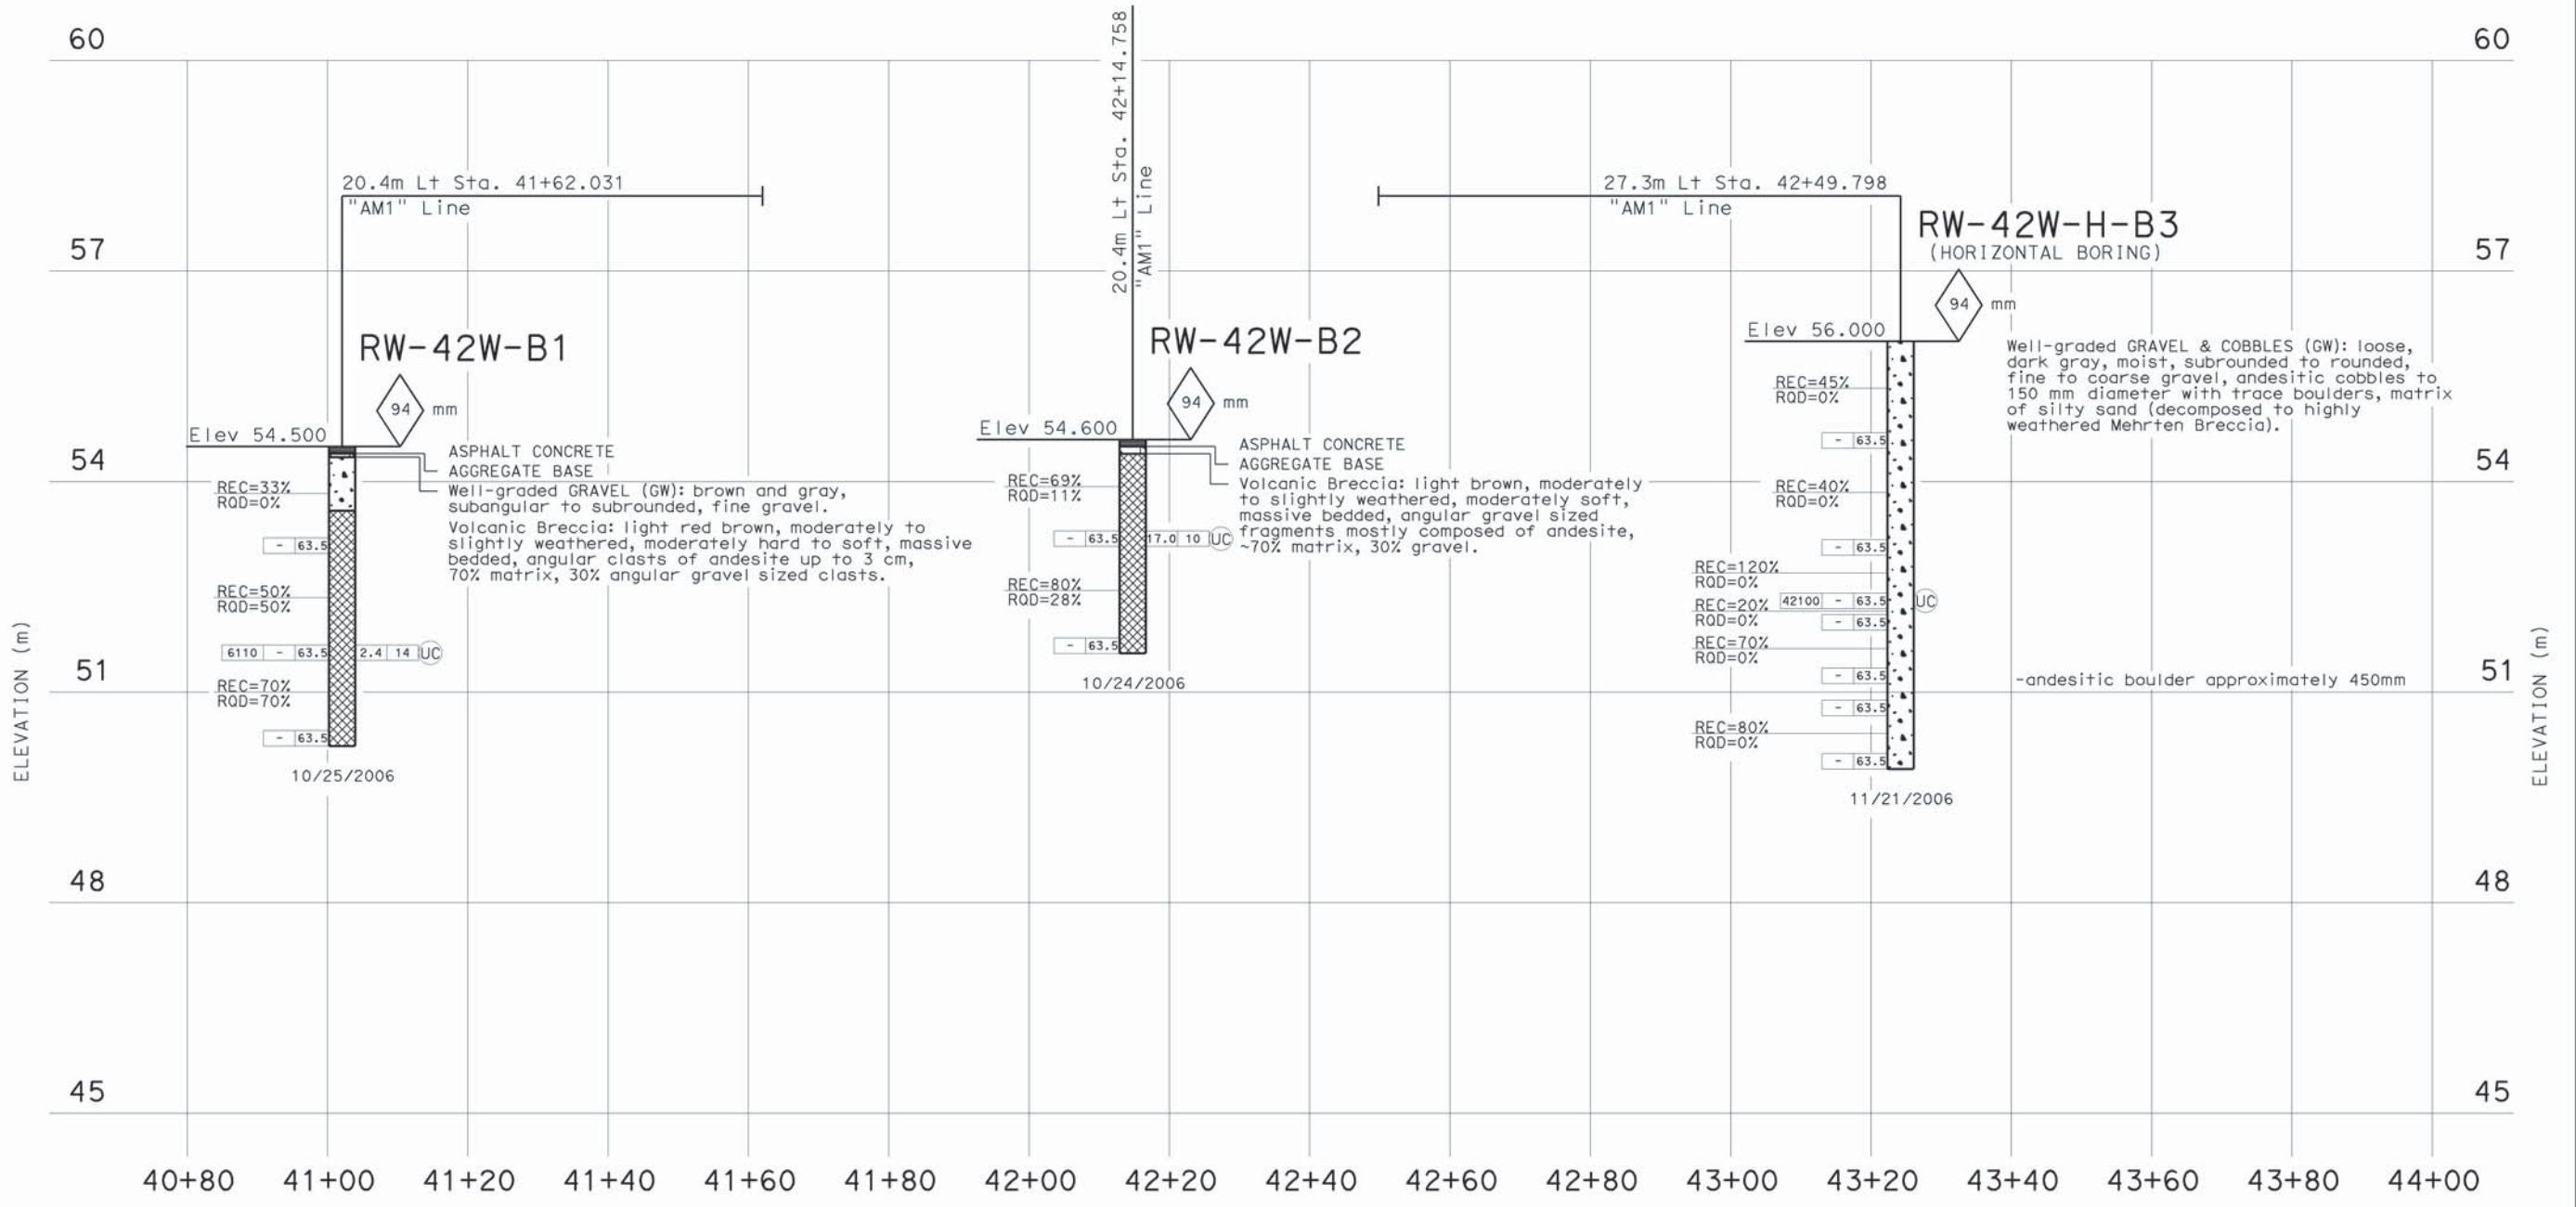

**PROFILE**  
 HOR. 1:500  
 VER. 1:50

D. Brittsan DESIGN OVERSIGHT June 29, 2007 SIGN OFF DATE	DRAWN BY A. Sanchez	Checked By B. Anderson, C.E.G.	Kleinfelder, Inc. FIELD INVESTIGATION BY: DATE: December 2006	PREPARED FOR THE STATE OF CALIFORNIA DEPARTMENT OF TRANSPORTATION	K. Chowdhury PROJECT ENGINEER	BRIDGE NO. 19E0006 KILOMETER POST 4.14	RETAINING WALL 40W-42W LOG OF TEST BORINGS 7 OF 7
---	------------------------	-----------------------------------	---	---	----------------------------------	---	--



DIST	COUNTY	ROUTE	KILOMETER POST TOTAL PROJECT	SHEET No	TOTAL SHEETS
03	Plq	80	4.5/8.3	508	539

5/28/08  
 REGISTERED CIVIL ENGINEER  
 11-17-08  
 PLANS APPROVAL DATE  
 The State of California or its officers or agents shall not be responsible for the accuracy or completeness of electronic copies of this plan sheet.

KLEINFELDER INC.  
 3077 FITE CIR.  
 SACRAMENTO, CA 95826

Notes:




- 51 mm samples were taken using a California split-barrel sampler with an inside diameter (I.D.) of 51 mm and an outside diameter (O.D.) of 64 mm.
- A safety semi-automatic hammer (63.5 kg) with a 760 mm drop was used to advance the sampler.
- Blowcounts noted for boring are field blowcounts and have not been corrected.
- 35 mm samples were taken using a SPT split-barrel sampler with an inside diameter (I.D.) of 35 mm and an outside diameter (O.D.) of 51 mm.
- 63.5 mm core samples were taken using an HQ core sampler with a 63.5 mm inside diameter (I.D.) and 94 mm outside diameter (O.D.) core barrel.
- Blowcounts 50/125 means 50 blows per 125 mm penetration.
- Groundwater was not encountered at the time of drilling.
- The descriptions and classifications of soil, including consistency and relative density descriptions, used by the field personnel for the exploration bore holes on "Soil and Rock Logging Classification Manual (Field Guide)", Engineering Service Center, Office of Structural Foundations, August 1996.

BENCHMARKS


STATION	OFFSET	N	E	ELEV	DESCRIPTION
15+79.190	4.62 Rt	618564.792	2062442.621	44.552	

SURVEY CONTROL

- Coordinates bearing and distances are based on the California coordinate system of Nad 1983 HPGN, zone 6. (EPOCH 1991.35). Elevations are based on NGVD 29.

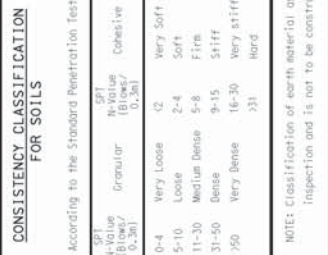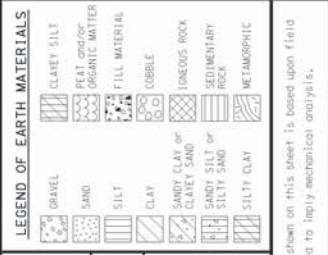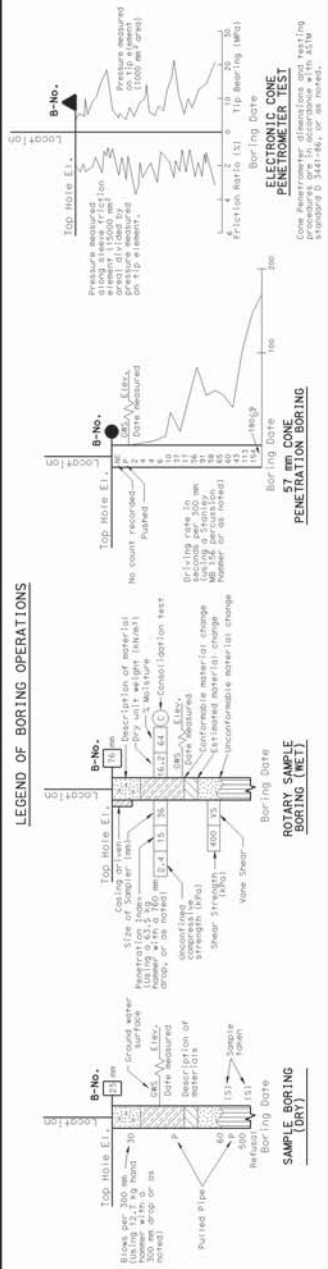

NOTE: Classification of earth material as shown on this sheet is based upon field inspection and is not to be construed to imply mechanical analysis.

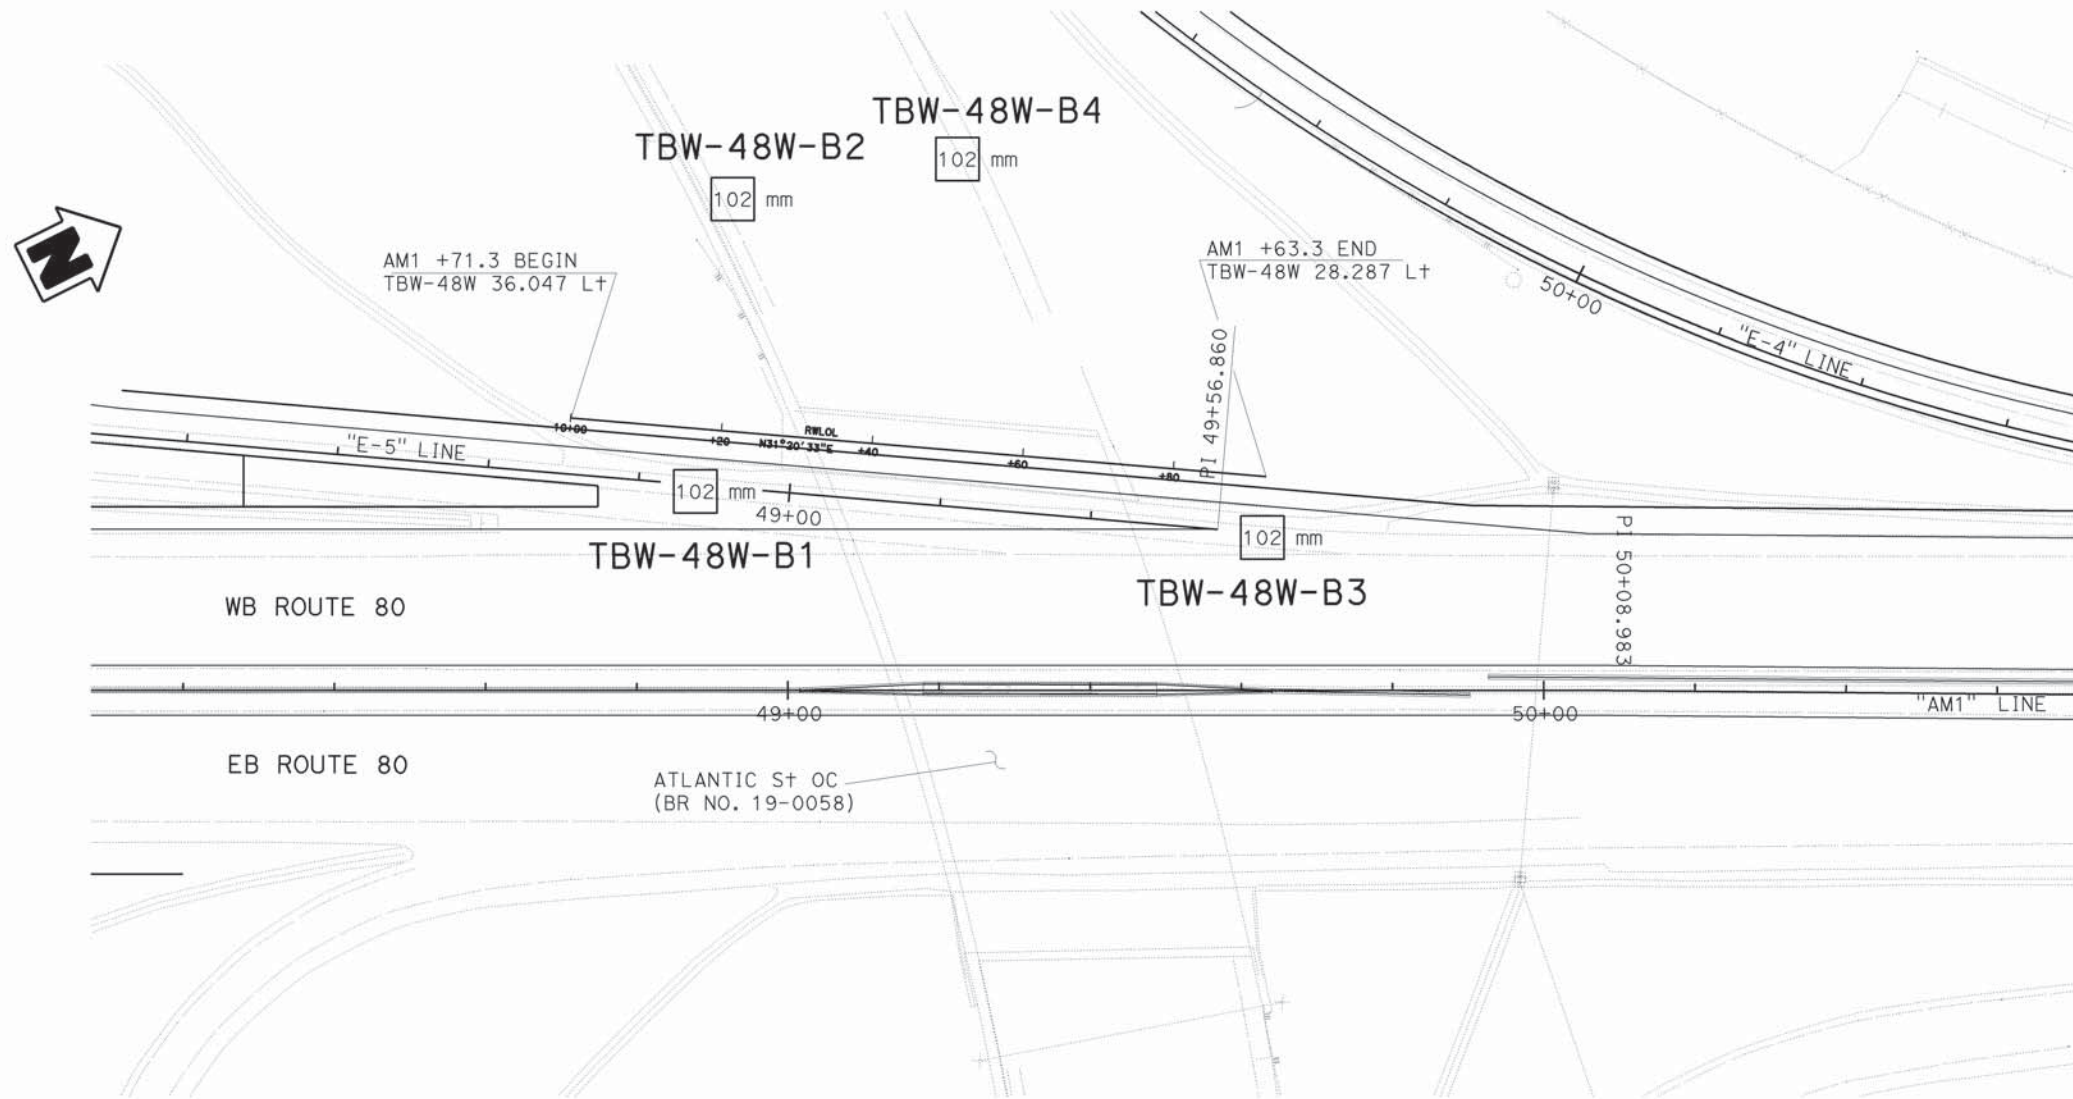

PLAN  
1:500

Kenneth Sorensen  
 DESIGN OVERSIGHT  
 05/18/08  
 SIGN OFF DATE

DRAWN BY  
A. Sanchez  
 CHECKED BY  
G. Zhang


G. Zhang  
 FIELD INVESTIGATION BY:  
 DATE: 01/15/07

PREPARED FOR THE  
 STATE OF CALIFORNIA  
 DEPARTMENT OF TRANSPORTATION

PROJECT ENGINEER

BRIDGE NO.  
19E0008  
 KILOMETER POST  
4.7

RETAINING WALL - 48W  
 LOG OF TEST BORINGS 1 OF 4

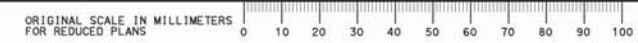




DIST	COUNTY	ROUTE	KILOMETER POST TOTAL PROJECT	SHEET No	TOTAL SHEETS
03	Plq	80	4.5/8.3	509	539

5/28/08  
 REGISTERED CIVIL ENGINEER  
 11-17-08  
 PLANS APPROVAL DATE  
 The State of California or its officers or agents shall not be responsible for the accuracy or completeness of electronic copies of this plan sheet.



KLEINFELDER INC.  
 3077 FITE CIR.  
 SACRAMENTO, CA 95826

FOR PLAN VIEW AND ADDITIONAL NOTES, SEE "LOG OF TEST BORINGS" SHEET 1 OF 3

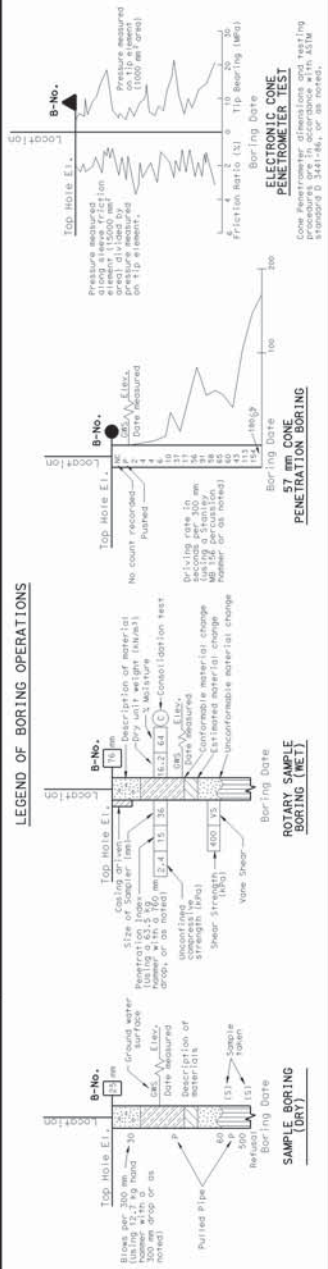

- 57 mm CONE PENETRATION
- SAMPLE BORING (DRY)
- ROTARY SAMPLE BORING (WET)
- ASPER BORING
- TEST PIT
- DIAMOND CORE BORING
- JET BORING
- ELECTRONIC CONE PENETROMETER


LEGEND OF EARTH MATERIALS

GRAVEL	CLAYEY SILT
SAND	PEAT and/or ORGANIC MATTER
SILT	FILL MATERIAL
CLAY	COBBLE
SANDY CLAY or CLAYEY SAND	INDURATED ROCK
SANDY SILT or SILTY SAND	SEDIMENTARY ROCK
SILTY CLAY	METAMORPHIC

CONSISTENCY CLASSIFICATION FOR SOILS

SPT	Penetration	Consistency
0-4	Very Loose	Very Soft
5-10	Loose	Soft
11-30	Medium Dense	Firm
31-50	Dense	Stiff
50	Very Dense	Very Stiff
		Hard

NOTE: Classification of earth material as shown on this sheet is based upon field inspection and is not to be construed to imply mechanical analysis.

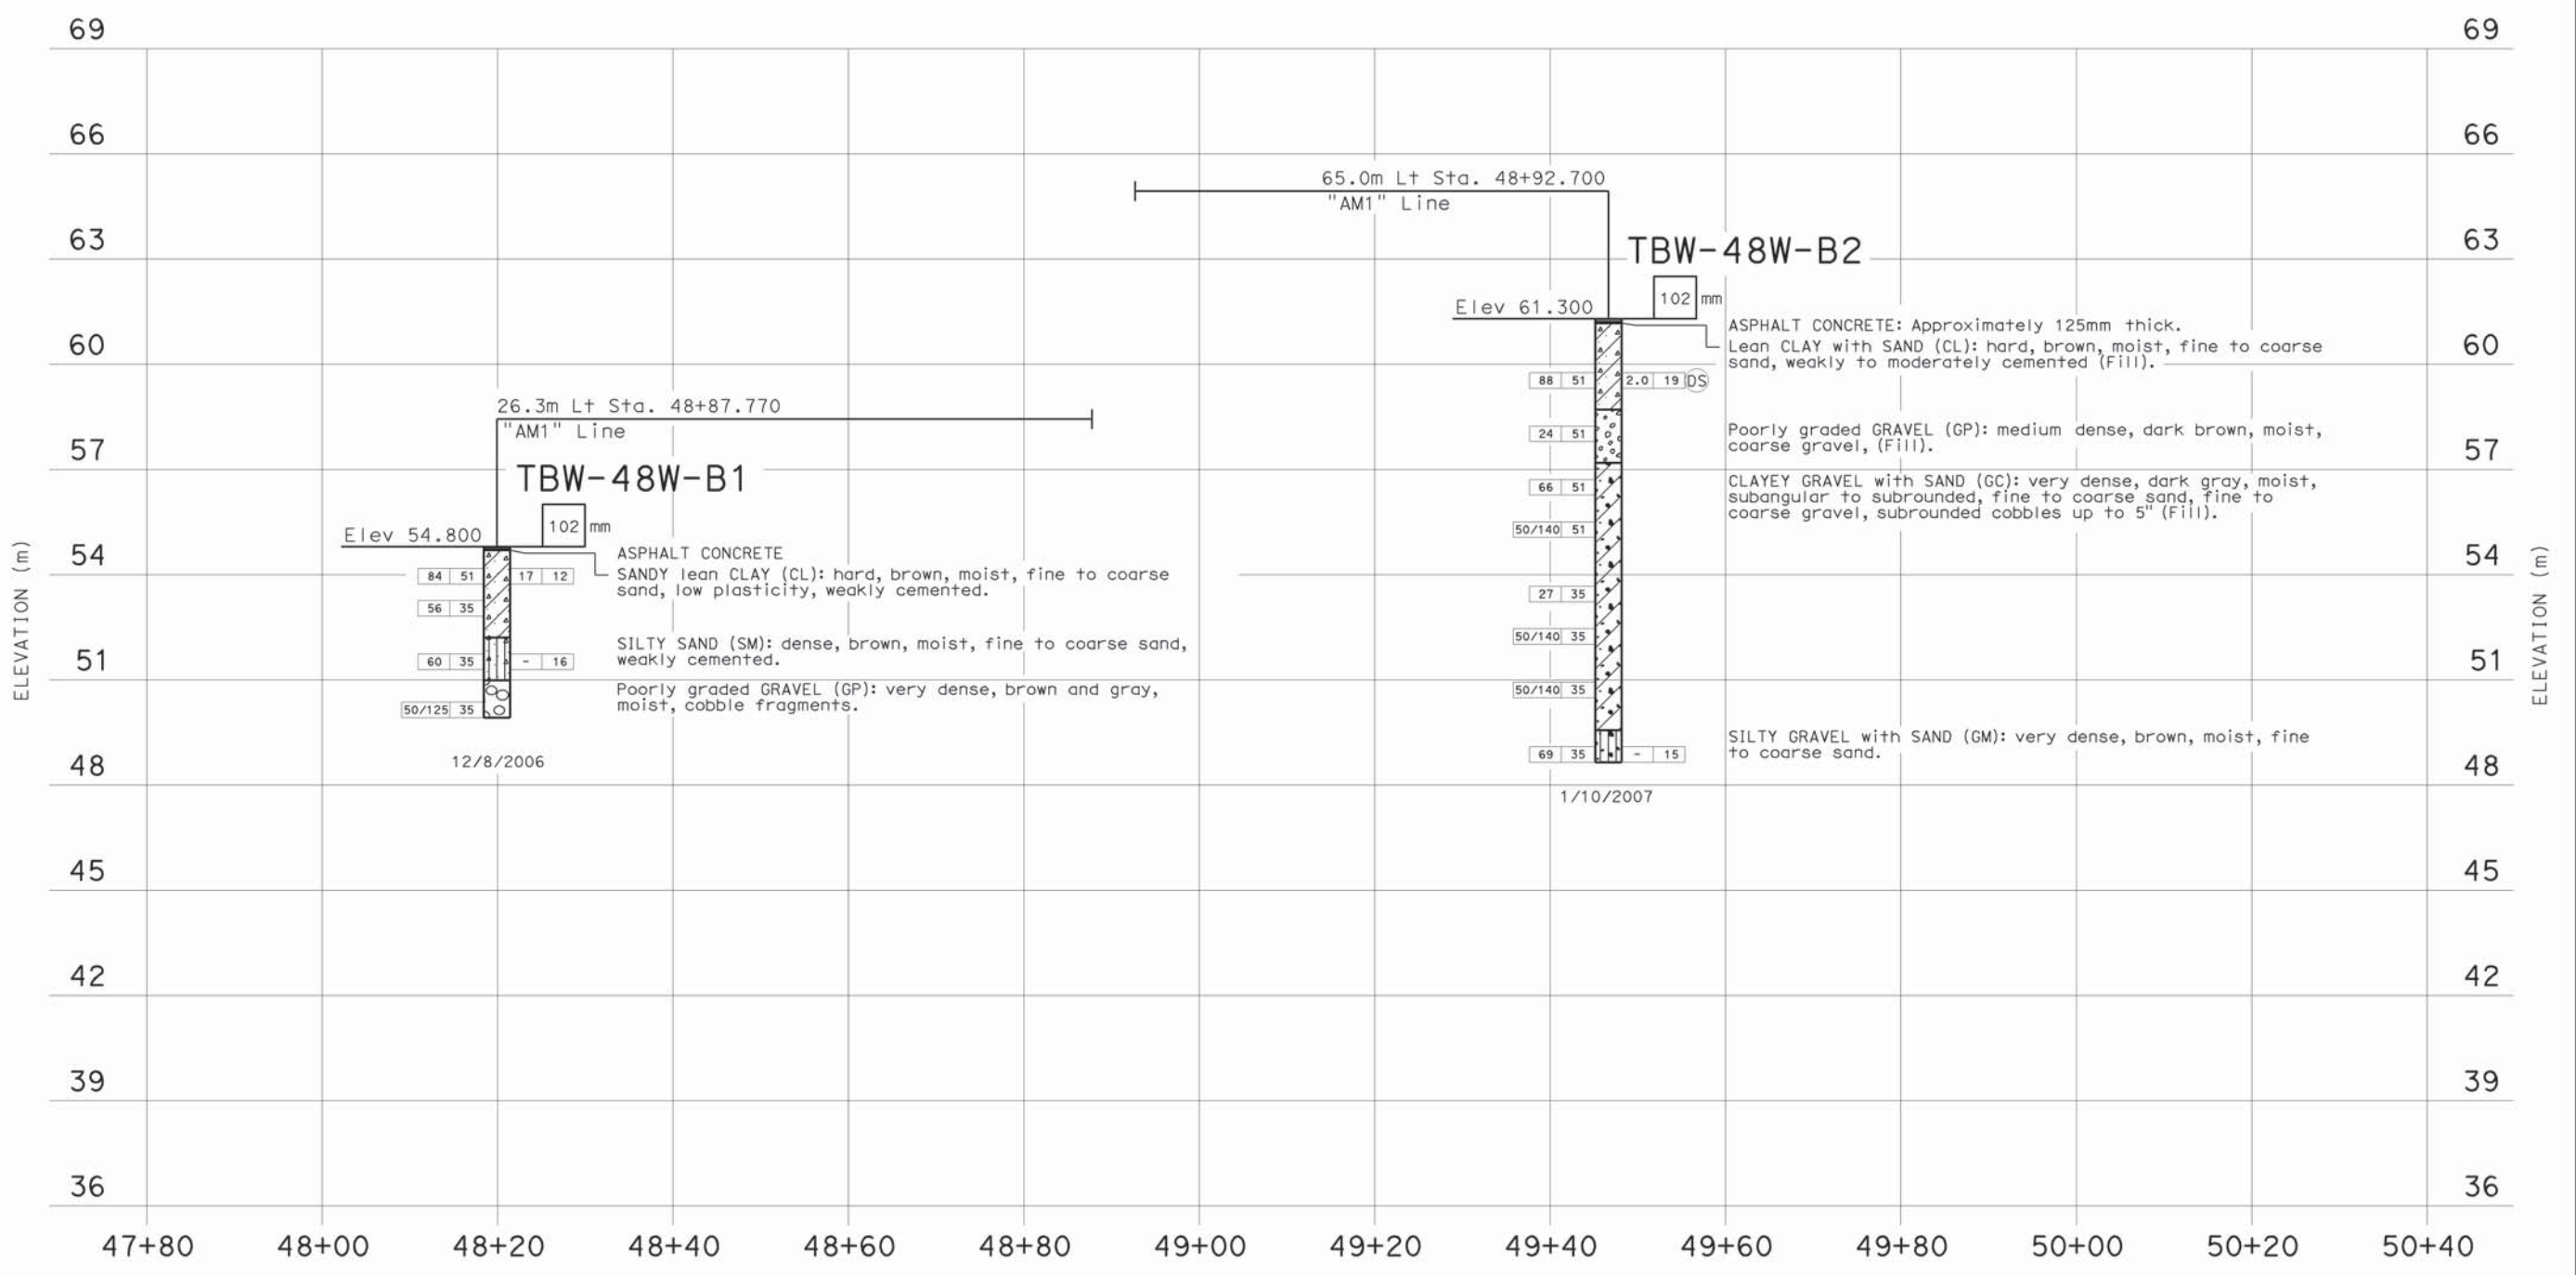

PROFILE  
 HOR. 1:400  
 VER. 1:100

Kenneth Sorensen DESIGN OVERSIGHT 05/18/08 SIGN OFF DATE	DRAWN BY A. Sanchez	G. Zhang FIELD INVESTIGATION BY: DATE: 01/15/07	BRIDGE NO. 19E0008	RETAINING WALL - 48W LOG OF TEST BORINGS 2 OF 4
	CHECKED BY G. Zhang	PREPARED FOR THE STATE OF CALIFORNIA DEPARTMENT OF TRANSPORTATION	PROJECT ENGINEER KILOMETER POST 4.7	






DIST	COUNTY	ROUTE	KILOMETER POST TOTAL PROJECT	SHEET No	TOTAL SHEETS
03	Plq	80	4.5/8.3	510	539

FOR PLAN VIEW AND ADDITIONAL NOTES, SEE "LOG OF TEST BORINGS" SHEET 1 OF 3

5/28/08  
 REGISTERED CIVIL ENGINEER  
 11-17-08  
 PLANS APPROVAL DATE  
 The State of California or its officers or agents shall not be responsible for the accuracy or completeness of electronic copies of this plan sheet.  
 KLEINFELDER INC.  
 3077 FITE CIR.  
 SACRAMENTO, CA 95826

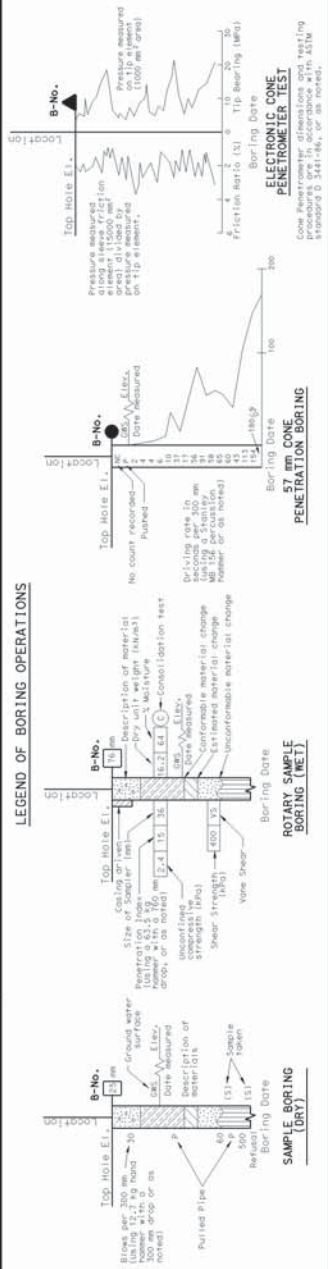


- 57 mm CONE PENETRATION
- SAMPLE BORING (DRY)
- ROTARY SAMPLE BORING (WET)
- AUGER BORING (DRY)
- TEST PIT
- DIAMOND CORE BORING
- JET BORING
- ELECTRONIC CONE PENETROMETER

- LEGEND OF EARTH MATERIALS
- GRAVEL
  - SAND
  - SILT
  - CLAY
  - SANDY CLAY or CLAYEY SAND
  - CLAYEY SILT or SILTY SAND
  - SILTY CLAY
  - CLAYEY SILT
  - PEAT and/or ORGANIC MATERIAL
  - FILL MATERIAL
  - COBBLE
  - IGNEOUS ROCK
  - SEDIMENTARY ROCK
  - METAMORPHIC

CONSISTENCY CLASSIFICATION FOR SOILS

SPT	Flow Value	Consistency
0-4	Very Loose	Very Soft
5-10	Loose	Soft
11-20	Medium Dense	Firm
21-30	Dense	Stiff
31-50	Very Dense	Very Stiff
50		Hard

NOTE: Classification of earth material as shown on this sheet is based upon field inspection and is not to be construed to imply mechanical analysis.

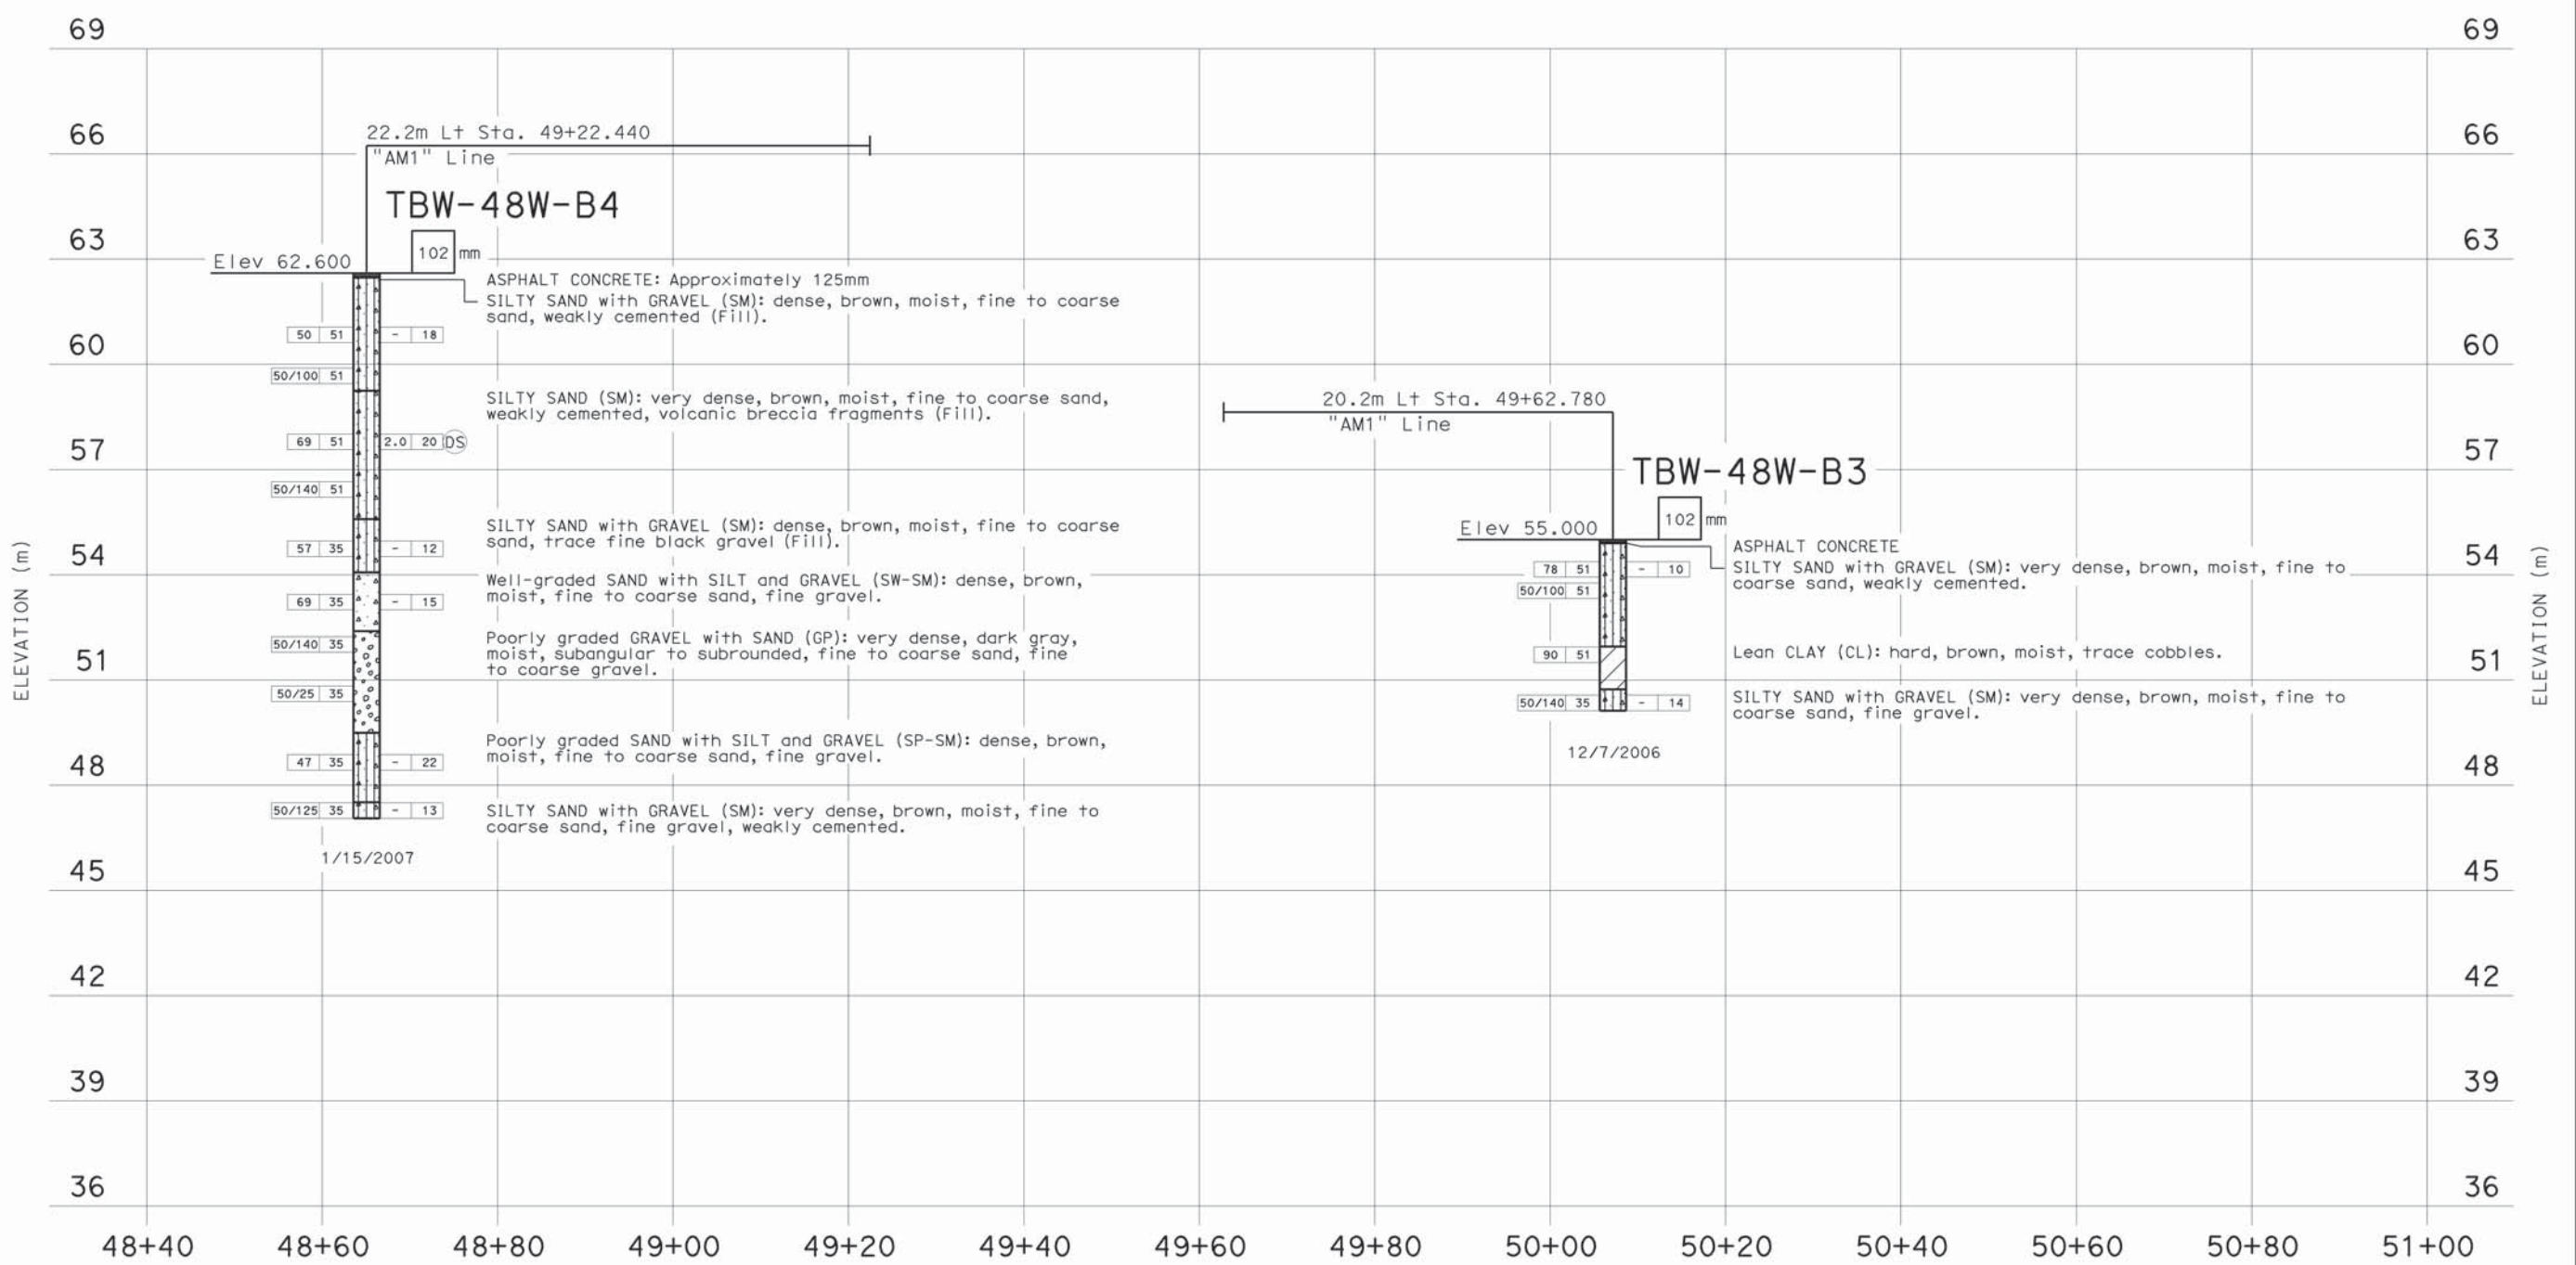


PROFILE  
 HOR. 1:400  
 VER. 1:100

Kenneth Sorensen DESIGN OVERSIGHT 05/18/08 SIGN OFF DATE	DRAWN BY A. Sanchez	G. Zhang FIELD INVESTIGATION BY: DATE: 01/15/07	BRIDGE NO. 19E0008	PROJECT ENGINEER	RETAINING WALL - 48W
	CHECKED BY G. Zhang		KILOMETER POST 4.7		LOG OF TEST BORINGS 3 OF 4



DIST	COUNTY	ROUTE	KILOMETER POST TOTAL PROJECT	SHEET No	TOTAL SHEETS
03	Plq	80	4.5/8.3	511	539

5/28/08  
 REGISTERED CIVIL ENGINEER  
 11-17-08  
 PLANS APPROVAL DATE  
 The State of California or its officers or agents shall not be responsible for the accuracy or completeness of electronic copies of this plan sheet.  
 KLEINFELDER INC.  
 3077 FITE CIR.  
 SACRAMENTO, CA 95826

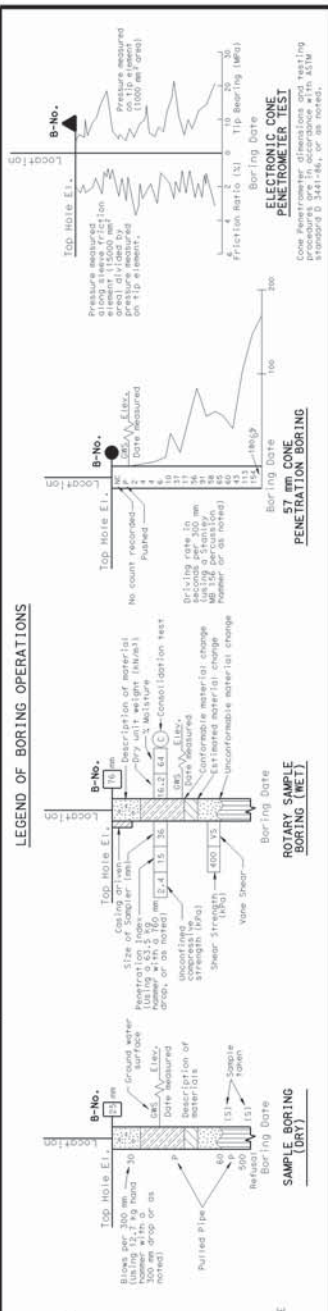


Descriptors		WEATHERING DESCRIPTORS				Diagnostic features	
Alphanumeric descriptor	Descriptive term	Chemical weathering-Discoloration and/or oxidation		Mechanical weathering-Grain boundary conditions (disaggregation) primarily for granitics and some coarse-grained sediments	Texture and solutioning		General characteristics (strength, excavation, etc.) <sup>§</sup>
		Body of rock	Fracture surfaces <sup>†</sup>	Texture	Solutioning		
W1	Fresh	No discoloration, not oxidized.	No discoloration or oxidation.	No separation, intact (tight).	No change.	No solutioning.	Hammer rings when crystalline rocks are struck. Almost always rock excavation except for naturally weak or weakly cemented rocks such as siltstones or shales.
W2	Slightly weathered to fresh <sup>o</sup>						
W3	Slightly weathered	Discoloration or oxidation is limited to surface of, or short distance from, fractures; some feldspar crystals are dull.	Minor to complete discoloration or oxidation of most surfaces.	No visible separation, intact (tight).	Preserved.	Minor leaching of some soluble minerals may be noted.	Hammer rings when crystalline rocks are struck. Body of rock not weakened. With few exceptions, such as siltstones or shales, classified as rock excavation.
W4	Moderately to slightly weathered <sup>o</sup>						
W5	Moderately weathered	Discoloration or oxidation extends from fractures; Fe-Mg minerals are "rusty," feldspar crystals are "cloudy."	All fracture surfaces are discolored or oxidized.	Partial separation of boundaries visible.	Generally preserved.	Soluble minerals may be mostly leached.	Hammer does not ring when rock is struck. Body of rock is slightly weakened. Depending on fracturing, usually is rock excavation except in naturally weak rocks such as siltstones or shales.
W6	Intensely to moderately weathered <sup>o</sup>						
W7	Intensely weathered	Discoloration or oxidation throughout; all feldspars and Fe-Mg minerals are altered to clay to some extent; or chemical alteration produces in-situ disaggregation, see grain boundary conditions.	All fracture surfaces are discolored or oxidized, surfaces friable.	Partial separation, rock is friable; in semi-arid conditions granitics are disaggregated.	Texture altered by chemical disintegration (hydration, argillation).	Leaching of soluble minerals may be complete.	Dull sound when struck with hammer, usually can be broken with moderate to heavy manual pressure or by light hammer blow without reference to planes of weakness such as incipient or hairline fractures, or veinlets. Rock is significantly weakened. Usually common excavation.
W8	Very intensely weathered						
W9	Decomposed	Discolored or oxidized throughout, but resistant minerals such as quartz may be unaltered; all feldspars and Fe-Mg minerals are completely altered to clay.		Complete separation of grain boundaries (disaggregated).	Resembles a soil, partial or complete remnant rock structure may be preserved; leaching of soluble minerals usually complete.		Can be granulated by hand, always common excavation. Resistant minerals such as quartz may be present as "stringers" or "dikes."

Note: This chart and its horizontal categories are more readily applied to rocks with feldspars and mafic minerals. Weathering in various sedimentary rocks, particularly limestones and poorly indurated sediments, will not always fit the categories established. This chart and weathering categories may have to be modified for particular site conditions or alteration such as hydrothermal effects; however, the basic framework and similar descriptors are to be used.

<sup>o</sup> Combination descriptors are permissible where equal distribution of both weathering characteristics are present over significant intervals or where characteristics present are "in between" the diagnostic feature. However, dual descriptors should not be used where significant, identifiable zones can be delineated. When given as a range, only two adjacent terms may be combined. "Decomposed to slightly weathered," or "moderately weathered to fresh" are not acceptable.


<sup>†</sup> Does not include diffractonal weathering along shears or faults and their associated features. For example, a shear zone that carried weathering to great depths into a fresh rock mass would not require the rock mass to be classified as weathered.

<sup>§</sup> These are generalizations and should not be used as diagnostic features for weathering or excavation classification. These characteristics vary to a large extent based on naturally weak materials or cementation and type of excavation.

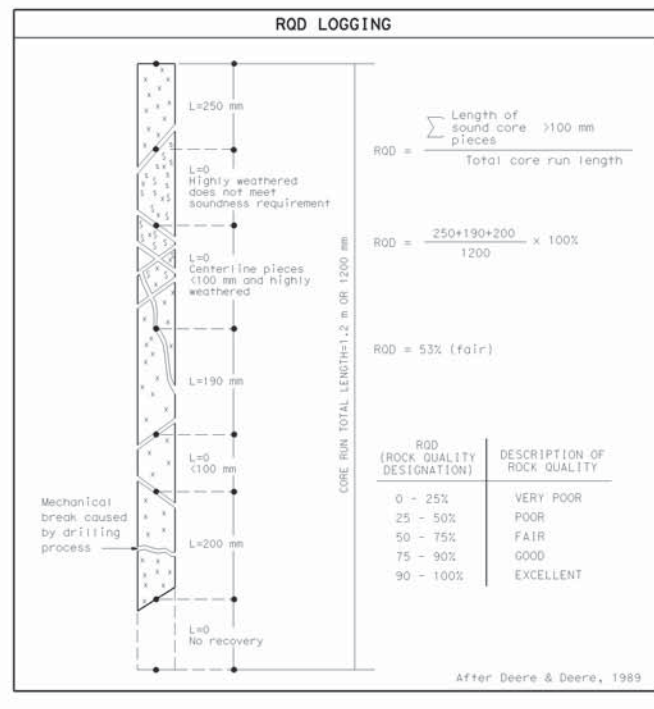

BEDDING, FOLIATION, OR FLOW TEXTURE DESCRIPTORS	
Descriptors	Thickness / Spacing
Massive	Greater than 3 m
Very thickly (bedded, foliated, or banded)	1 to 3 m
Thickly	300 mm to 1 m
Moderately	100 to 300 mm
Thinly	30 to 100 mm
Very thinly	10 to 30 mm
Laminated (intensely foliated or banded)	Less than 10 mm

Modified from United States Bureau of Reclamation, Engineering Geology Field manual.

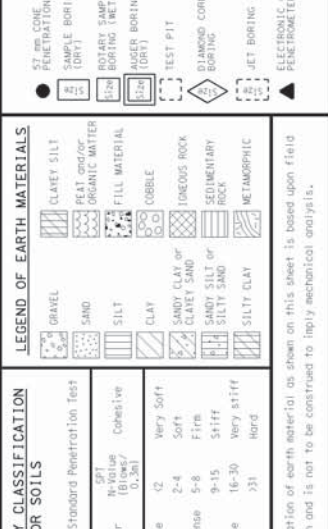

FRACTURE DENSITY	
FRACTURE DENSITY- Based on the spacing of all natural fractures in an exposure or core recovery lengths in boreholes; excludes mechanical breaks, shears, and shear zones; however, shear-distributed zones (fracturing outside the shear) are included. Descriptors for fracture density apply to all rock exposures such as tunnel walls, gater trenches, outcrops, or foundation cut slopes and inverts, as well as boreholes. Descriptive criteria presented below are based on borehole cores where lengths are measured along the core axis, for other exposures the criteria is distance measured between fractures (size of blocks).	
UNFRACTURED (FD0): No fractures.	
VERY SLIGHTLY FRACTURED (FD1): Core recovered mostly in lengths greater than 1 m.	
SLIGHTLY TO VERY SLIGHTLY FRACTURED (FD2)*	
SLIGHTLY FRACTURED (FD3): Core recovered mostly in lengths from 300 to 1000 mm, with few scattered lengths less than 300 mm or greater than 1000 mm.	
MODERATELY TO SLIGHTLY FRACTURED (FD4)*	
MODERATELY FRACTURED (FD5): Core recovered mostly in 100 to 300 mm lengths with most lengths about 200 mm.	
INTENSELY TO MODERATELY FRACTURED (FD6)*	
INTENSELY FRACTURED (FD7): Lengths average from 30 to 100 mm with scattered fragmented intervals. Core recovered mostly in lengths less than 100 mm.	
VERY INTENSELY TO INTENSELY FRACTURED (FD8)*	
VERY INTENSELY FRACTURED (FD9): Core recovered mostly as chips and fragments with a few scattered short core lengths.	
* Combinations of fracture densities (e.g. very intensely to intensely fractured, or moderately to slightly fractured) are used where equal distribution of both fracture density characteristics are present over a significant interval or exposure, or where characteristics are "in between" the descriptor definitions.	

ROCK HARDNESS/STRENGTH DESCRIPTORS		
Alphanumeric Descriptor	Descriptor	Criteria
H1	Extremely hard	Core, fragment, or exposure cannot be scratched with knife or sharp pick; can only be chipped with repeated heavy hammer blows.
H2	Very hard	Cannot be scratched with knife or sharp pick. Core or fragment breaks with repeated heavy hammer blows.
H3	Hard	Can be scratched with knife or sharp pick with difficulty (heavy pressure). Heavy hammer blow required to break specimen.
H4	Moderately hard	Can be scratched with knife or sharp pick with moderate pressure. Core or fragment breaks with moderate hammer blow.
H5	Moderately soft	Can be grooved 2 mm deep by knife or sharp pick with moderate or heavy pressure. Core or fragment breaks with light hammer blow or heavy manual pressure.
H6	Soft	Can be grooved or gouged easily by knife or sharp pick with light pressure, can be scratched with fingernail. Breaks with light to moderate manual pressure.
H7	Very soft	Can be readily indented, grooved or gouged with fingernail, or carved with a knife. Breaks with light manual pressure.
Any bedrock unit softer than H7, very soft, is to be described using ASTM D-2488 consistency descriptors.		
Note: Although "sharp pick" is included in these definitions, descriptions of ability to be scratched, grooved or gouged by a knife is the preferred criteria. Modified from United States Bureau of Reclamation, Engineering Geology Field manual.		

IN-SITU, LAB & FIELD TEST DESIGNATIONS	
AL	ATTERBERG LIMITS
CA	CHEMICAL ANALYSIS
CN	CONSOLIDATION
CU	CONSOLIDATED UNDRAINED TRIAXIAL
DS	DIRECT SHEAR
MD	MAX. DRY DENSITY
PP	POCKET PENETROMETER
SA	SIEVE ANALYSIS
TV	TORVANE
UC	UNCONFINED COMPRESSION
UU	UNCONSOLIDATED UNDRAINED TRIAXIAL
VS	VANE SHEAR

Kenneth Sorensen DESIGN OVERSIGHT 05/18/08 SIGN OFF DATE	DRAWN BY A. Sanchez	G. Zhang FIELD INVESTIGATION BY: DATE: 01/15/07	BRIDGE NO. 19E008	RETAINING WALL - 48W LOG OF TEST BORINGS 4 OF 4
	CHECKED BY G. Zhang	DEPARTMENT OF TRANSPORTATION	KILOMETER POST 4.7	
CIVIL LOG OF TEST BORINGS SHEET (METRIC) (REV. 2/1/00)			PROJECT ENGINEER	REVISION DATES (PRELIMINARY STAGE ONLY)
ORIGINAL SCALE IN MILLIMETERS FOR REDUCED PLANS			CU 03262 EA 367831	SHEET 14 OF 14

USERNAME = jrricht DATE PLOTTED = 21-NOV-2008 TIME PLOTTED = 15:43







DIST	COUNTY	ROUTE	KILOMETER POST TOTAL PROJECT	SHEET No	TOTAL SHEETS
03	Pla	80	4.5/8.3	522	539

9/12/08  
 REGISTERED CIVIL ENGINEER  
 11-17-08  
 PLANS APPROVAL DATE  
 The State of California or its officers or agents shall not be responsible for the accuracy or completeness of electronic copies of this plan sheet.



KLEINFELDER INC.  
 3077 FITE CIR.  
 SACRAMENTO, CA 95827

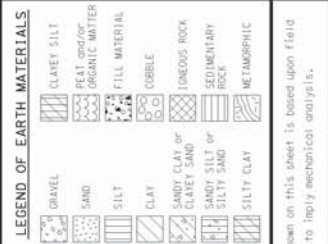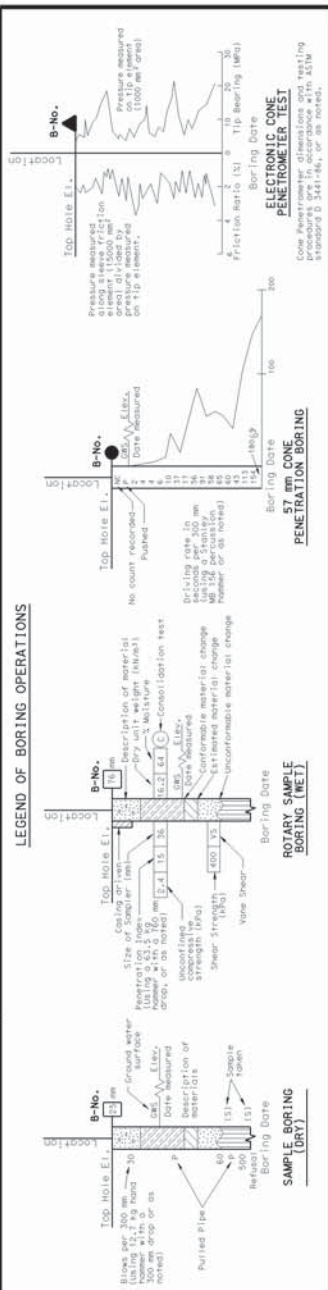

CONSISTENCY CLASSIFICATION FOR SOILS

SPPT	Relative Density (D <sub>r</sub> )	Consistency
0-4	Very Loose	Very Soft
5-10	Loose	Soft
11-20	Medium Dense	Firm
31-50	Dense	Stiff
50	Very Dense	Very Stiff
		Hard

Descriptors		WEATHERING DESCRIPTORS				Diagnostic features	
Alphanumeric descriptor	Descriptive term	Chemical weathering-Discoloration and/or oxidation		Mechanical weathering-Grain boundary conditions (disaggregation) primarily for granitics and some coarse-grained sediments	Texture and solutioning		General characteristics (strength, excavation, etc.) <sup>§</sup>
		Body of rock	Fracture surfaces	Texture	Solutioning		
W1	Fresh	No discoloration, not oxidized.	No discoloration or oxidation.	No separation, intact (tight).	No change.	No solutioning.	Hammer rings when crystalline rocks are struck. Almost always rock excavation except for naturally weak or weakly cemented rocks such as siltstones or shales.
W2	Slightly weathered to fresh <sup>o</sup>						
W3	Slightly weathered	Discoloration or oxidation is limited to surface of, or short distance from, fractures; some feldspar crystals are dull.	Minor to complete discoloration or oxidation of most surfaces.	No visible separation, intact (tight).	Preserved.	Minor leaching of some soluble minerals may be noted.	Hammer rings when crystalline rocks are struck. Body of rock not weakened. With few exceptions, such as siltstones or shales, classified as rock excavation.
W4	Moderately to slightly weathered <sup>o</sup>						
W5	Moderately weathered	Discoloration or oxidation extends from fractures; Fe-Mg minerals are "rusty," feldspar crystals are "cloudy."	All fracture surfaces are discolored or oxidized.	Partial separation of boundaries visible.	Generally preserved.	Soluble minerals may be mostly leached.	Hammer does not ring when rock is struck. Body of rock is slightly weakened. Depending on fracturing, usually is rock excavation except in naturally weak rocks such as siltstones or shales.
W6	Intensely to moderately weathered <sup>o</sup>						
W7	Intensely weathered	Discoloration or oxidation throughout; all feldspars and Fe-Mg minerals are altered to clay to some extent; or chemical alteration produces in-situ disaggregation, see grain boundary conditions.	All fracture surfaces are discolored or oxidized, surfaces friable.	Partial separation, rock is friable; in semi-arid conditions granitics are disaggregated.	Texture altered by chemical disintegration (hydration, argillation).	Leaching of soluble minerals may be complete.	Dull sound when struck with hammer, usually can be broken with moderate to heavy manual pressure or by light hammer blow without reference to planes of weakness such as incipient or hairline fractures, or veinlets. Rock is significantly weakened. Usually common excavation.
W8	Very intensely weathered						
W9	Decomposed	Discolored or oxidized throughout, but resistant minerals such as quartz may be unaltered; all feldspars and Fe-Mg minerals are completely altered to clay.		Complete separation of grain boundaries (disaggregated).	Resembles a soil, partial or complete remnant rock structure may be preserved; leaching of soluble minerals usually complete.		Can be granulated by hand, always common excavation. Resistant minerals such as quartz may be present as "stringers" or "dikes."


Note: This chart and its horizontal categories are more readily applied to rocks with feldspars and mafic minerals. Weathering in various sedimentary rocks, particularly limestones and poorly indurated sediments, will not always fit the categories established. This chart and weathering categories may have to be modified for particular site conditions or alteration such as hydrothermal effects; however, the basic framework and similar descriptors are to be used.

<sup>o</sup> Combination descriptors are permissible where equal distribution of both weathering characteristics are present over significant intervals or where characteristics present are "in between" the diagnostic feature. However, dual descriptors should not be used where significant, identifiable zones can be delineated. When given as a range, only two adjacent terms may be combined. "Decomposed to slightly weathered," or "moderately weathered to fresh" are not acceptable.

<sup>1</sup> Does not include diffractonal weathering along shears or faults and their associated features. For example, a shear zone that carried weathering to great depths into a fresh rock mass would not require the rock mass to be classified as weathered.

<sup>§</sup> These are generalizations and should not be used as diagnostic features for weathering or excavation classification. These characteristics vary to a large extent based on naturally weak materials or cementation and type of excavation.

FRACTURE DENSITY		ROCK HARDNESS/STRENGTH DESCRIPTORS	
Modified from United States Bureau of Reclamation, Engineering Geology Field manual.		Modified from United States Bureau of Reclamation, Engineering Geology Field manual.	
<p><b>FRACTURE DENSITY</b>- Based on the spacing of all natural fractures in an exposure or core recovery lengths in boreholes; excludes mechanical breaks, shears, and shear zones; however, shear-distributed zones (fracturing outside the shear) are included. Descriptors for fracture density apply to all rock exposures such as tunnel walls, gater trenches, outcrops, or foundation cut slopes and inverts, as well as boreholes. Descriptive criteria presented below are based on borehole cores where lengths are measured along the core axis, for other exposures the criteria is distance measured between fractures (size of blocks).</p> <p><b>UNFRACTURED (FD0):</b> No fractures.</p> <p><b>VERY SLIGHTLY FRACTURED (FD1):</b> Core recovered mostly in lengths greater than 1 m.</p> <p><b>SLIGHTLY TO VERY SLIGHTLY FRACTURED (FD2)*</b></p> <p><b>SLIGHTLY FRACTURED (FD3):</b> Core recovered mostly in lengths from 300 to 1000 mm, with few scattered lengths less than 300 mm or greater than 1000 mm.</p> <p><b>MODERATELY TO SLIGHTLY FRACTURED (FD4)*</b></p> <p><b>MODERATELY FRACTURED (FD5):</b> Core recovered mostly in 100 to 300 mm lengths with most lengths about 200 mm.</p> <p><b>INTENSELY TO MODERATELY FRACTURED (FD6)*</b></p> <p><b>INTENSELY FRACTURED (FD7):</b> Lengths average from 30 to 100 mm with scattered fragmented intervals. Core recovered mostly in lengths less than 100 mm.</p> <p><b>VERY INTENSELY TO INTENSELY FRACTURED (FD8)*</b></p> <p><b>VERY INTENSELY FRACTURED (FD9):</b> Core recovered mostly as chips and fragments with a few scattered short core lengths.</p> <p>* Combinations of fracture densities (e.g. very intensely to intensely fractured, or moderately to slightly fractured) are used where equal distribution of both fracture density characteristics are present over a significant interval or exposure, or where characteristics are "in between" the descriptor definitions.</p>		<p><b>Alphanumeric Descriptor</b></p> <p>H1 Extremely hard Core, fragment, or exposure cannot be scratched with knife or sharp pick; can only be chipped with repeated heavy hammer blows.</p> <p>H2 Very hard Cannot be scratched with knife or sharp pick. Core or fragment breaks with repeated heavy hammer blows.</p> <p>H3 Hard Can be scratched with knife or sharp pick with difficulty (heavy pressure). Heavy hammer blow required to break specimen.</p> <p>H4 Moderately hard Can be scratched with knife or sharp pick with moderate pressure. Core or fragment breaks with moderate hammer blow.</p> <p>H5 Moderately soft Can be grooved 2 mm deep by knife or sharp pick with moderate or heavy pressure. Core or fragment breaks with light hammer blow or heavy manual pressure.</p> <p>H6 Soft Can be grooved or gouged easily by knife or sharp pick with light pressure, can be scratched with fingernail. Breaks with light to moderate manual pressure.</p> <p>H7 Very soft Can be readily indented, grooved or gouged with fingernail, or carved with a knife. Breaks with light manual pressure.</p> <p>Any bedrock unit softer than H7, very soft, is to be described using ASTM D-2488 consistency descriptors.</p> <p>Note: Although "sharp pick" is included in these definitions, descriptions of ability to be scratched, grooved or gouged by a knife is the preferred criteria. Modified from United States Bureau of Reclamation, Engineering Geology Field manual.</p>	

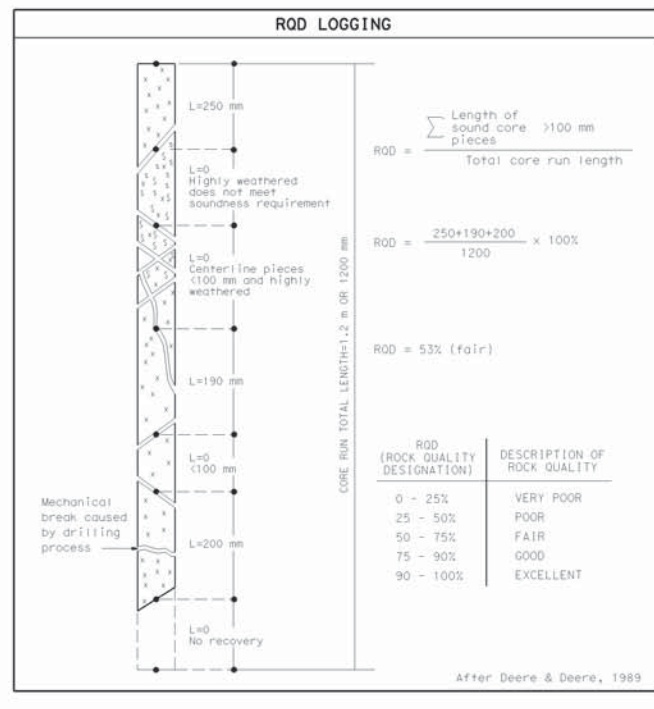

BEDDING, FOLIATION, OR FLOW TEXTURE DESCRIPTORS	
Descriptors	Thickness / Spacing
Massive	Greater than 3 m
Very thickly (bedded, foliated, or banded)	1 to 3 m
Thickly	300 mm to 1 m
Moderately	100 to 300 mm
Thinly	30 to 100 mm
Very thinly	10 to 30 mm
Laminated (intensely foliated or banded)	Less than 10 mm

ROD (ROCK QUALITY DESIGNATION)	DESCRIPTION OF ROCK QUALITY
0 - 25%	VERY POOR
25 - 50%	POOR
50 - 75%	FAIR
75 - 90%	GOOD
90 - 100%	EXCELLENT

IN-SITU, LAB & FIELD TEST DESIGNATIONS

- AL ATTERBERG LIMITS
- CA CHEMICAL ANALYSIS
- CN CONSOLIDATION
- CU CONSOLIDATED UNDRAINED TRIAXIAL
- DS DIRECT SHEAR
- MD MAX. DRY DENSITY
- PP POCKET PENETROMETER
- SA SIEVE ANALYSIS
- TV TORVANE
- UC UNCONFINED COMPRESSION
- UU UNCONSOLIDATED UNDRAINED TRIAXIAL
- VS VANE SHEAR

Kenneth Sorensen DESIGN OVERSIGHT	DRAWN BY A. Sanchez	G. Zhang FIELD INVESTIGATION BY:
SIGN OFF DATE	CHECKED BY E. Ortakci	DATE: 01/15/07

BRIDGE NO. 19E009	PROJECT ENGINEER
KILOMETER POST 4.7	

PREPARED FOR THE STATE OF CALIFORNIA DEPARTMENT OF TRANSPORTATION		RETAINING WALL - 49E	
LOG OF TEST BORINGS 1 OF 4		REVISION DATES (PRELIMINARY STAGE ONLY)	



DIST	COUNTY	ROUTE	KILOMETER POST TOTAL PROJECT	SHEET No	TOTAL SHEETS
03	Pla	80	4.5/8.3	523	539

9/12/08  
 REGISTERED CIVIL ENGINEER  
 11-17-08  
 PLANS APPROVAL DATE  
 The State of California or its officers or agents shall not be responsible for the accuracy or completeness of electronic copies of this plan sheet.  
 KLEINFELDER INC.  
 3077 FITE CIR.  
 SACRAMENTO, CA 95827

Notes:

- 51 mm samples were taken using a California split-barrel sampler with an inside diameter (I.D.) of 51 mm and an outside diameter (O.D.) of 64 mm.
- A safety semi-automatic hammer (63.5 kg) with a 760 mm drop was used to advance the sampler.
- Blowcounts noted for boring are field blowcounts and have not been corrected.
- 35 mm samples were taken using a SPT split-barrel sampler with an inside diameter (I.D.) of 35 mm and an outside diameter (O.D.) of 51 mm.
- 63.5 mm core samples were taken using an HQ core sampler with a 63.5 mm inside diameter (I.D.) and 94 mm outside diameter (O.D.) core barrel.
- Blowcounts 50/125 means 50 blows per 125 mm penetration.
- The holes are backfilled immediately after completion. Borings were accomplished with rotary wash methods and utilizing water as the drill fluid. During the investigation, groundwater measurements were not attempted in the boreholes.
- The descriptions and classifications of soil, including consistency and relative density descriptions, used by the field personnel for the exploration bore holes on "Soil and Rock Logging Classification Manual (Field Guide)", Engineering Service Center, Office of Structural Foundations, August 1996.

LEGEND OF BORING OPERATIONS

57 mm CONE PENETRATION BORING  
 100 mm SAMPLE BORING (WET)  
 100 mm ROTARY SAMPLE BORING (WET)  
 100 mm AUGER BORING (WET)  
 TEST PIT  
 DIAMOND CORE BORING  
 JET BORING  
 ELECTRONIC CONE PENETROMETER


LEGEND OF EARTH MATERIALS

CLAYEY SILT	PEAT and/or ORGANIC MATTER
FILL MATERIAL	COBBLE
GRAVEL	INDURATED ROCK
SAND	SEDIMENTARY ROCK
SILT	CLAYEY SILT or SILTY SAND
CLAY	SANDY SILT or SILTY CLAY
SANDY CLAY or CLAYEY SAND	
METAMORPHIC	

CONSISTENCY CLASSIFICATION FOR SOILS


SPT	Penetration (mm)	Consistency
0-4	Very Loose	Very Soft
5-10	Loose	Soft
11-20	Medium Dense	Firm
31-50	Dense	Stiff
50	Very Dense	Very Stiff
		Hard

NOTE: Classification of earth material as shown on this sheet is based upon field inspection and is not to be construed to imply mechanical analysis.

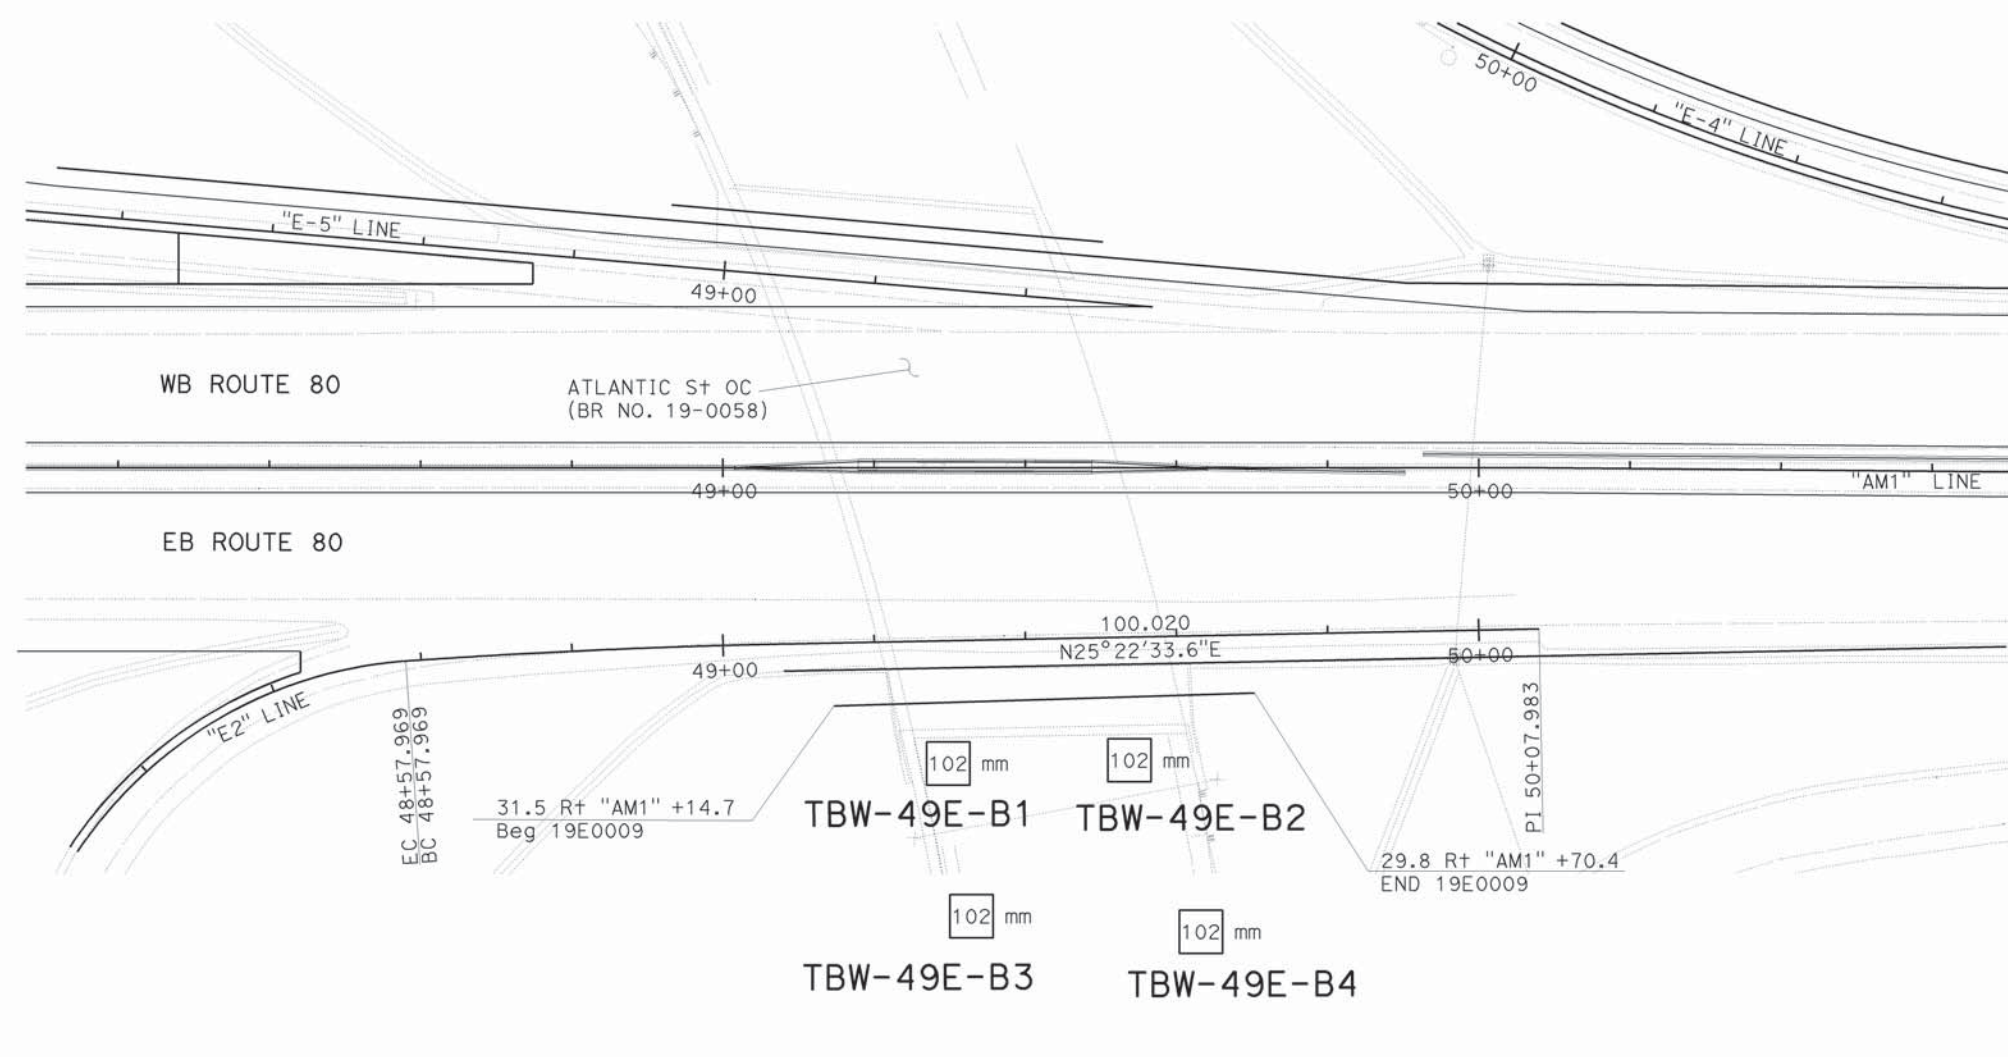

PLAN  
1:500


Kenneth Sorensen DESIGN OVERSIGHT	DRAWN BY A. Sanchez	G. Zhang FIELD INVESTIGATION BY:	BRIDGE NO. 19E0009	RETAINING WALL - 49E
SIGN OFF DATE	CHECKED BY E. Ortakci	DATE: 01/15/07	PROJECT ENGINEER	LOG OF TEST BORINGS 2 OF 4
PREPARED FOR THE STATE OF CALIFORNIA DEPARTMENT OF TRANSPORTATION			KILOMETER POST 4.7	

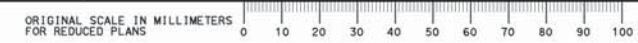



DIST	COUNTY	ROUTE	KILOMETER POST TOTAL PROJECT	SHEET No	TOTAL SHEETS
03	Pla	80	4.5/8.3	524	539
			9/12/08		
REGISTERED CIVIL ENGINEER					
11-17-08					
PLANS APPROVAL DATE					
The State of California or its officers or agents shall not be responsible for the accuracy or completeness of electronic copies of this plan sheet.					
KLEINFELDER INC. 3077 FITE CIR. SACRAMENTO, CA 95827					

FOR PLAN VIEW AND ADDITIONAL NOTES, SEE "LOG OF TEST BORINGS" SHEET 1 OF 3

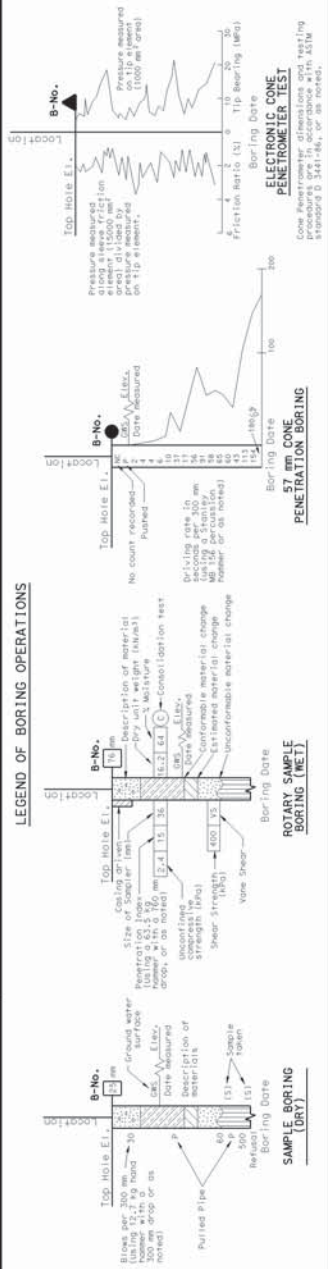


**CONSISTENCY CLASSIFICATION FOR SOILS**

According to the Standard Penetration Test

SPT N-value (blows/30cm)	Consistency
0-4	Very Loose
5-10	Loose
11-20	Medium Dense
21-30	Dense
31-50	Very Dense
50	Hard

NOTE: Classification of earth material as shown on this sheet is based upon field inspection and is not to be construed to imply mechanical analysis.

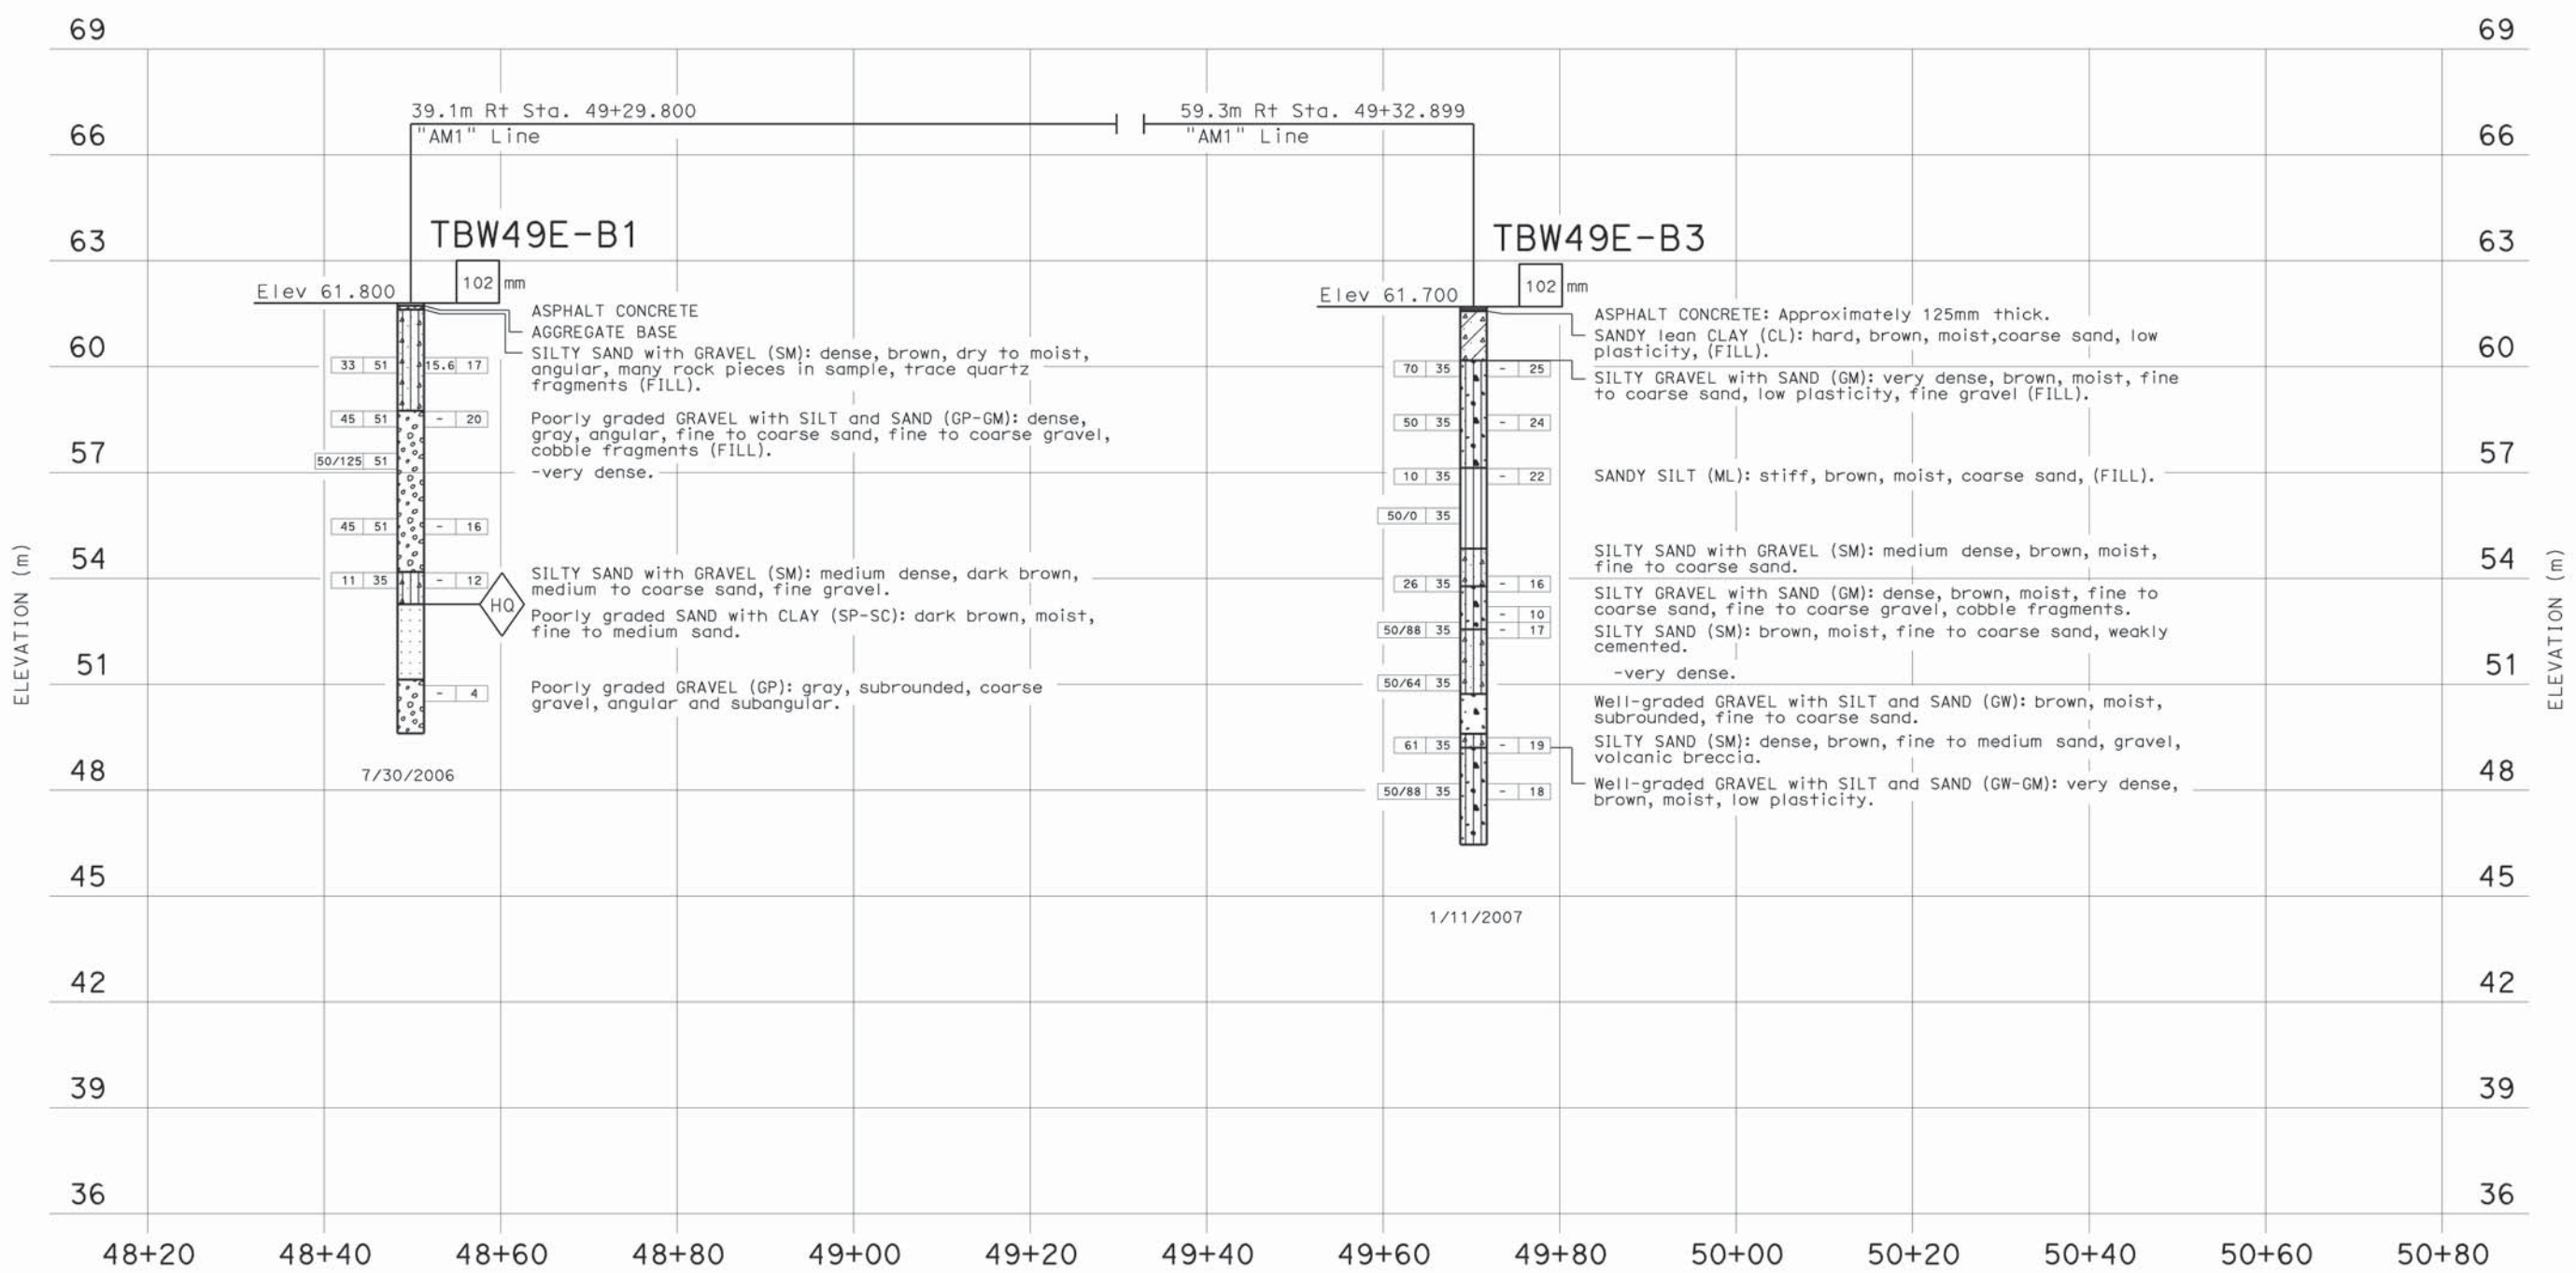

**PROFILE**  
HOR. 1:400  
VER. 1:100

Kenneth Sorensen DESIGN OVERSIGHT	DRAWN BY A. Sanchez	G. Zhang FIELD INVESTIGATION BY:	BRIDGE NO. 19E0009	RETAINING WALL - 49E	
SIGN OFF DATE	CHECKED BY E. Ortakci	DATE: 01/15/07	PROJECT ENGINEER	LOG OF TEST BORINGS 3 OF 4	
PREPARED FOR THE STATE OF CALIFORNIA DEPARTMENT OF TRANSPORTATION			KILOMETER POST 4.7		






DIST	COUNTY	ROUTE	KILOMETER POST TOTAL PROJECT	SHEET No	TOTAL SHEETS
03	Pla	80	4.5/8.3	525	539

FOR PLAN VIEW AND ADDITIONAL NOTES, SEE "LOG OF TEST BORINGS" SHEET 1 OF 3

9/12/08  
 REGISTERED CIVIL ENGINEER  
 11-17-08  
 PLANS APPROVAL DATE  
 The State of California or its officers or agents shall not be responsible for the accuracy or completeness of electronic copies of this plan sheet.  
 KLEINFELDER INC.  
 3077 FITE CIR.  
 SACRAMENTO, CA 95827

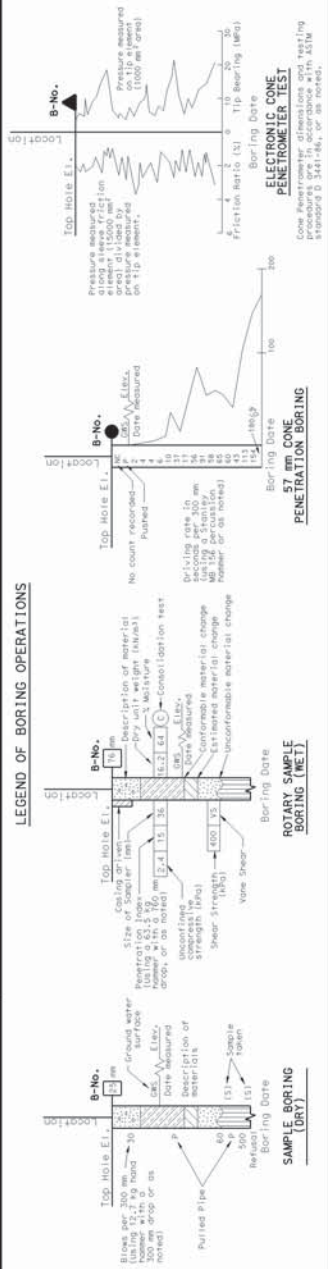

- 57 mm CONE PENETRATION
- SAMPLE BORING (DRY)
- ROTARY SAMPLE BORING
- ASPER BORING
- TEST PIT
- DIAMOND CORE BORING
- JET BORING
- ELECTRONIC CONE PENETROMETER


LEGEND OF EARTH MATERIALS

GRAVEL	CLAYEY SILT
SAND	PEAT and/or ORGANIC MATTER
SILT	FILL MATERIAL
CLAY	COBBLE
SANDY CLAY or CLAYEY SAND	IGNEOUS ROCK
SANDY SILT or SILTY SAND	SEDIMENTARY ROCK
SILTY CLAY	METAMORPHIC

CONSISTENCY CLASSIFICATION FOR SOILS

SPT	Flow Value	Consistency
0-4	Very Loose	Very Soft
5-10	Loose	Soft
11-20	Medium Dense	Firm
31-50	Dense	Stiff
51	Very Dense	Very Stiff
71		Hard

NOTE: Classification of earth material as shown on this sheet is based upon field inspection and is not to be construed to imply mechanical analysis.

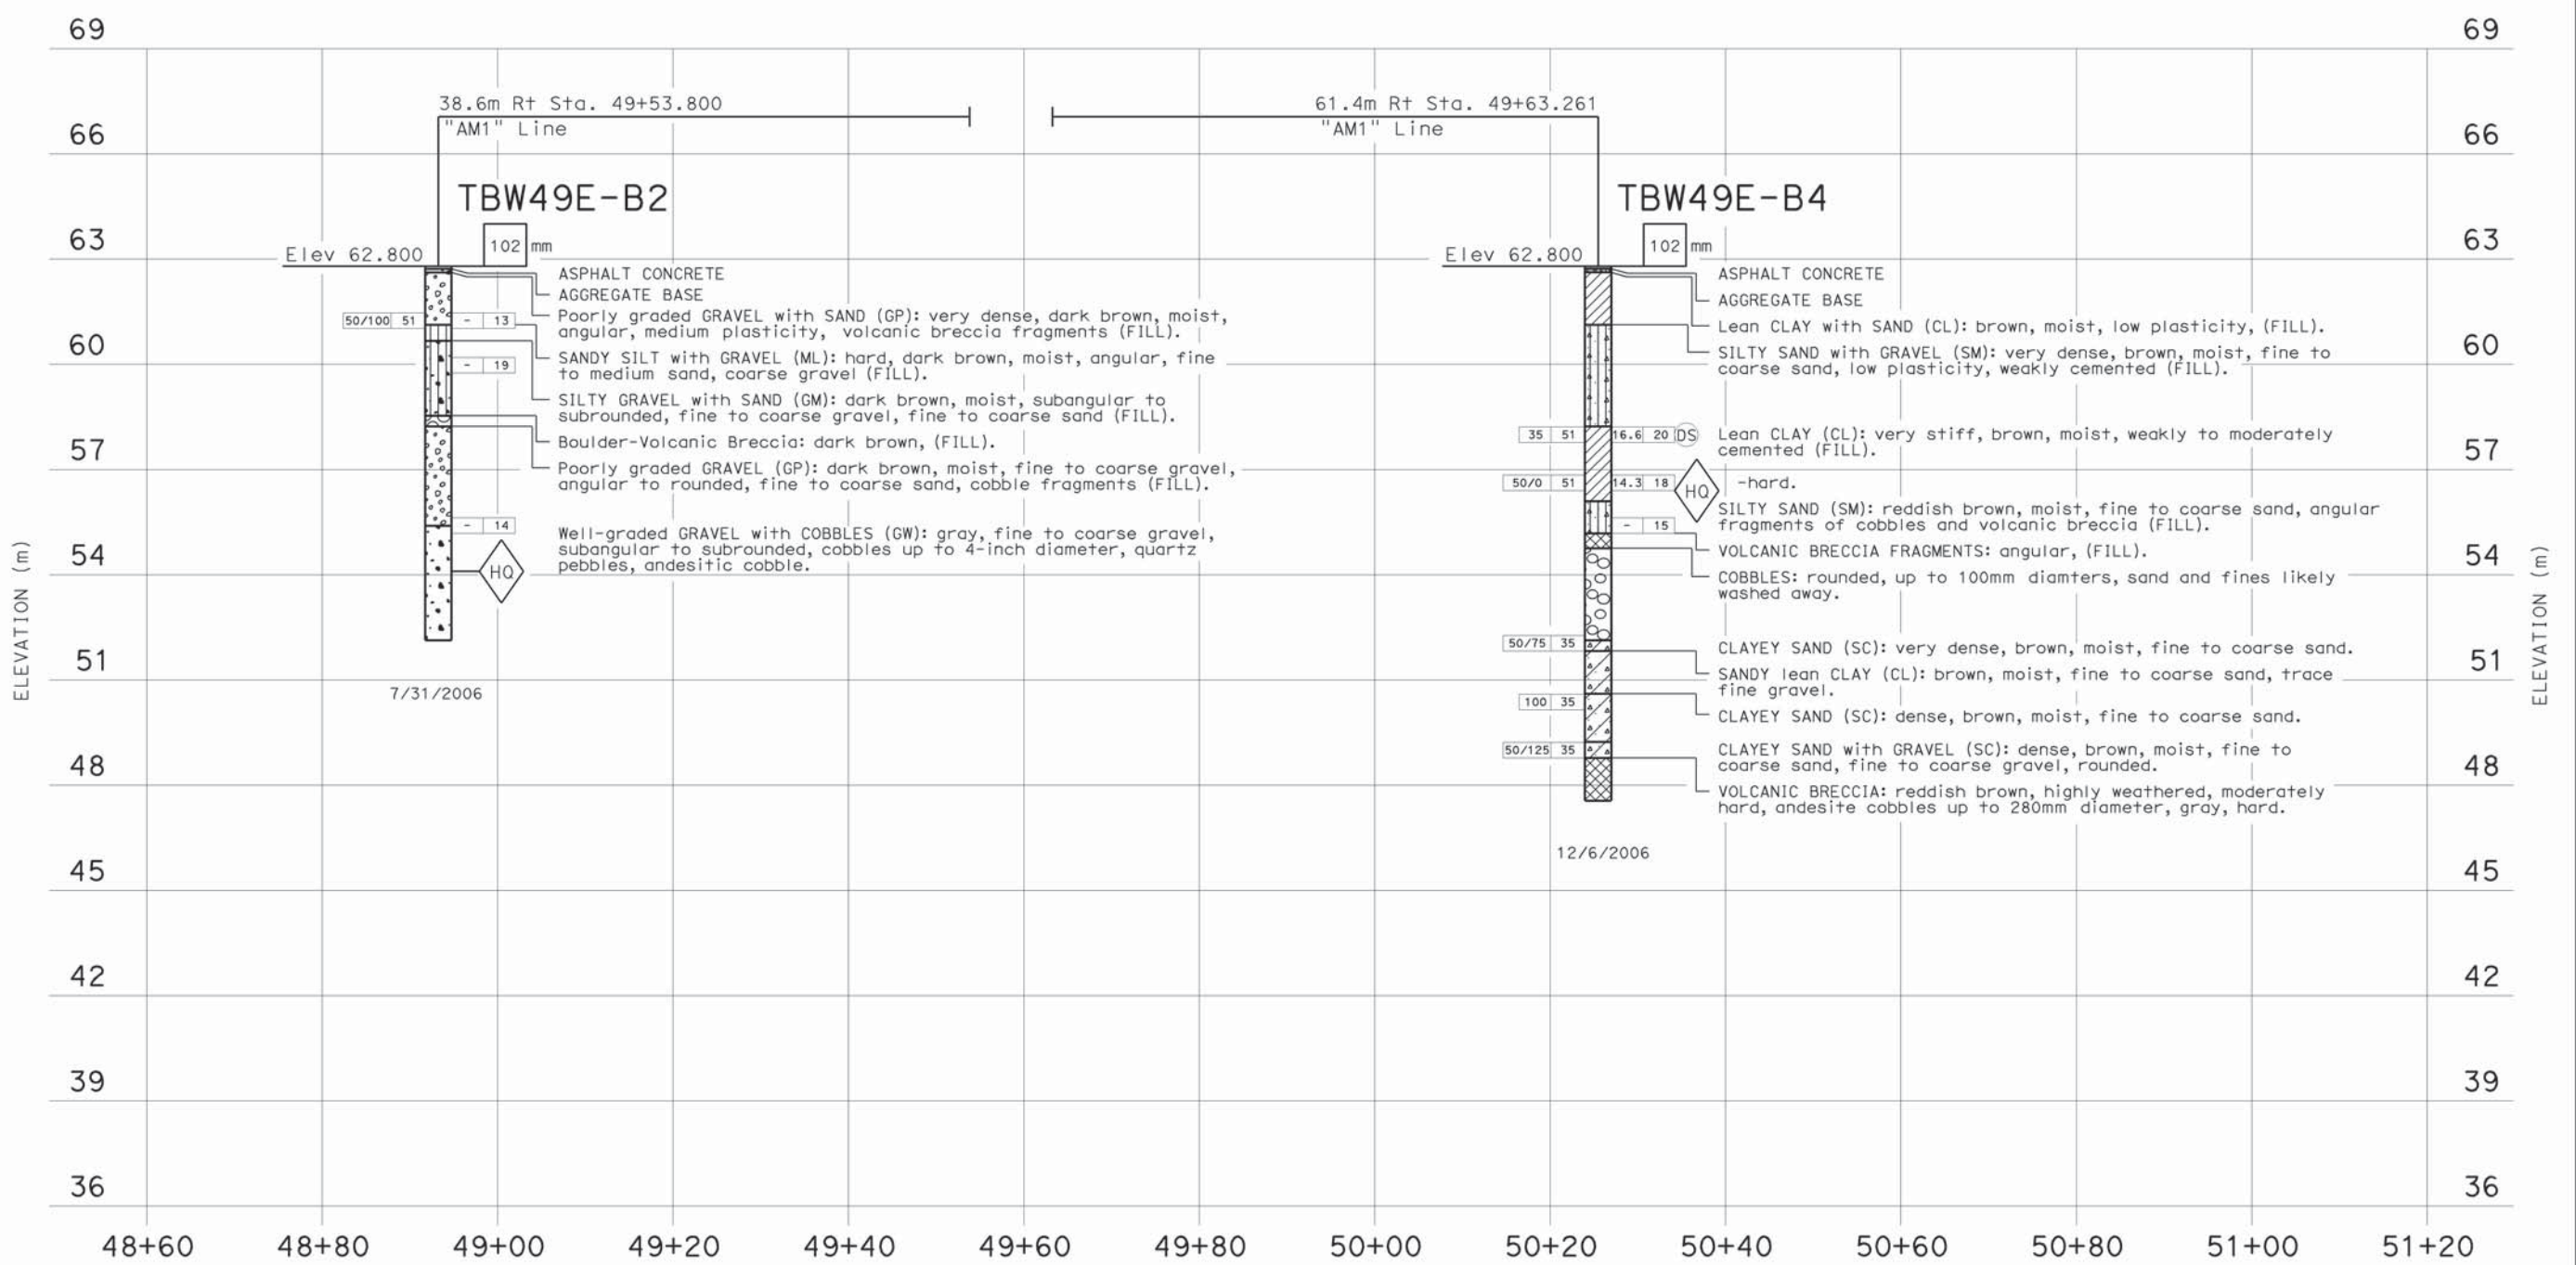

PROFILE  
 HOR. 1:400  
 VER. 1:100

Kenneth Sorensen DESIGN OVERSIGHT	DRAWN BY A. Sanchez	G. Zhang FIELD INVESTIGATION BY:	BRIDGE NO. 19E0009	RETAINING WALL - 49E
SIGN OFF DATE	CHECKED BY E. Ortakci	DATE: 01/15/07	PROJECT ENGINEER	LOG OF TEST BORINGS 4 OF 4
PREPARED FOR THE STATE OF CALIFORNIA DEPARTMENT OF TRANSPORTATION			KILOMETER POST 4.7	



CU 03262  
EA 367831

DISREGARD PRINTS BEARING EARLIER REVISION DATES	REVISION DATES (PRELIMINARY STAGE ONLY)	SHEET 14 OF 14
---	---	----------------





DIST	COUNTY	ROUTE	KILOMETER POST TOTAL PROJECT	SHEET No	TOTAL SHEETS
03	Pla	80	4.5/8.3	536	539

9/12/08  
 REGISTERED CIVIL ENGINEER  
 11-17-08  
 PLANS APPROVAL DATE  
 The State of California or its officers or agents shall not be responsible for the accuracy or completeness of electronic copies of this plan sheet.



KLEINFELDER INC.  
 3077 FITE CIR.  
 SACRAMENTO, CA 95827

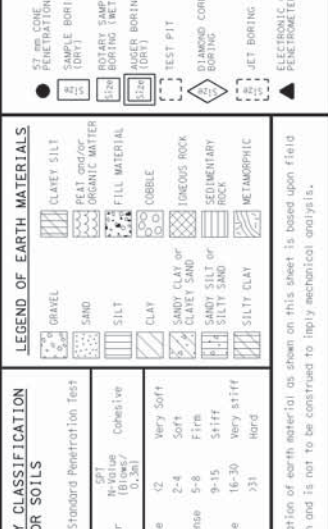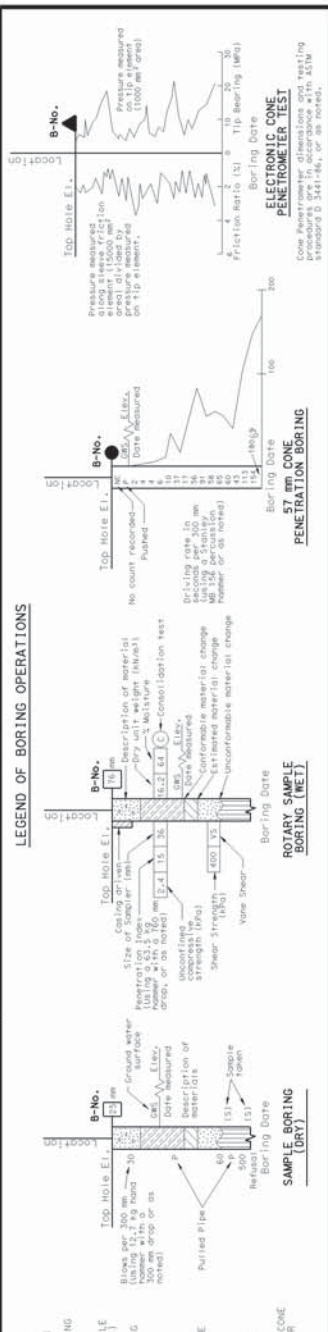

CONSISTENCY CLASSIFICATION FOR SOILS

SPT	Relative Density (D <sub>r</sub> )	Consistency
0-4	Very Loose	Very Soft
5-10	Loose	Soft
11-20	Medium Dense	Firm
21-30	Dense	Stiff
31-50	Very Dense	Very Stiff
50		Hard


Descriptors		WEATHERING DESCRIPTORS				Diagnostic features	
Alphanumeric descriptor	Descriptive term	Chemical weathering-Discoloration and/or oxidation		Mechanical weathering-Grain boundary conditions (disaggregation) primarily for granitics and some coarse-grained sediments	Texture and solutioning		General characteristics (strength, excavation, etc.) <sup>§</sup>
		Body of rock	Fracture surfaces		Texture	Solutioning	
W1	Fresh	No discoloration, not oxidized.	No discoloration or oxidation.	No separation, intact (tight).	No change.	No solutioning.	Hammer rings when crystalline rocks are struck. Almost always rock excavation except for naturally weak or weakly cemented rocks such as siltstones or shales.
W2	Slightly weathered to fresh <sup>o</sup>						
W3	Slightly weathered	Discoloration or oxidation is limited to surface of, or short distance from, fractures; some feldspar crystals are dull.	Minor to complete discoloration or oxidation of most surfaces.	No visible separation, intact (tight).	Preserved.	Minor leaching of some soluble minerals may be noted.	Hammer rings when crystalline rocks are struck. Body of rock not weakened. With few exceptions, such as siltstones or shales, classified as rock excavation.
W4	Moderately to slightly weathered <sup>o</sup>						
W5	Moderately weathered	Discoloration or oxidation extends from fractures, usually throughout; Fe-Mg minerals are "rusty," feldspar crystals are "cloudy."	All fracture surfaces are discolored or oxidized.	Partial separation of boundaries visible.	Generally preserved.	Soluble minerals may be mostly leached.	Hammer does not ring when rock is struck. Body of rock is slightly weakened. Depending on fracturing, usually is rock excavation except in naturally weak rocks such as siltstones or shales.
W6	Intensely to moderately weathered <sup>o</sup>						
W7	Intensely weathered	Discoloration or oxidation throughout; all feldspars and Fe-Mg minerals are altered to clay to some extent; or chemical alteration produces in-situ disaggregation, see grain boundary conditions.	All fracture surfaces are discolored or oxidized, surfaces friable.	Partial separation, rock is friable; in semi-arid conditions granitics are disaggregated.	Texture altered by chemical disintegration (hydration, argillation).	Leaching of soluble minerals may be complete.	Dull sound when struck with hammer, usually can be broken with moderate to heavy manual pressure or by light hammer blow without reference to planes of weakness such as incipient or hairline fractures, or veinlets. Rock is significantly weakened. Usually common excavation.
W8	Very intensely weathered						
W9	Decomposed	Discolored or oxidized throughout, but resistant minerals such as quartz may be unaltered; all feldspars and Fe-Mg minerals are completely altered to clay.		Complete separation of grain boundaries (disaggregated).	Resembles a soil, partial or complete remnant rock structure may be preserved; leaching of soluble minerals usually complete.		Can be granulated by hand, always common excavation. Resistant minerals such as quartz may be present as "stringers" or "dikes."

Note: This chart and its horizontal categories are more readily applied to rocks with feldspars and mafic minerals. Weathering in various sedimentary rocks, particularly limestones and poorly indurated sediments, will not always fit the categories established. This chart and weathering categories may have to be modified for particular site conditions or alteration such as hydrothermal effects; however, the basic framework and similar descriptors are to be used.

<sup>o</sup> Combination descriptors are permissible where equal distribution of both weathering characteristics are present over significant intervals or where characteristics present are "in between" the diagnostic feature. However, dual descriptors should not be used where significant, identifiable zones can be delineated. When given as a range, only two adjacent terms may be combined. "Decomposed to slightly weathered," or "moderately weathered to fresh" are not acceptable.

<sup>1</sup> Does not include diffractonal weathering along shears or faults and their associated features. For example, a shear zone that carried weathering to great depths into a fresh rock mass would not require the rock mass to be classified as weathered.

<sup>§</sup> These are generalizations and should not be used as diagnostic features for weathering or excavation classification. These characteristics vary to a large extent based on naturally weak materials or cementation and type of excavation.

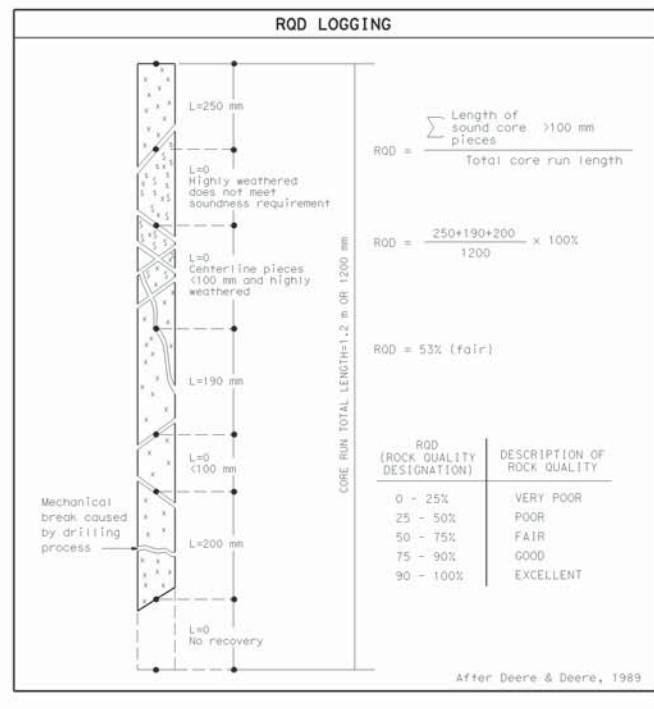

BEDDING, FOLIATION, OR FLOW TEXTURE DESCRIPTORS	
Descriptors	Thickness / Spacing
Massive	Greater than 3 m
Very thickly (bedded, foliated, or banded)	1 to 3 m
Thickly	300 mm to 1 m
Moderately	100 to 300 mm
Thinly	30 to 100 mm
Very thinly	10 to 30 mm
Laminated (intensely foliated or banded)	Less than 10 mm

ROD (ROCK QUALITY DESIGNATION)	DESCRIPTION OF ROCK QUALITY
0 - 25%	VERY POOR
25 - 50%	POOR
50 - 75%	FAIR
75 - 90%	GOOD
90 - 100%	EXCELLENT

FRACTURE DENSITY	
FRACTURE DENSITY- Based on the spacing of all natural fractures in an exposure or core recovery lengths in boreholes; excludes mechanical breaks, shears, and shear zones; however, shear-distributed zones (fracturing outside the shear) are included. Descriptors for fracture density apply to all rock exposures such as tunnel walls, doker trenches, outcrops, or foundation cut slopes and inverts, as well as boreholes. Descriptive criteria presented below are based on borehole cores where lengths are measured along the core axis, for other exposures the criteria is distance measured between fractures (size of blocks).	
UNFRACTURED (FD0): No fractures.	
VERY SLIGHTLY FRACTURED (FD1): Core recovered mostly in lengths greater than 1 m.	
SLIGHTLY TO VERY SLIGHTLY FRACTURED (FD2)*	
SLIGHTLY FRACTURED (FD3): Core recovered mostly in lengths from 300 to 1000 mm, with few scattered lengths less than 300 mm or greater than 1000 mm.	
MODERATELY TO SLIGHTLY FRACTURED (FD4)*	
MODERATELY FRACTURED (FD5): Core recovered mostly in 100 to 300 mm lengths with most lengths about 200 mm.	
INTENSELY TO MODERATELY FRACTURED (FD6)*	
INTENSELY FRACTURED (FD7): Lengths average from 30 to 100 mm with scattered fragmented intervals. Core recovered mostly in lengths less than 100 mm.	
VERY INTENSELY TO INTENSELY FRACTURED (FD8)*	
VERY INTENSELY FRACTURED (FD9): Core recovered mostly as chips and fragments with a few scattered short core lengths.	
* Combinations of fracture densities (e.g. very intensely to intensely fractured, or moderately to slightly fractured) are used where equal distribution of both fracture density characteristics are present over a significant interval or exposure, or where characteristics are "in between" the descriptor definitions.	

ROCK HARDNESS/STRENGTH DESCRIPTORS		
Alphanumeric Descriptor	Descriptor	Criteria
H1	Extremely hard	Core, fragment, or exposure cannot be scratched with knife or sharp pick; can only be chipped with repeated heavy hammer blows.
H2	Very hard	Cannot be scratched with knife or sharp pick. Core or fragment breaks with repeated heavy hammer blows.
H3	Hard	Can be scratched with knife or sharp pick with difficulty (heavy pressure). Heavy hammer blow required to break specimen.
H4	Moderately hard	Can be scratched with knife or sharp pick with moderate pressure. Core or fragment breaks with moderate hammer blow.
H5	Moderately soft	Can be grooved 2 mm deep by knife or sharp pick with moderate or heavy pressure. Core or fragment breaks with light hammer blow or heavy manual pressure.
H6	Soft	Can be grooved or gouged easily by knife or sharp pick with light pressure, can be scratched with fingernail. Breaks with light to moderate manual pressure.
H7	Very soft	Can be readily indented, grooved or gouged with fingernail, or carved with a knife. Breaks with light manual pressure.
Any bedrock unit softer than H7, very soft, is to be described using ASTM D-2488 consistency descriptors.		
Note: Although "sharp pick" is included in these definitions, descriptions of ability to be scratched, grooved or gouged by a knife is the preferred criteria.		
Modified from United States Bureau of Reclamation, Engineering Geology Field manual.		

- IN-SITU, LAB & FIELD TEST DESIGNATIONS
- AL ATTERBERG LIMITS
  - CA CHEMICAL ANALYSIS
  - CN CONSOLIDATION
  - CU CONSOLIDATED UNDRAINED TRIAXIAL
  - DS DIRECT SHEAR
  - MD MAX. DRY DENSITY
  - PP POCKET PENETROMETER
  - SA SIEVE ANALYSIS
  - TV TORVANE
  - UC UNCONFINED COMPRESSION
  - UU UNCONSOLIDATED UNDRAINED TRIAXIAL
  - VS VANE SHEAR

Kenneth Sorensen  
 DESIGN OVERSIGHT  
 DRAWN BY: A. Sanchez  
 CHECKED BY: E. Ortakci  
 G. Zhang  
 FIELD INVESTIGATION BY:  
 DATE: 01/15/07

PREPARED FOR THE  
 STATE OF CALIFORNIA  
 DEPARTMENT OF TRANSPORTATION  
 BRIDGE NO. 19E0010  
 KILOMETER POST 5.9  
 PROJECT ENGINEER

RETAINING WALL - 58E  
 LOG OF TEST BORINGS 1 OF 4  
 REVISION DATES (PRELIMINARY STAGE ONLY)  
 SHEET 11 OF 14



DIST	COUNTY	ROUTE	KILOMETER TOTAL PROJECT	POST TOTAL	SHEET No	TOTAL SHEETS
03	Pla	80	4.5/8.3		537	539

9/12/08  
 REGISTERED CIVIL ENGINEER  
 11-17-08  
 PLANS APPROVAL DATE  
 The State of California or its officers or agents shall not be responsible for the accuracy or completeness of electronic copies of this plan sheet.



KLEINFELDER INC.  
 3077 FITE CIR.  
 SACRAMENTO, CA 95827

**LEGEND OF BORING OPERATIONS**

**ELECTRONIC CONE PENETROMETER TEST**  
 Cone Penetrometer: dimensions and testing standards as shown on drawings.

**57 mm CONE PENETRATION BORING**  
 No. count recorded  
 No. count corrected  
 Friction rate in seconds per 300 mm  
 Friction rate in percent (100 mm)

**ROTARY SAMPLE BORING (WET)**  
 Description of material  
 Size of sample  
 Location of sample  
 Blow counts  
 Blow count corrected  
 Friction rate in seconds per 300 mm  
 Friction rate in percent (100 mm)

**SAMPLE BORING (DRY)**  
 Description of material  
 Size of sample  
 Location of sample  
 Blow counts  
 Blow count corrected  
 Friction rate in seconds per 300 mm  
 Friction rate in percent (100 mm)

**LEGEND OF EARTH MATERIALS**

CLAYEY SILT  
 FEAT and/or ORGANIC MATTER  
 FILL MATERIAL  
 COBBLE  
 SAND  
 SILT  
 CLAY  
 SANDY CLAY or CLAYEY SAND  
 SANDY SILT or SILTY SAND  
 SILTY CLAY  
 DIOGENIC ROCK  
 SEDIMENTARY ROCK  
 METAMORPHIC


**CONSISTENCY CLASSIFICATION FOR SOILS**

According to the Standard Penetration Test

SPT N-value (blows/30cm)

0-4 Very Loose  
 5-10 Loose  
 11-30 Medium Dense  
 31-50 Dense  
 50 Very Dense

CU  
 2-4 Soft  
 5-8 Firm  
 9-15 Stiff  
 16-30 Very Stiff  
 >30 Hard

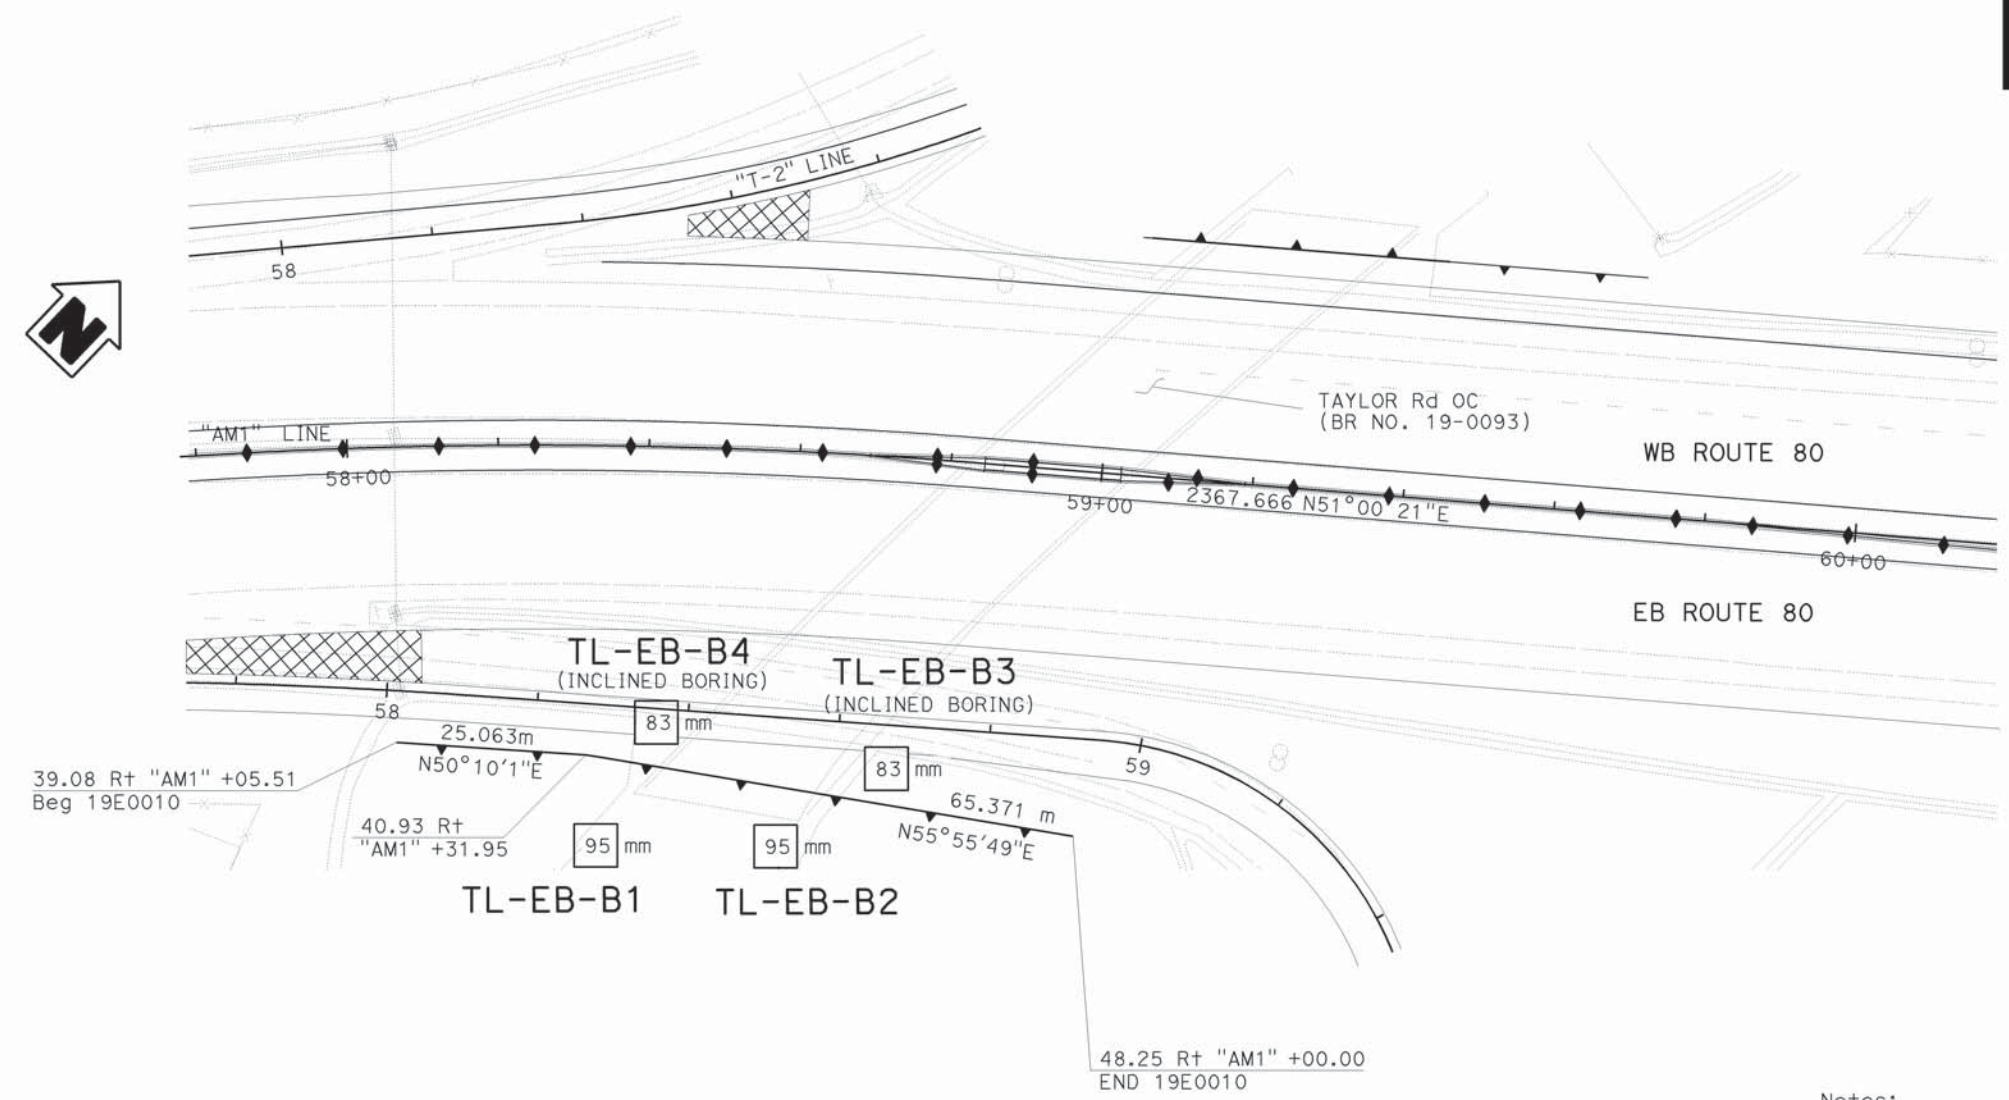

**PLAN**  
 1:500

**BENCHMARKS**

STATION	OFFSET	N	E	ELEV	DESCRIPTION
STA 58+34.478 "AM1" (CL Rte 80)	23.428m Lt	622211.977	2064606.488	60.182m	PD-19-008-03.62 Fnd: #6 Rebar W/AL DOT CAP
STA 59+84.431 "AM1" (CL Rte 80)	33.533m Lt	622322.757	2064724.573	62.555m	PD-19-080-03.62 Fnd: #6 Rebar W/AL DOT CAP

**SURVEY CONTROL**

1. Coordinates bearing and distances are based on the California coordinate system of Nad 1983 HPGN, zone 6. (EPOCH 1991.35). Elevations are based on NGVD 29.

**Notes:**

- 51 mm samples were taken using a California split-barrel sampler with an inside diameter (I.D.) of 51 mm and an outside diameter (O.D.) of 64 mm.
- A safety semi-automatic hammer (63.5 kg) with a 760 mm drop was used to advance the sampler.
- Blowcounts noted for boring are field blowcounts and have not been corrected.
- 35 mm samples were taken using a SPT split-barrel sampler with an inside diameter (I.D.) of 35 mm and an outside diameter (O.D.) of 51 mm.
- 63.5 mm core samples were taken using an H0 core sampler with a 63.5 mm inside diameter (I.D.) and 94 mm outside diameter (O.D.) core barrel.
- Blowcounts 50/125 means 50 blows per 125 mm penetration.
- The holes are backfilled immediately after completion. Vertical borings were accomplished with rotary wash methods and utilizing water as the drill fluid. During the investigation, groundwater measurements were not attempted in the boreholes.
- The descriptions and classifications of soil, including consistency and relative density descriptions, used by the field personnel for the exploration bore holes on "Soil and Rock Logging Classification Manual (Field Guide)", Engineering Service Center, Office of Structural Foundations, August 1996.

**Kenneth Sorensen**  
 DESIGN OVERSIGHT

**A. Sanchez**  
 DRAWN BY

**E. Ortakci**  
 CHECKED BY

**G. Zhang**  
 FIELD INVESTIGATION BY:

DATE: 01/15/07

**PREPARED FOR THE STATE OF CALIFORNIA**  
 DEPARTMENT OF TRANSPORTATION

PROJECT ENGINEER

BRIDGE NO.  
 19E0010

KILOMETER POST  
 5.9

**RETAINING WALL - 58E**

**LOG OF TEST BORINGS 2 OF 4**


USERNAME => TPT1000g DATE PLOTTED => 21-NOV-2008 TIME PLOTTED => 15:53



DIST	COUNTY	ROUTE	KILOMETER POST TOTAL PROJECT	SHEET No	TOTAL SHEETS
03	Pla	80	4.5/8.3	538	539

FOR PLAN VIEW AND ADDITIONAL NOTES, SEE "LOG OF TEST BORINGS" SHEET 1 OF 3


9/12/08  
 REGISTERED CIVIL ENGINEER  
 11-17-08  
 PLANS APPROVAL DATE  
 The State of California or its officers or agents shall not be responsible for the accuracy or completeness of electronic copies of this plan sheet.  
 KLEINFELDER INC.  
 3077 FITE CIR.  
 SACRAMENTO, CA 95827

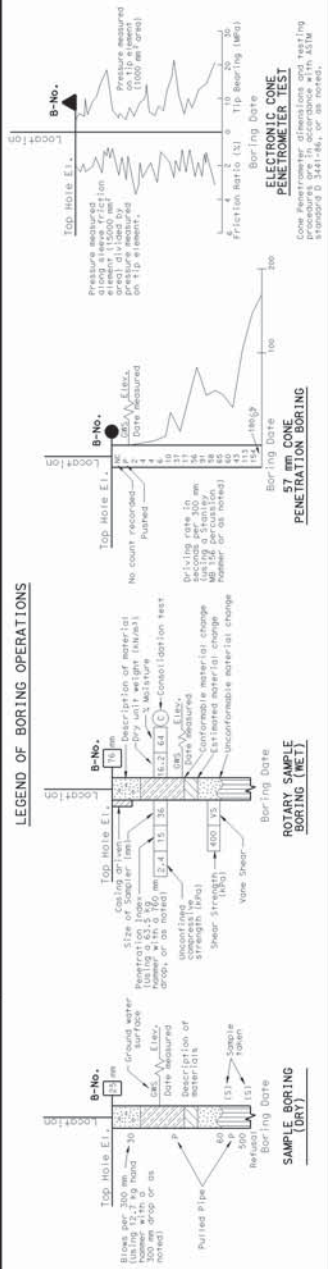

**CONSISTENCY CLASSIFICATION FOR SOILS**


SPT	Flow Value	Consistency	Classification
0-4	Very Loose	Very Soft	Very Soft
5-10	Loose	Soft	Soft
11-20	Medium Dense	Firm	Firm
21-30	Dense	Stiff	Stiff
31-50	Very Dense	Very Stiff	Very Stiff
50		Hard	Hard

NOTE: Classification of earth material as shown on this sheet is based upon field inspection and is not to be construed to imply mechanical analysis.

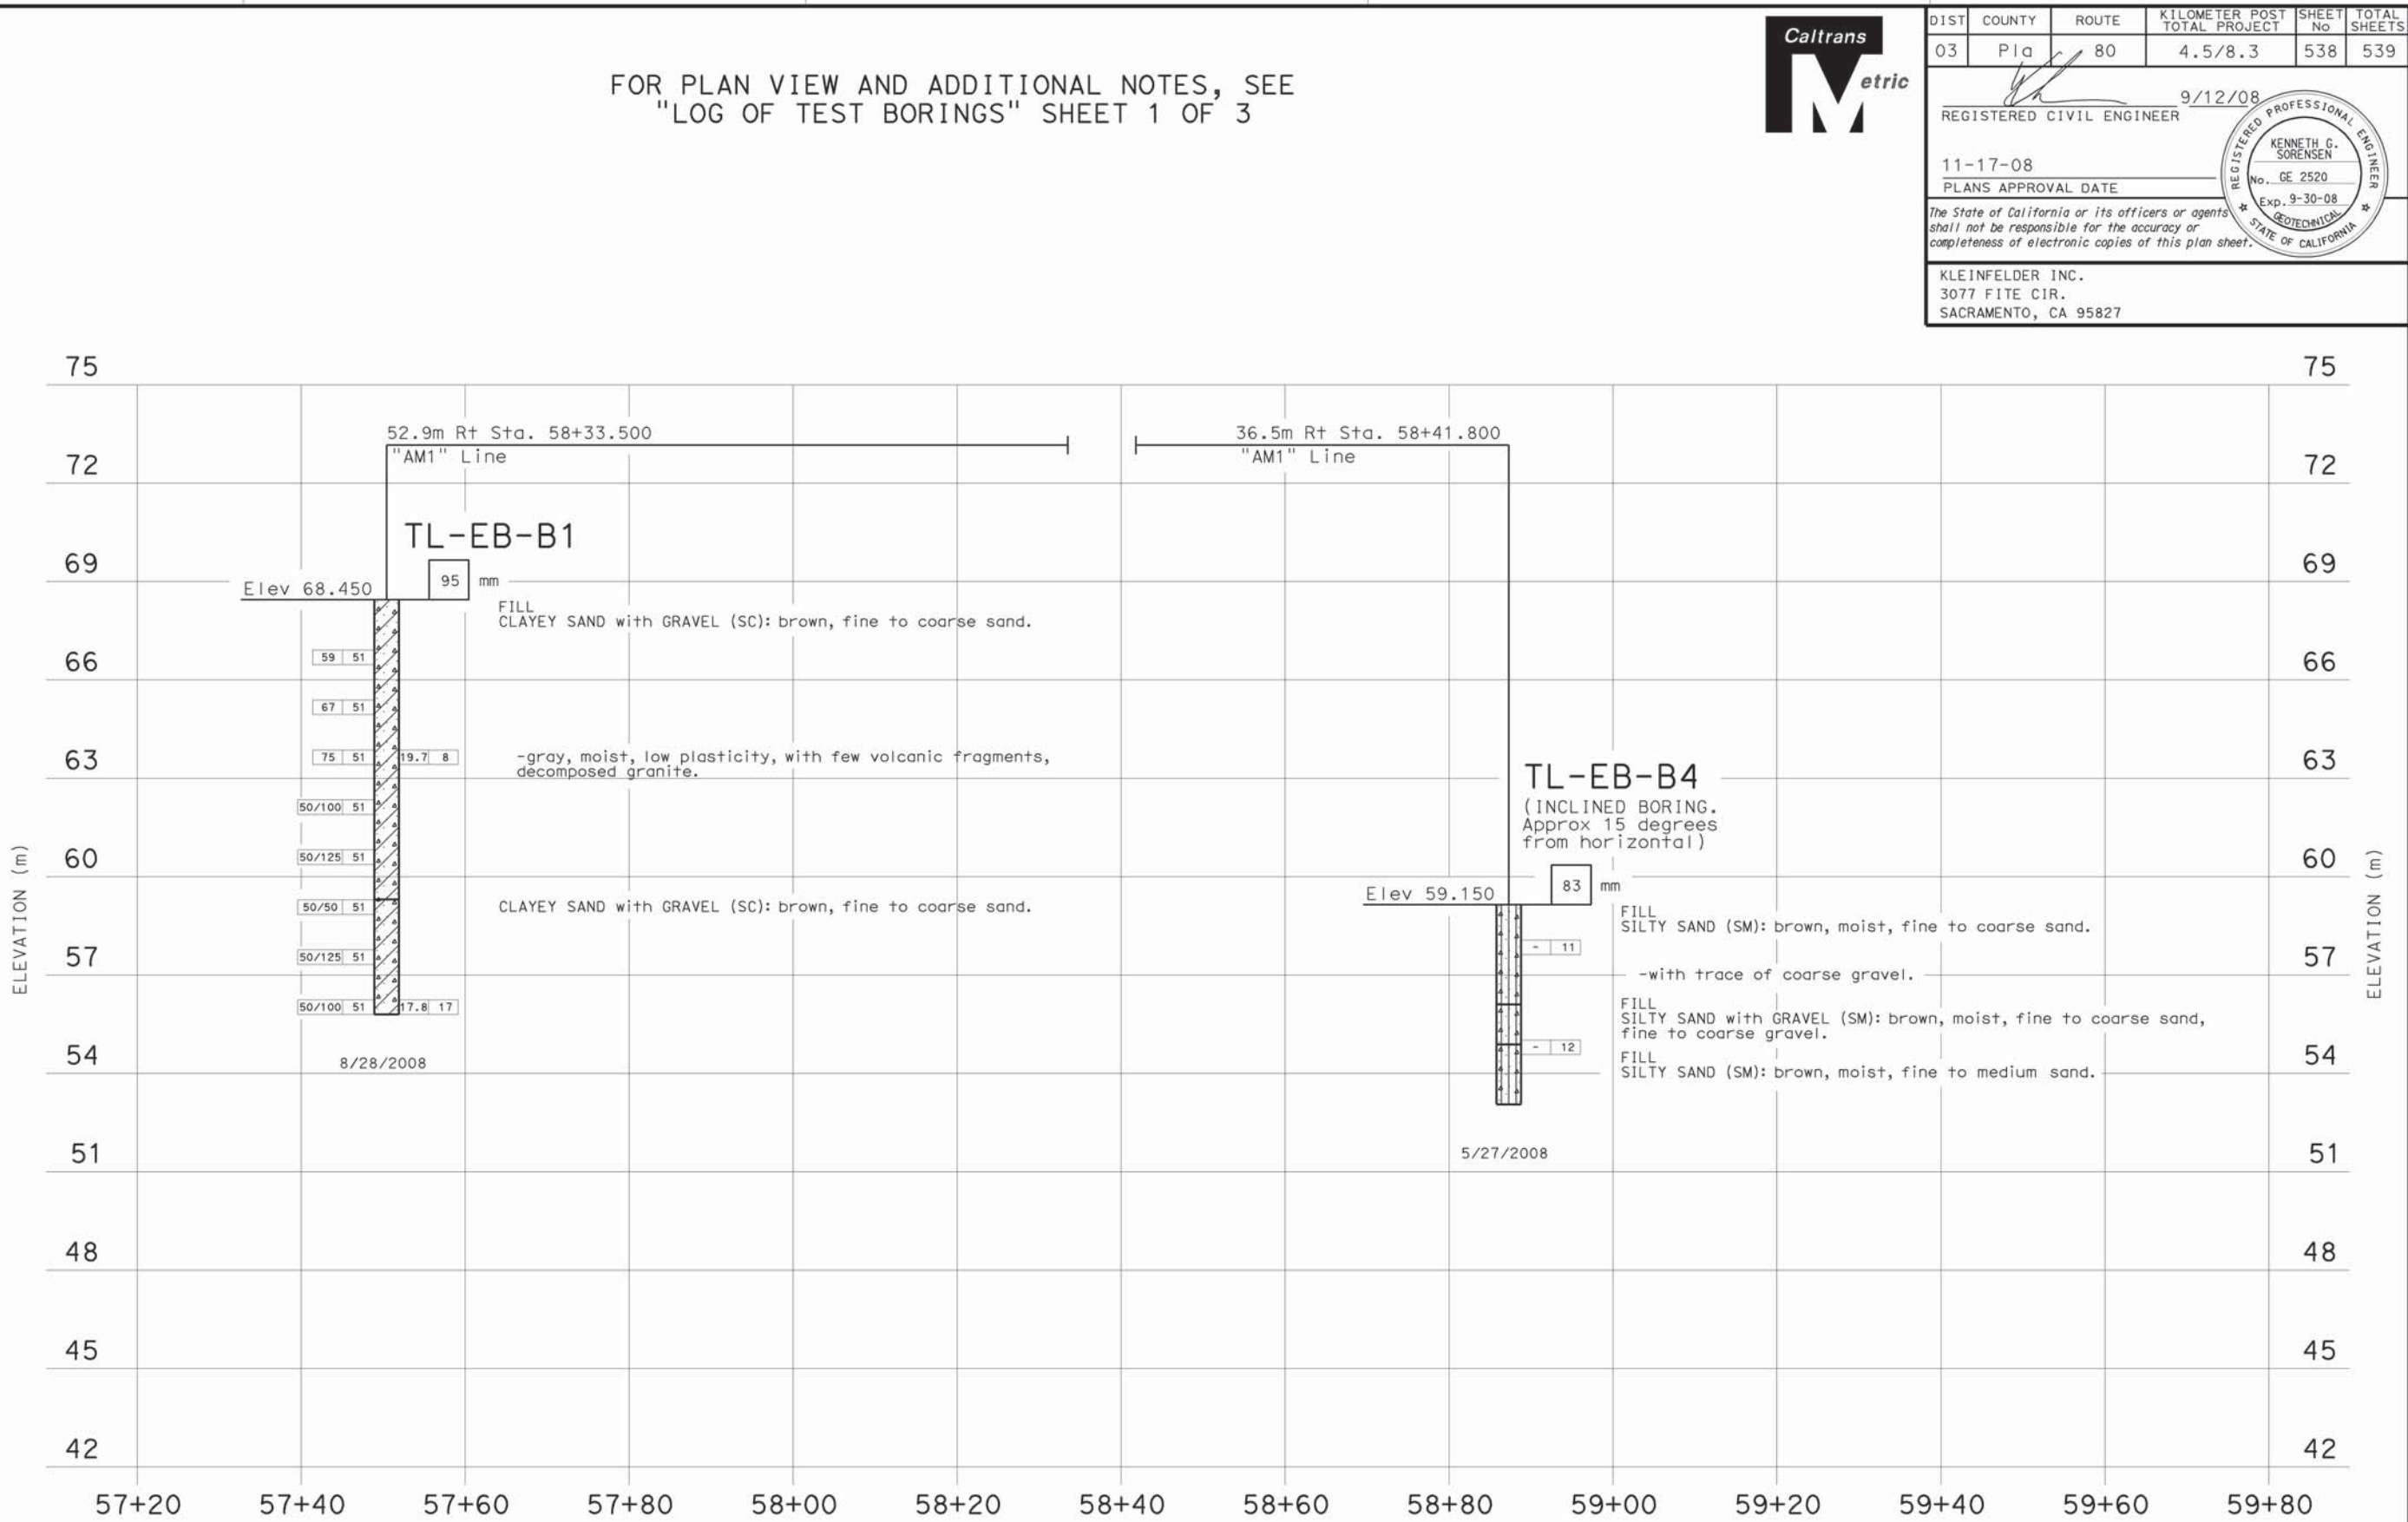

**PROFILE**  
 HOR. 1:400  
 VER. 1:100

Kenneth Sorensen DESIGN OVERSIGHT	DRAWN BY A. Sanchez	G. Zhang FIELD INVESTIGATION BY:	BRIDGE NO. 19E0010	RETAINING WALL - 58E
SIGN OFF DATE	CHECKED BY E. Ortakci	DATE: 01/15/07	PROJECT ENGINEER	LOG OF TEST BORINGS 3 OF 4
PREPARED FOR THE STATE OF CALIFORNIA DEPARTMENT OF TRANSPORTATION			KILOMETER POST 5.9	

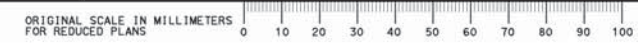

CU 03262  
EA 367831

DISREGARD PRINTS BEARING EARLIER REVISION DATES	REVISION DATES (PRELIMINARY STAGE ONLY)	SHEET 13 OF 14
---	---	----------------


USERNAME = rjferrog DATE PLOTTED = 21-NOV-2008 TIME PLOTTED = 15:53



DIST	COUNTY	ROUTE	KILOMETER POST TOTAL PROJECT	SHEET No	TOTAL SHEETS
03	Pla	80	4.5/8.3	539	539


FOR PLAN VIEW AND ADDITIONAL NOTES, SEE "LOG OF TEST BORINGS" SHEET 1 OF 3

9/12/08  
 REGISTERED CIVIL ENGINEER  
 11-17-08  
 PLANS APPROVAL DATE  
 The State of California or its officers or agents shall not be responsible for the accuracy or completeness of electronic copies of this plan sheet.  
 KLEINFELDER INC.  
 3077 FITE CIR.  
 SACRAMENTO, CA 95827

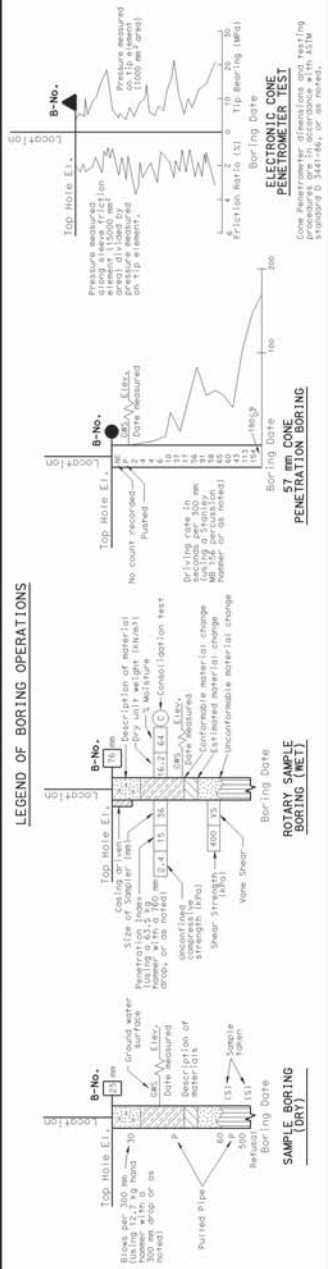

**CONSISTENCY CLASSIFICATION FOR SOILS**

SPT	Flow Value	Consistency
0-4	Very Loose	Very Soft
5-10	Loose	Soft
11-20	Medium Dense	Firm
21-30	Dense	Stiff
31-50	Very Dense	Very Stiff
50		Hard

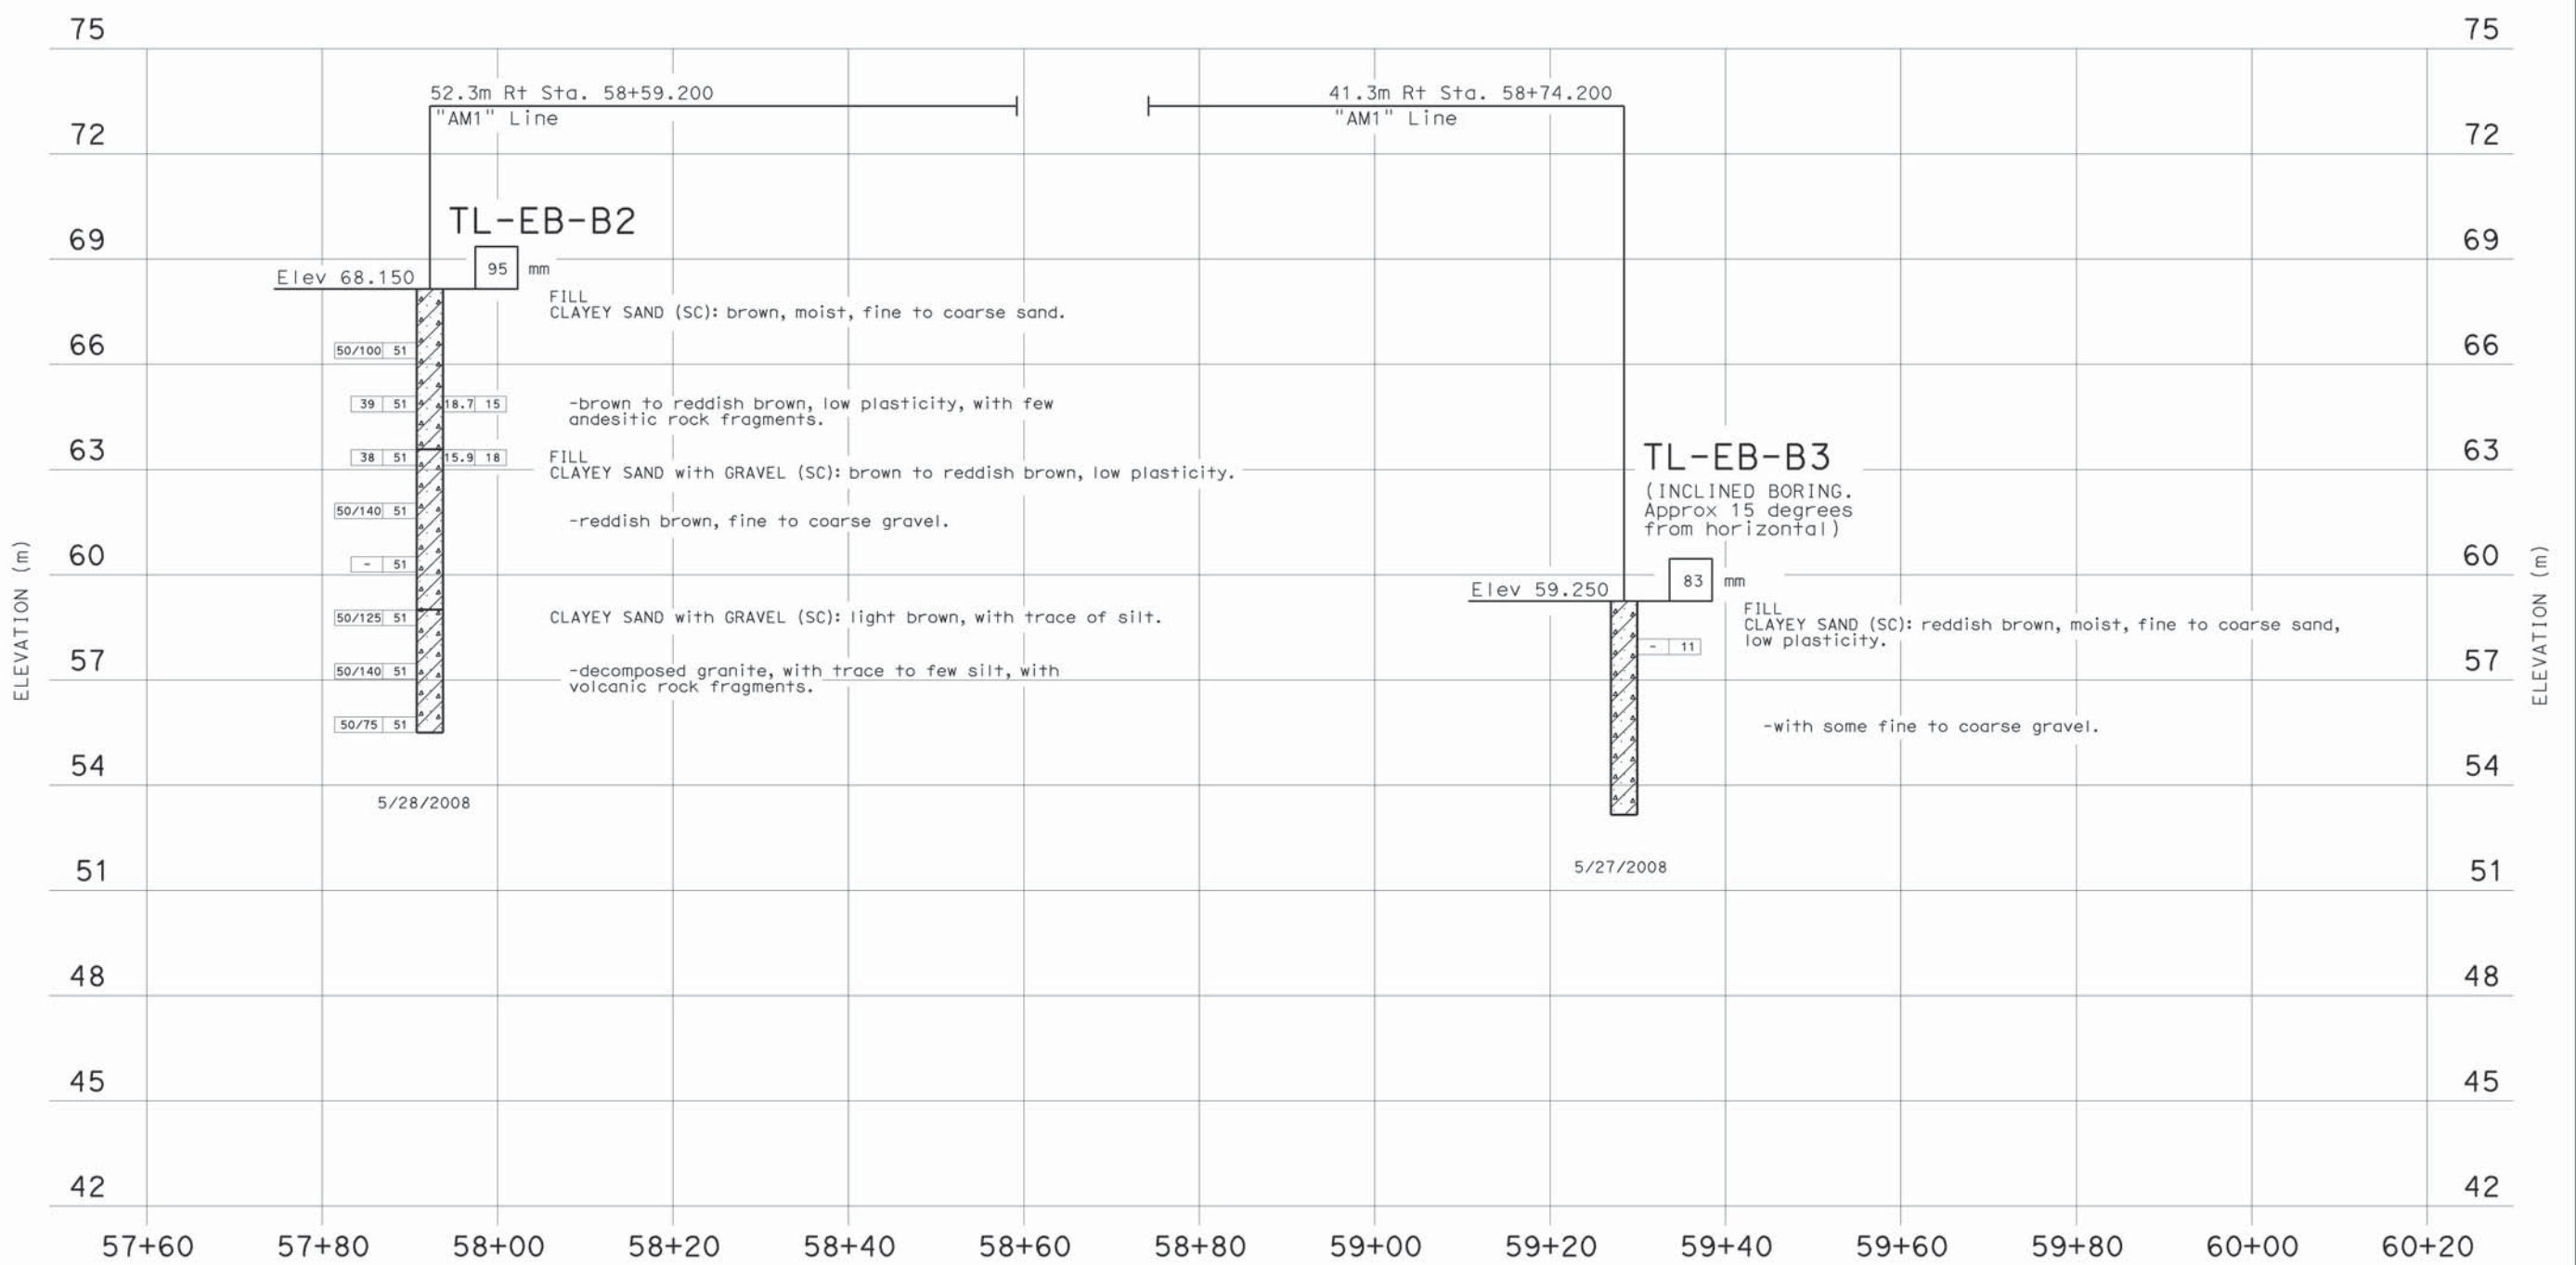

**PROFILE**  
 HOR. 1:400  
 VER. 1:100

Kenneth Sorensen DESIGN OVERSIGHT	DRAWN BY A. Sanchez	G. Zhang FIELD INVESTIGATION BY: DATE: 01/15/07	BRIDGE NO. 19E0010	RETAINING WALL - 58E <b>LOG OF TEST BORINGS 4 OF 4</b>
	CHECKED BY E. Ortakci		PROJECT ENGINEER	





DIST	COUNTY	ROUTE	KILOMETER POST TOTAL PROJECT	SHEET No	TOTAL SHEETS
03	Plq	80	4.5/8.3	494	539

5/28/08  
 REGISTERED CIVIL ENGINEER  
 11-17-08  
 PLANS APPROVAL DATE  
 The State of California or its officers or agents shall not be responsible for the accuracy or completeness of electronic copies of this plan sheet.

KLEINFELDER INC.  
 3077 FITE CIR.  
 SACRAMENTO, CA 95826

Notes:

- 51 mm samples were taken using a California split-barrel sampler with an inside diameter (I.D.) of 51 mm and an outside diameter (O.D.) of 64 mm.
- A safety semi-automatic hammer (63.5 kg) with a 760 mm drop was used to advance the sampler.
- Blowcounts noted for boring are field blowcounts and have not been corrected.
- 35 mm samples were taken using a SPT split-barrel sampler with an inside diameter (I.D.) of 35 mm and an outside diameter (O.D.) of 51 mm.
- 63.5 mm core samples were taken using an HQ core sampler with a 63.5 mm inside diameter (I.D.) and 94 mm outside diameter (O.D.) core barrel.
- Blowcounts 50/125 means 50 blows per 125 mm penetration.
- Groundwater was not encountered at the time of drilling.
- The descriptions and classifications of soil, including consistency and relative density descriptions, used by the field personnel for the exploration bore holes on "Soil and Rock Logging Classification Manual (Field Guide)", Engineering Service Center, Office of Structural Foundations, August 1996.

BENCHMARKS

STATION	OFFSET	N	E	ELEV	DESCRIPTION
15+79.190	4.62 Rt	618564.792	2062442.621	44.552	

SURVEY CONTROL

- Coordinates bearing and distances are based on the California coordinate system of Nad 1983 HPGN, zone 6. (EPOCH 1991.35). Elevations are based on NGVD 29.

LEGEND OF BORING OPERATIONS

Electronic Cone Penetrometer Test: Shows pressure measured on 10 mm diameter tip, blow rate, and penetration rate.

57 mm Cone Penetration Boring: Shows blow rate, penetration rate, and blow count.

Rotary Sample Boring (Wet): Shows casing, sampler, and blow count.


Sample Boring (Dry): Shows casing, sampler, and blow count.

LEGEND OF EARTH MATERIALS

CONSISTENCY CLASSIFICATION FOR SOILS

SPT	Relative Density	Consistency
0-4	Very Loose	Very Soft
5-10	Loose	Soft
11-20	Medium Dense	Firm
31-50	Dense	Stiff
50	Very Dense	Very Stiff
>31		Hard

NOTE: Classification of earth material as shown on this sheet is based upon field inspection and is not to be construed to imply mechanical analysis.

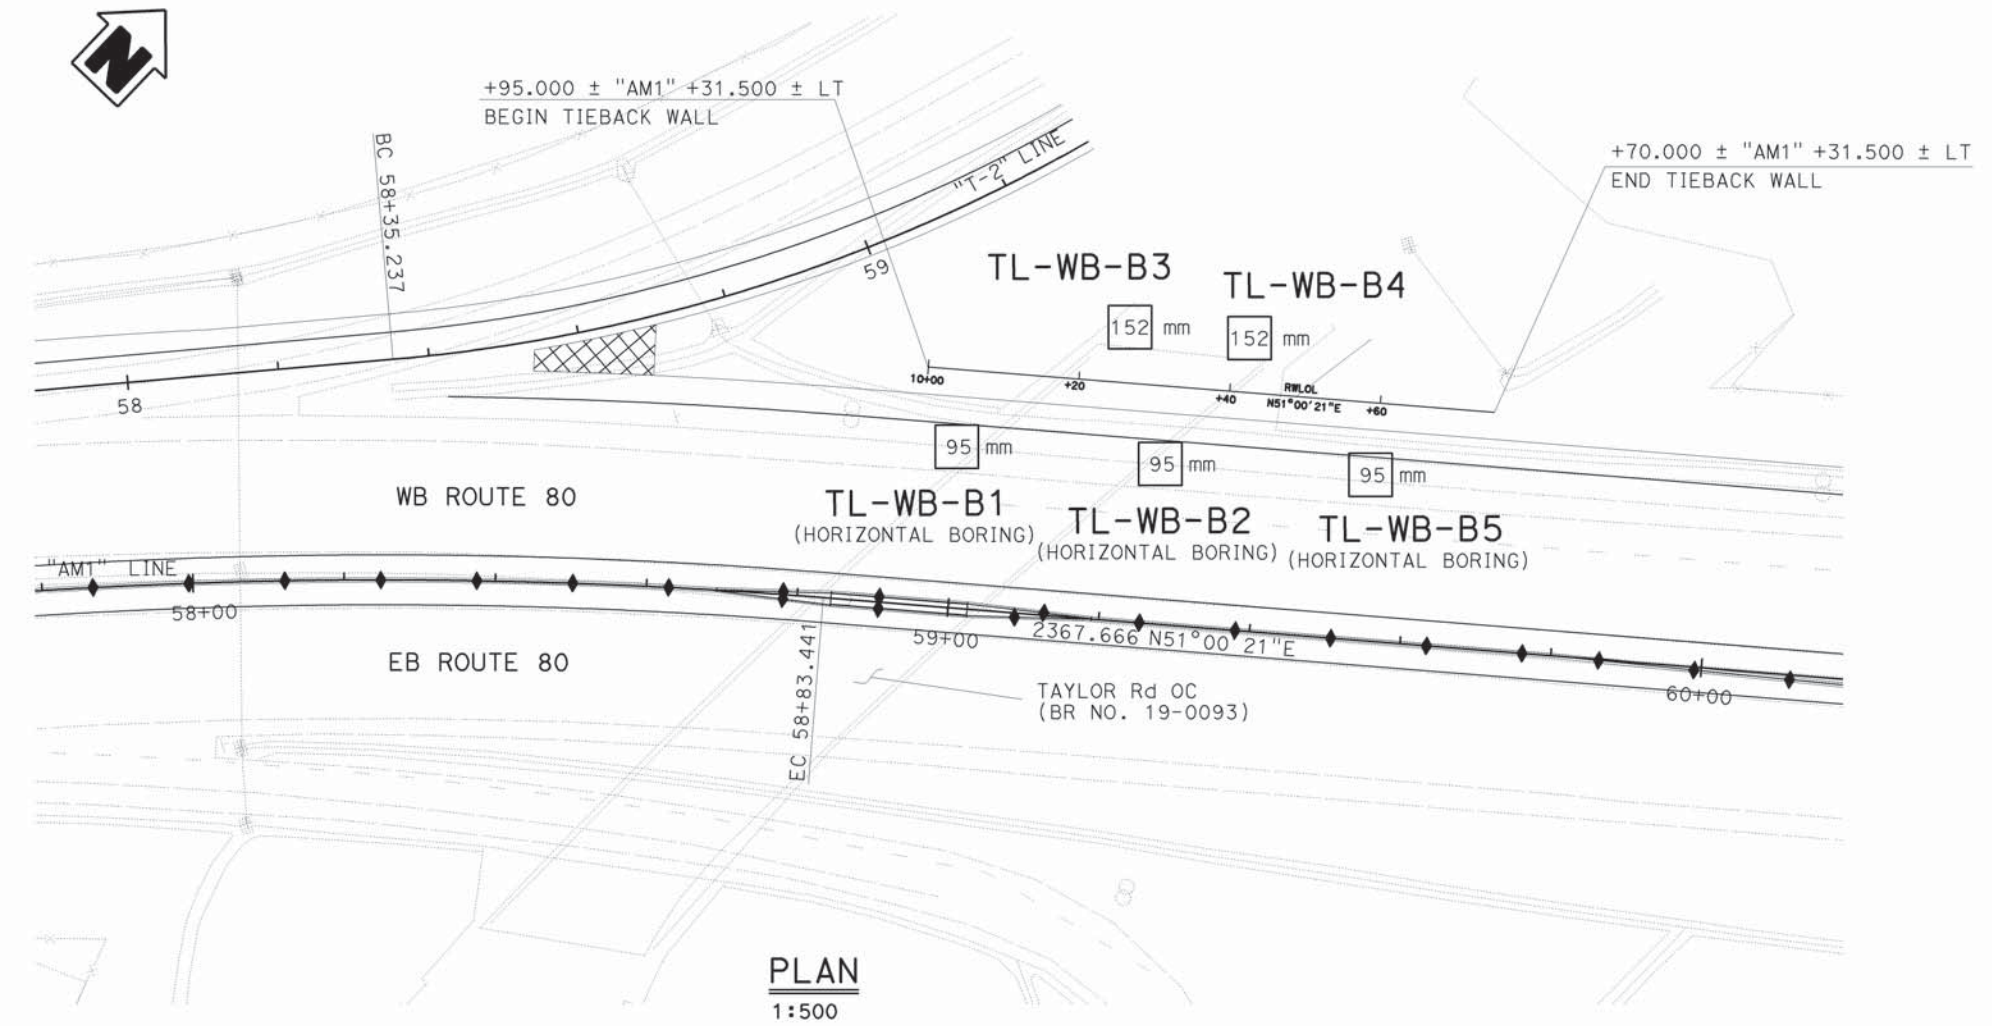

Kenneth Sorensen  
 DESIGN OVERSIGHT  
 05/14/08  
 SIGN OFF DATE

DRAWN BY: A. Sanchez  
 CHECKED BY: S. Ponapalli

Sarat Ponapalli  
 FIELD INVESTIGATION BY:  
 DATE: 03/05/07

PREPARED FOR THE  
 STATE OF CALIFORNIA  
 DEPARTMENT OF TRANSPORTATION

BRIDGE NO. 19E007  
 PROJECT ENGINEER  
 KILOMETER POST 5.9

RETAINING WALL - 59W  
 LOG OF TEST BORINGS 1 OF 4






DIST	COUNTY	ROUTE	KILOMETER POST TOTAL PROJECT	SHEET No	TOTAL SHEETS
03	Plq	80	4.5/8.3	495	539

FOR PLAN VIEW AND ADDITIONAL NOTES, SEE  
"LOG OF TEST BORINGS" SHEET 1 OF 3

5/28/08  
REGISTERED CIVIL ENGINEER  
11-17-08  
PLANS APPROVAL DATE  
The State of California or its officers or agents shall not be responsible for the accuracy or completeness of electronic copies of this plan sheet.

REGISTERED PROFESSIONAL ENGINEER  
KENNETH G. SORENSEN  
No. GE 2520  
Exp. 9-30-08  
STATE OF CALIFORNIA  
GEOTECHNICAL

KLEINFELDER INC.  
3077 FITE CIR.  
SACRAMENTO, CA 95826

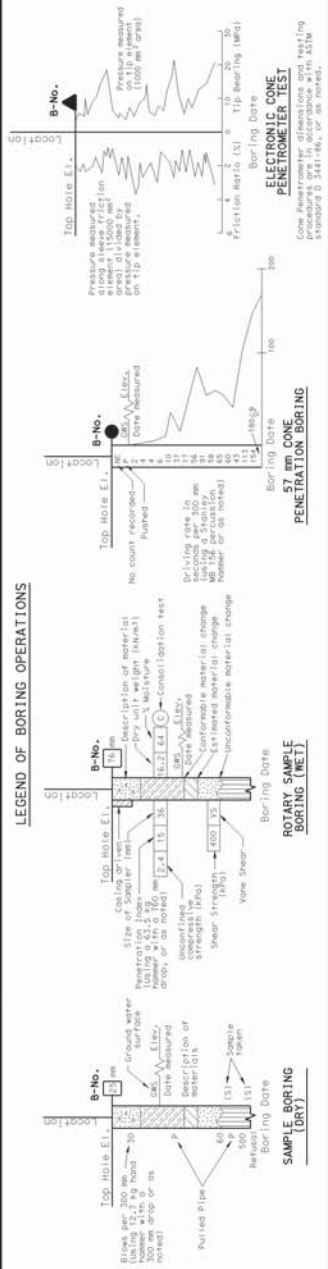


**CONSISTENCY CLASSIFICATION FOR SOILS**

According to the Standard Penetration Test

SPT	Soil	Consistency
0-4	Very Loose	Very Soft
5-10	Loose	Soft
11-20	Medium Dense	Firm
21-30	Dense	Stiff
31-50	Very Dense	Very Stiff
50		Hard

NOTE: Classification of earth material as shown on this sheet is based upon field inspection and is not to be construed to imply mechanical analysis.

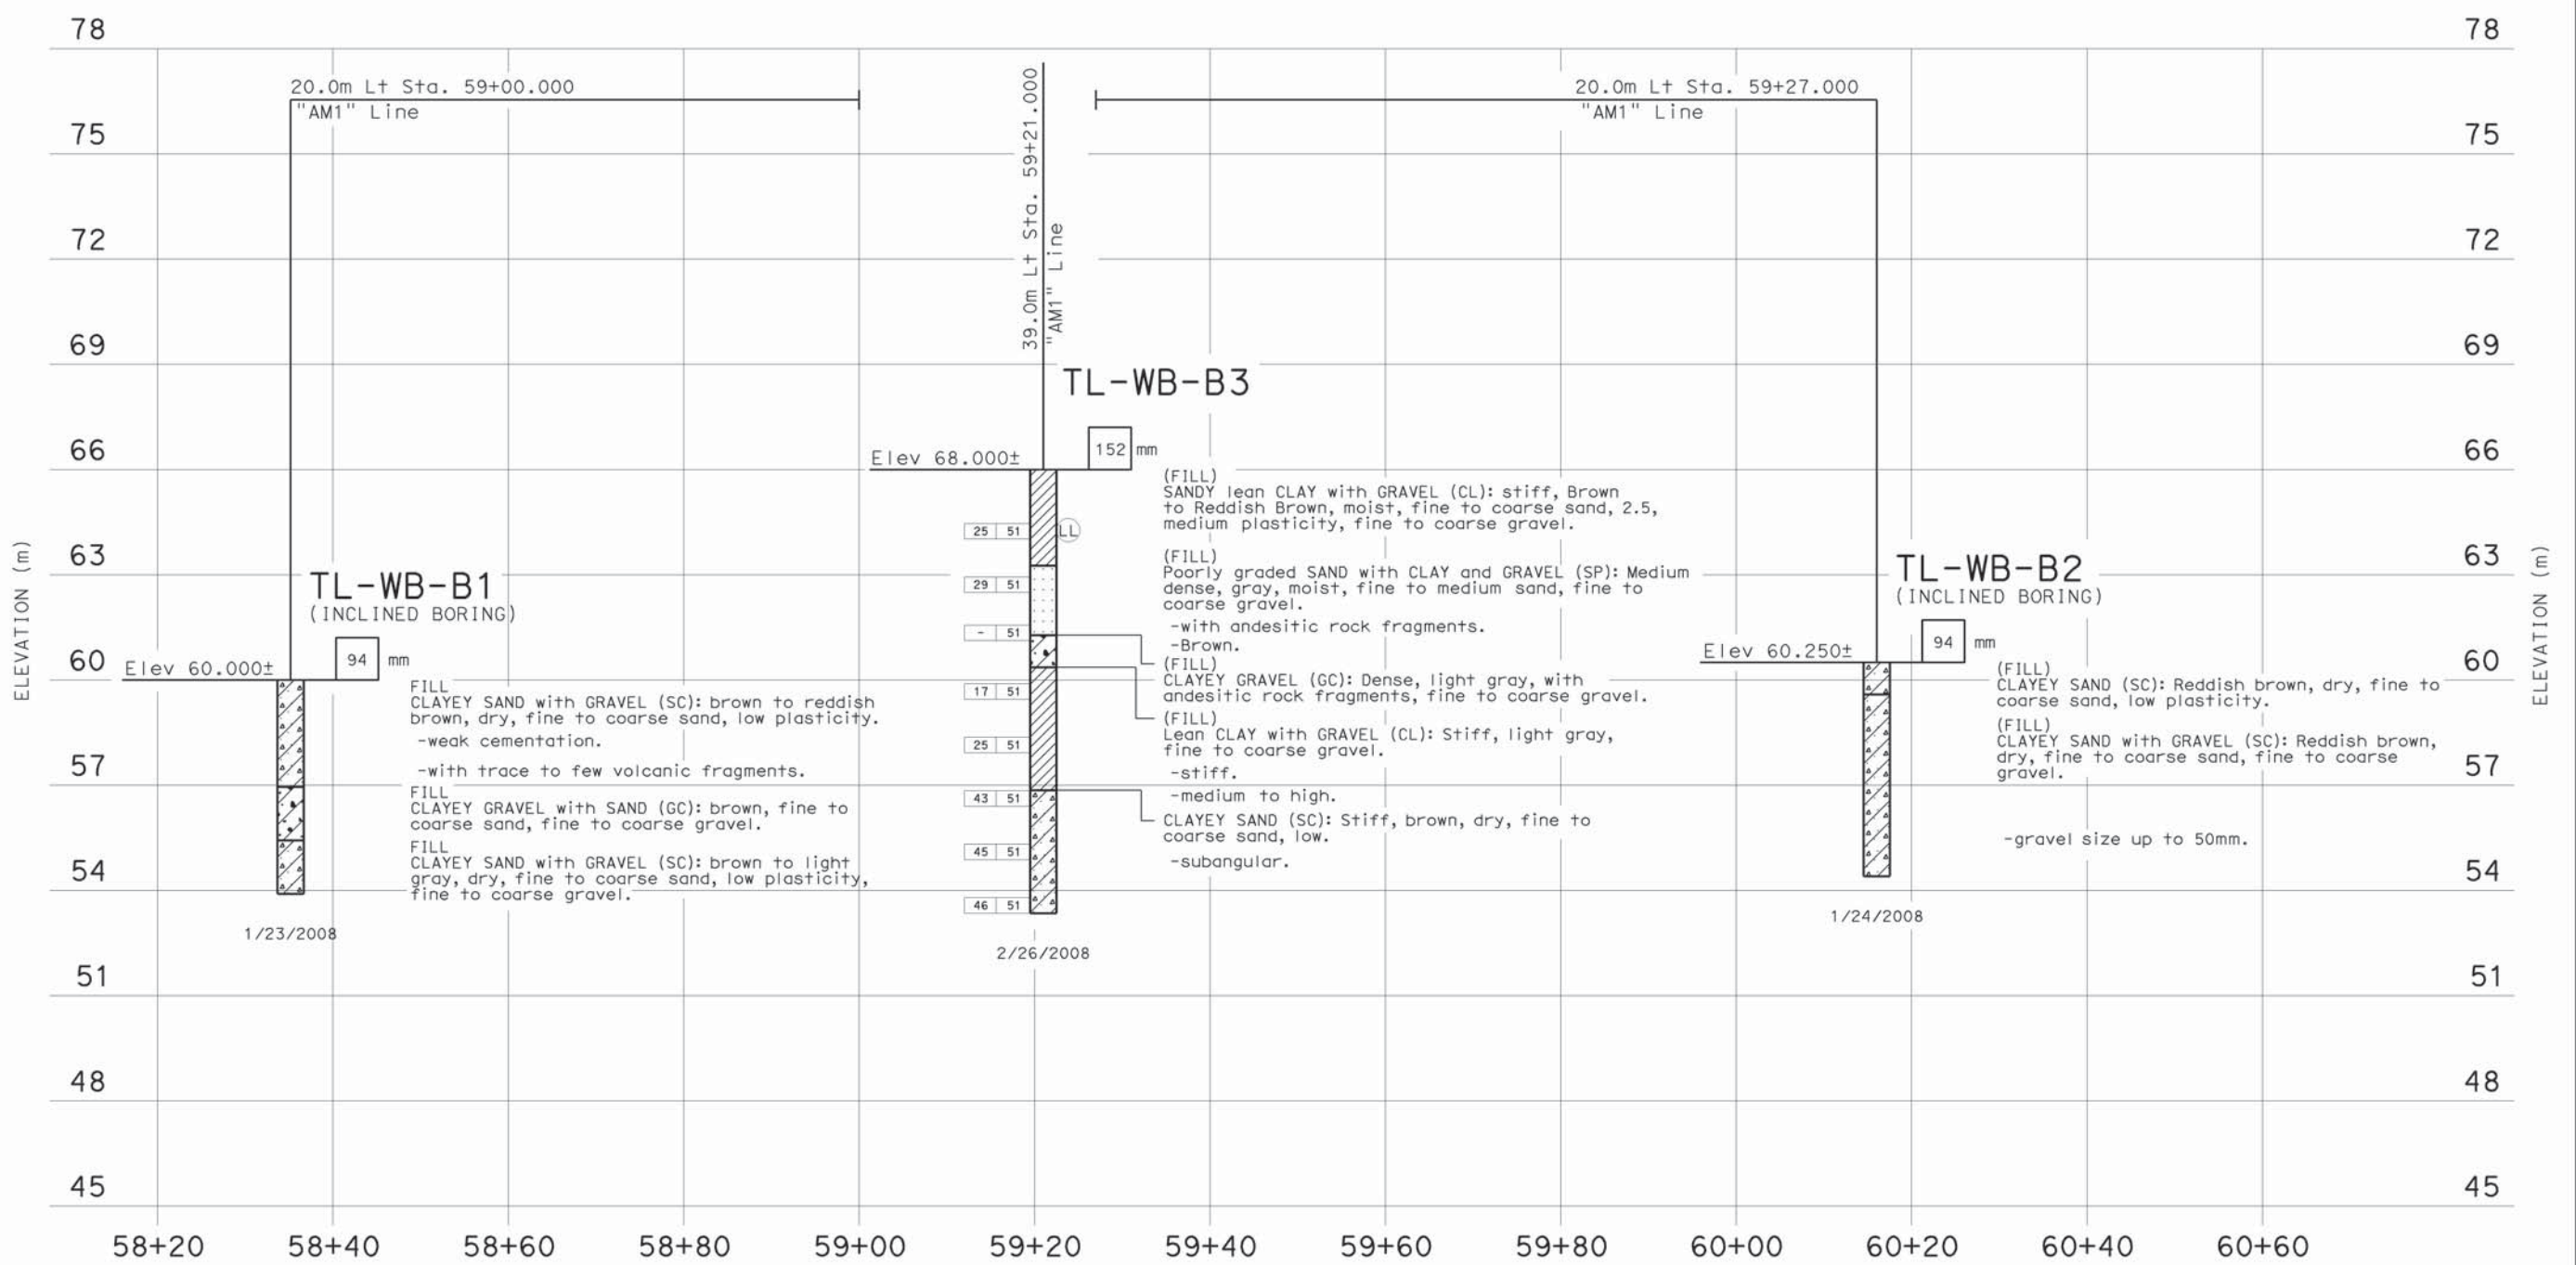


Kenneth Sorensen DESIGN OVERSIGHT 05/14/08 SIGN OFF DATE	DRAWN BY A. Sanchez	Checked BY S. Ponapalli	Sarat Ponapalli FIELD INVESTIGATION BY: DATE: 03/05/07	PREPARED FOR THE STATE OF CALIFORNIA DEPARTMENT OF TRANSPORTATION	BRIDGE NO. 19E0007 KILOMETER POST 5.9	PROJECT ENGINEER	RETAINING WALL - 59W LOG OF TEST BORINGS 2 OF 4
---	------------------------	----------------------------	--	---	--	------------------	--



DIST	COUNTY	ROUTE	KILOMETER POST TOTAL PROJECT	SHEET No	TOTAL SHEETS
03	Pla	80	4.5/8.3	496	539

FOR PLAN VIEW AND ADDITIONAL NOTES, SEE "LOG OF TEST BORINGS" SHEET 1 OF 3

5/28/08  
 REGISTERED CIVIL ENGINEER  
 11-17-08  
 PLANS APPROVAL DATE  
 The State of California or its officers or agents shall not be responsible for the accuracy or completeness of electronic copies of this plan sheet.  
 KLEINFELDER INC.  
 3077 FITE CIR.  
 SACRAMENTO, CA 95826

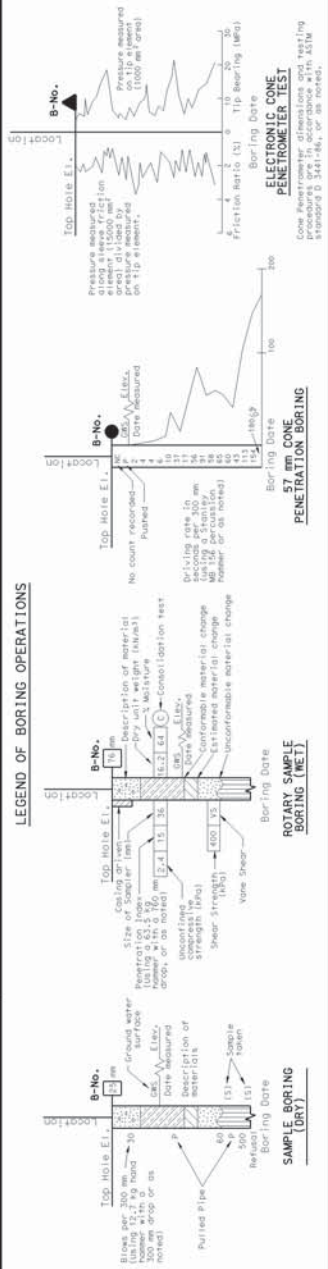


**CONSISTENCY CLASSIFICATION FOR SOILS**

According to the Standard Penetration Test

SPT	Flow Value (0.3m)	Consistency
0-4	Very Loose	Very Soft
5-10	Loose	Soft
11-20	Medium Dense	Firm
21-30	Dense	Stiff
31-50	Very Dense	Very Stiff
50		Hard

NOTE: Classification of earth material as shown on this sheet is based upon field inspection and is not to be construed to imply mechanical analysis.

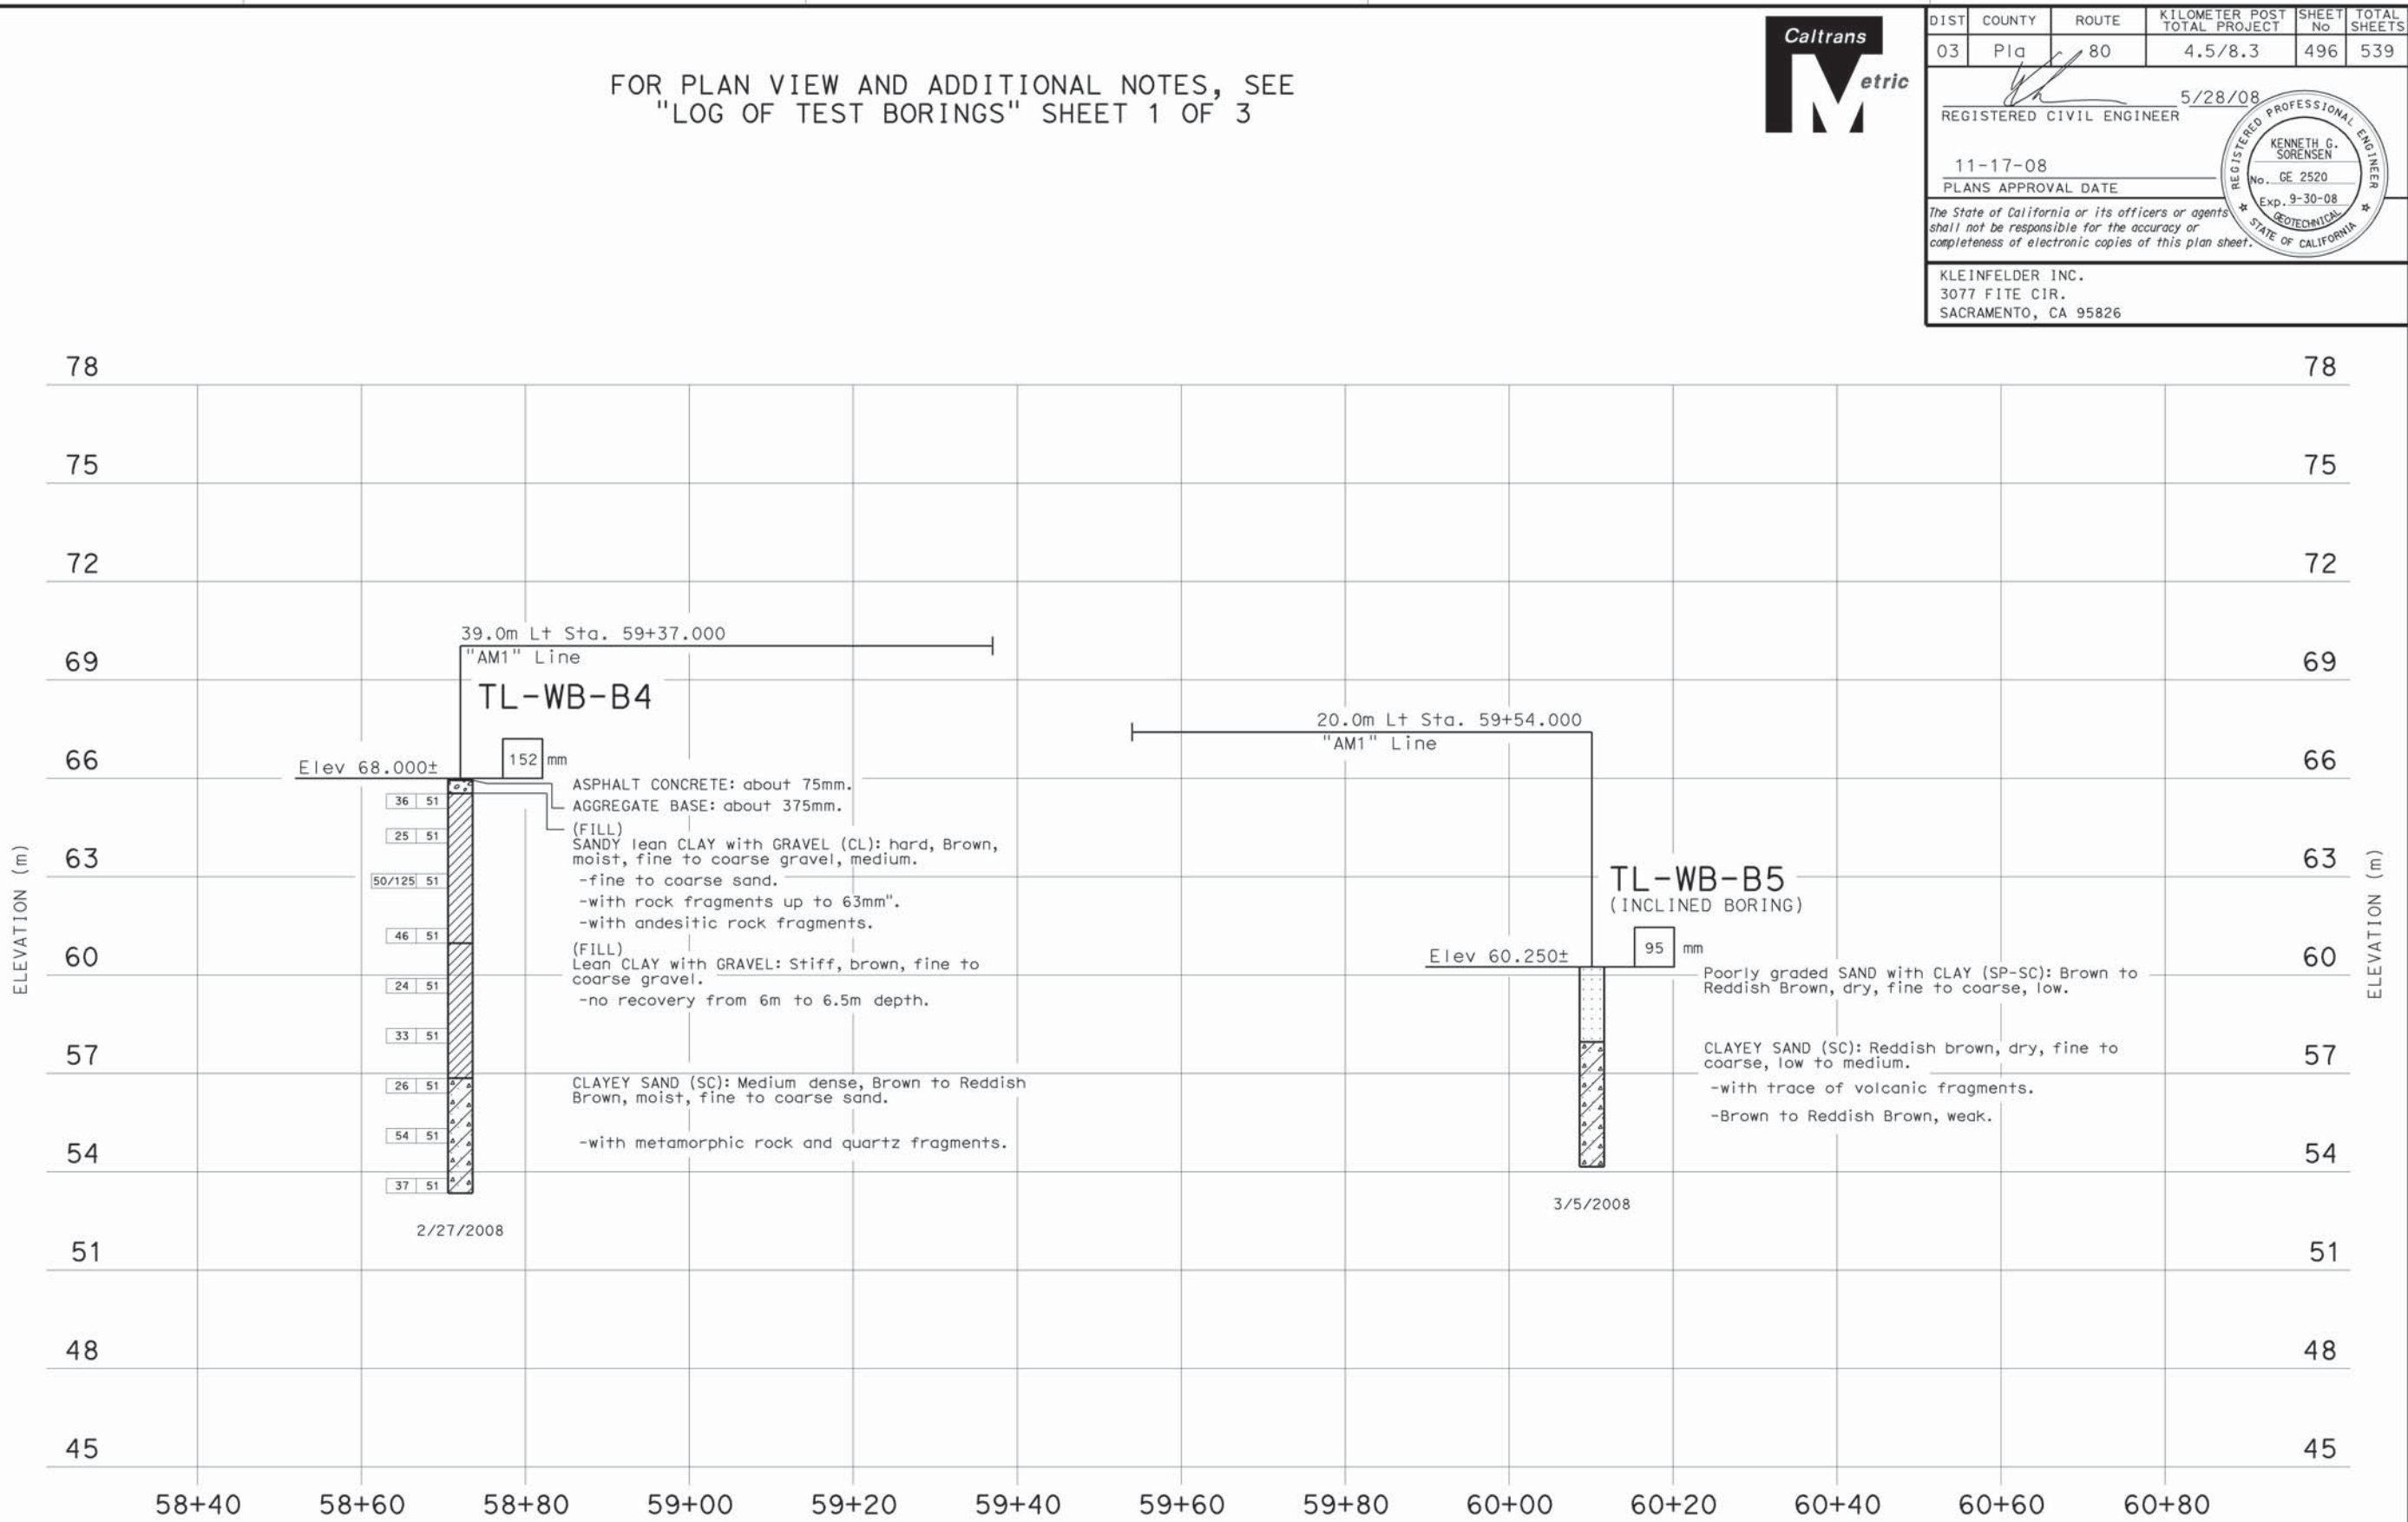

**PROFILE**  
 HOR. 1:400  
 VER. 1:100

Kenneth Sorensen DESIGN OVERSIGHT 05/14/08 SIGN OFF DATE	DRAWN BY A. Sanchez	Sarat Ponapalli FIELD INVESTIGATION BY: DATE: 03/05/07	BRIDGE NO. 19E0007	<b>RETAINING WALL - 59W</b> <b>LOG OF TEST BORINGS 3 OF 4</b>
	CHECKED BY S. Ponapalli	PROJECT ENGINEER	KILOMETER POST 5.9	




DIST	COUNTY	ROUTE	KILOMETER POST TOTAL PROJECT	SHEET No	TOTAL SHEETS
03	Plq	80	4.5/8.3	497	539

5/28/08  
 REGISTERED CIVIL ENGINEER  
 11-17-08  
 PLANS APPROVAL DATE  
 The State of California or its officers or agents shall not be responsible for the accuracy or completeness of electronic copies of this plan sheet.




KLEINFELDER INC.  
 3077 FITE CIR.  
 SACRAMENTO, CA 95826

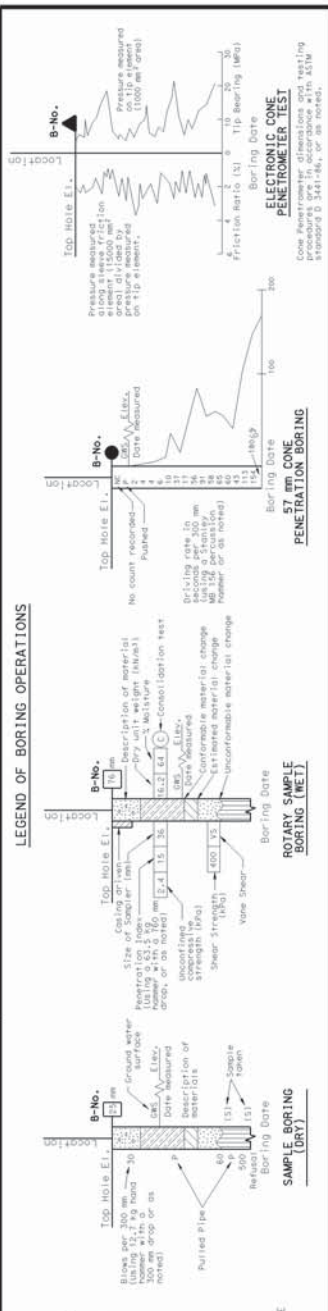


Descriptors		Diagnostic features				Texture and solutioning		General characteristics (strength, excavation, etc.) <sup>§</sup>
Alphanumeric descriptor	Descriptive term	Chemical weathering-Discoloration and/or oxidation	Mechanical weathering-Grain boundary conditions (disaggregation) primarily for granitics and some coarse-grained sediments	Texture	Solutioning	Texture	Solutioning	
W1	Fresh	No discoloration, not oxidized.	No discoloration or oxidation.	No separation, intact (tight).	No change.	No solutioning.	Hammer rings when crystalline rocks are struck. Almost always rock excavation except for naturally weak or weakly cemented rocks such as siltstones or shales.	
W2	Slightly weathered to fresh <sup>o</sup>							
W3	Slightly weathered	Discoloration or oxidation is limited to surface of, or short distance from, fractures; some feldspar crystals are dull.	Minor to complete discoloration or oxidation of most surfaces.	No visible separation, intact (tight).	Preserved.	Minor leaching of some soluble minerals may be noted.	Hammer rings when crystalline rocks are struck. Body of rock not weakened. With few exceptions, such as siltstones or shales, classified as rock excavation.	
W4	Moderately to slightly weathered <sup>o</sup>							
W5	Moderately weathered	Discoloration or oxidation extends from fractures, usually throughout; Fe-Mg minerals are "rusty," feldspar crystals are "cloudy."	All fracture surfaces are discolored or oxidized.	Partial separation of boundaries visible.	Generally preserved.	Soluble minerals may be mostly leached.	Hammer does not ring when rock is struck. Body of rock is slightly weakened. Depending on fracturing, usually is rock excavation except in naturally weak rocks such as siltstones or shales.	
W6	Intensely to moderately weathered <sup>o</sup>							
W7	Intensely weathered	Discoloration or oxidation throughout; all feldspars and Fe-Mg minerals are altered to clay to some extent; or chemical alteration produces in-situ disaggregation, see grain boundary conditions.	All fracture surfaces are discolored or oxidized, surfaces friable.	Partial separation, rock is friable; in semi-arid conditions granitics are disaggregated.	Texture altered by chemical disintegration (hydration, argillation).	Leaching of soluble minerals may be complete.	Dull sound when struck with hammer, usually can be broken with moderate to heavy manual pressure or by light hammer blow without reference to planes of weakness such as incipient or hairline fractures, or veinlets. Rock is significantly weakened. Usually common excavation.	
W8	Very intensely weathered							
W9	Decomposed	Discolored or oxidized throughout, but resistant minerals such as quartz may be unaltered; all feldspars and Fe-Mg minerals are completely altered to clay.		Complete separation of grain boundaries (disaggregated).	Resembles a soil, partial or complete remnant rock structure may be preserved; leaching of soluble minerals usually complete.		Can be granulated by hand, always common excavation. Resistant minerals such as quartz may be present as "stringers" or "dikes."	

Note: This chart and its horizontal categories are more readily applied to rocks with feldspars and mafic minerals. Weathering in various sedimentary rocks, particularly limestones and poorly indurated sediments, will not always fit the categories established. This chart and weathering categories may have to be modified for particular site conditions or alteration such as hydrothermal effects; however, the basic framework and similar descriptors are to be used.  
<sup>o</sup> Combination descriptors are permissible where equal distribution of both weathering characteristics are present over significant intervals or where characteristics present are "in between" the diagnostic feature. However, dual descriptors should not be used where significant, identifiable zones can be delineated. When given as a range, only two adjacent terms may be combined. "Decomposed to slightly weathered," or "moderately weathered to fresh" are not acceptable.  
<sup>1</sup> Does not include diffractonal weathering along shears or faults and their associated features. For example, a shear zone that carried weathering to great depths into a fresh rock mass would not require the rock mass to be classified as weathered.  
<sup>§</sup> These are generalizations and should not be used as diagnostic features for weathering or excavation classification. These characteristics vary to a large extent based on naturally weak materials or cementation and type of excavation.

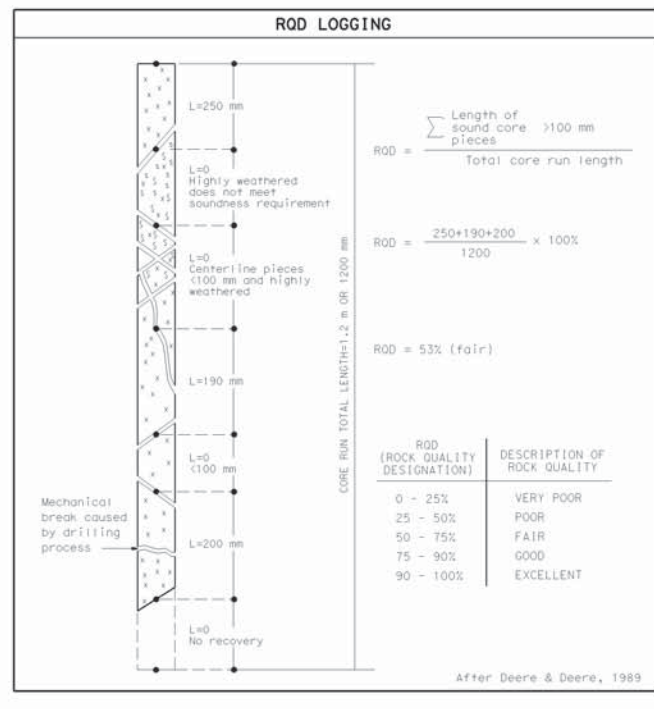

BEDDING, FOLIATION, OR FLOW TEXTURE DESCRIPTORS	
Descriptors	Thickness / Spacing
Massive	Greater than 3 m
Very thickly (bedded, foliated, or banded)	1 to 3 m
Thickly	300 mm to 1 m
Moderately	100 to 300 mm
Thinly	30 to 100 mm
Very thinly	10 to 30 mm
Laminated (intensely foliated or banded)	Less than 10 mm

ROD (ROCK QUALITY DESIGNATION)	DESCRIPTION OF ROCK QUALITY
0 - 25%	VERY POOR
25 - 50%	POOR
50 - 75%	FAIR
75 - 90%	GOOD
90 - 100%	EXCELLENT

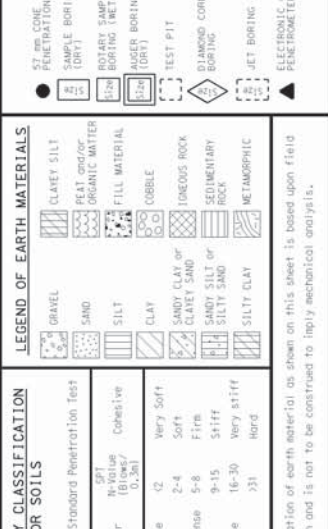

FRACTURE DENSITY	
FRACTURE DENSITY- Based on the spacing of all natural fractures in an exposure or core recovery lengths in boreholes; excludes mechanical breaks, shears, and shear zones; however, shear-distributed zones (fracturing outside the shear) are included. Descriptors for fracture density apply to all rock exposures such as tunnel walls, boiler trenches, outcrops, or foundation cut slopes and inverts, as well as boreholes. Descriptive criteria presented below are based on borehole cores where lengths are measured along the core axis, for other exposures the criteria is distance measured between fractures (size of blocks).	
UNFRACTURED (FD0): No fractures.	
VERY SLIGHTLY FRACTURED (FD1): Core recovered mostly in lengths greater than 1 m.	
SLIGHTLY TO VERY SLIGHTLY FRACTURED (FD2)*	
SLIGHTLY FRACTURED (FD3): Core recovered mostly in lengths from 300 to 1000 mm, with few scattered lengths less than 300 mm or greater than 1000 mm.	
MODERATELY TO SLIGHTLY FRACTURED (FD4)*	
MODERATELY FRACTURED (FD5): Core recovered mostly in 100 to 300 mm lengths with most lengths about 200 mm.	
INTENSELY TO MODERATELY FRACTURED (FD6)*	
INTENSELY FRACTURED (FD7): Lengths average from 30 to 100 mm with scattered fragmented intervals. Core recovered mostly in lengths less than 100 mm.	
VERY INTENSELY TO INTENSELY FRACTURED (FD8)*	
VERY INTENSELY FRACTURED (FD9): Core recovered mostly as chips and fragments with a few scattered short core lengths.	
* Combinations of fracture densities (e.g. very intensely to intensely fractured, or moderately to slightly fractured) are used where equal distribution of both fracture density characteristics are present over a significant interval or exposure, or where characteristics are "in between" the descriptor definitions.	

ROCK HARDNESS/STRENGTH DESCRIPTORS		
Alphanumeric Descriptor	Descriptor	Criteria
H1	Extremely hard	Core, fragment, or exposure cannot be scratched with knife or sharp pick; can only be chipped with repeated heavy hammer blows.
H2	Very hard	Cannot be scratched with knife or sharp pick. Core or fragment breaks with repeated heavy hammer blows.
H3	Hard	Can be scratched with knife or sharp pick with difficulty (heavy pressure). Heavy hammer blow required to break specimen.
H4	Moderately hard	Can be scratched with knife or sharp pick with moderate pressure. Core or fragment breaks with moderate hammer blow.
H5	Moderately soft	Can be grooved 2 mm deep by knife or sharp pick with moderate or heavy pressure. Core or fragment breaks with light hammer blow or heavy manual pressure.
H6	Soft	Can be grooved or gouged easily by knife or sharp pick with light pressure, can be scratched with fingernail. Breaks with light to moderate manual pressure.
H7	Very soft	Can be readily indented, grooved or gouged with fingernail, or carved with a knife. Breaks with light manual pressure.
Any bedrock unit softer than H7, very soft, is to be described using ASTM D-2488 consistency descriptors.		
Note: Although "sharp pick" is included in these definitions, descriptions of ability to be scratched, grooved or gouged by a knife is the preferred criteria. Modified from United States Bureau of Reclamation, Engineering Geology Field manual.		

IN-SITU, LAB & FIELD TEST DESIGNATIONS

- (AL) ATTERBERG LIMITS
- (CA) CHEMICAL ANALYSIS
- (CN) CONSOLIDATION
- (CU) CONSOLIDATED UNDRAINED TRIAXIAL
- (DS) DIRECT SHEAR
- (MD) MAX. DRY DENSITY
- (PP) POCKET PENETROMETER
- (SA) SIEVE ANALYSIS
- (TV) TORVANE
- (UC) UNCONFINED COMPRESSION
- (UU) UNCONSOLIDATED UNDRAINED TRIAXIAL
- (VS) VANE SHEAR

Kenneth Sorensen DESIGN OVERSIGHT 05/14/08 SIGN OFF DATE	DRAWN BY A. Sanchez	Sarat Ponapalli FIELD INVESTIGATION BY: DATE: 03/05/07	BRIDGE NO. 19E007	RETAINING WALL - 59W LOG OF TEST BORINGS 4 OF 4
	CHECKED BY S. Ponapalli	PROJECT ENGINEER	KILOMETER POST 5.9	

## **APPENDIX B**

### Caltrans Comments and BCI Response



## **Structures Preliminary Geotechnical Report**

### **Interstate 80/State Route 65**

### **Interchange Improvement Project**

**Prepared by BLACKBURN CONSULTING, Auburn, California for CH2M Hill**

**September 2014**

#### **Page 6 - Section 6.2 Faulting**

Seismic related information including faults, distance to seismic sources, PGA, PBA, as well as ARS curves for both Probabilistic Seismic Hazard Analysis and Deterministic Seismic Hazard Analysis have been updated with the latest Caltrans On-line V2.3.06. All references to PGA (Merriam and Shantz, 2007) shall be modified and the data from the latest version shall be used and referenced in all future submittals.

#### **Pages 6 and 7 - Section 6.3 Subsurface Soil and Rock**

Several "General Soil and Rock Conditions" are outlined for each of the 6 general project areas, yet a single Acceleration Response Spectrum curve using a  $V_{s30}=560$  m/s is used to represent the entire project area. The LOTBs on pages 33 through 83 of the report indicate a wide range of geological formations through the project which will yield different  $V_{s30}$ s. For the next phase of design, separate seismic analysis and ARS curves shall be submitted for each separate structure based on site specific  $V_{s30}$ s.

#### **Page 8 - Section 7.1 Geologic Hazards**

The third line indicates that "There is a potential for weak claystones to occur near the base of the Mehrten Formation... the claystone can impact slope stability and design parameters for new structures". However, Section 7.2.5 Seismic Slope Stability states that potential for seismic slope instability within the project area is very low. Please clarify whether or not this may be an issue.

#### **Page 9 - Table 3**

- Please use "Maximum Magnitude" instead of "Maximum Moment Magnitude".

-Please specify what  $R_{RUP}$  represents.

-Need to specify that the Peak Ground Acceleration (PGA) is based on the minimum Deterministic Spectrum.

**Pages 11, 12, 13** I reviewed Table 4 and for the time being have not further comments.

**Page 31 - Preliminary ARS**

The recommended ARS curve shown is incorrect. A composite curve using the minimum deterministic spectrum for periods between 0 to about 0.7 seconds and probabilistic spectrum for periods between 0.7 and 5 seconds should have been used. Figure 6 only shows the deterministic curve.

**General Comments**

Please note that the current Caltrans Seismic Design Criteria (SDC) have been updated, and the foundation design procedures are currently being updated. It is the responsibility of the consultant to make sure the procedures/methods used for foundation related design are the most current.

## **BCI Response to Caltrans Comments**

### **Comment on Page 6 - Section 6.2 Faulting**

Seismic related information is referenced to the latest Caltrans ARS Online V2.3.06.

### **Comment on Pages 6 and 7 - Section 6.3 Subsurface Soil and Rock**

Acknowledged and comment included in the SPGR that for the next phase of design, separate seismic analysis and ARS curves shall be submitted for each separate structure based on site specific Vs30's.

### **Comment on Page 8 - Section 7.1 Geologic Hazards**

We provide clarification in Section 7.2.5 "Seismic Slope Stability" that possible claystones near the base of the Mehrten Formation can impact slope stability.

### **Comment on Page 9 - Table 3**

- Changed "Maximum Moment Magnitude" to "Maximum Magnitude".
- Included definition of  $R_{RUP}$  as the closest distance to the fault rupture plane (as defined in Caltrans' "Methodology for Developing Design Response Spectrum for Use in Seismic Design Recommendations," Appendix B, November 2012).
- Included a note that the Peak Ground Acceleration (PGA) is based on the Minimum Deterministic Spectrum.

### **Comment on Page 31 - Preliminary ARS**

The recommended ARS curve shown is correct. The curve shown in Figure 6 is a composite curve (envelope) that uses the minimum deterministic spectrum for periods between 0 to about 0.75 seconds and probabilistic spectrum for periods between 0.75 and 5 seconds.

The apparent discrepancy appears to be that the probabilistic spectrum we use is based on a deaggregated event distance of 73.2 km rather than the default minimum deterministic distance (in accordance with Section 6 of Caltrans' "Methodology for Developing Design Response Spectrum for Use in Seismic Design Recommendations" (November 2012)). This results in less deviation of the probabilistic curve from the minimum deterministic curve. We provide tabled spectrum data in Figure 6b for clarification of values used.

### **General Comments**

We acknowledge that the current Caltrans Seismic Design Criteria (SDC) have been updated, and the foundation design procedures are currently being updated, and that it is the responsibility of the consultant to make sure the procedures/methods used for foundation related design are the most current.